




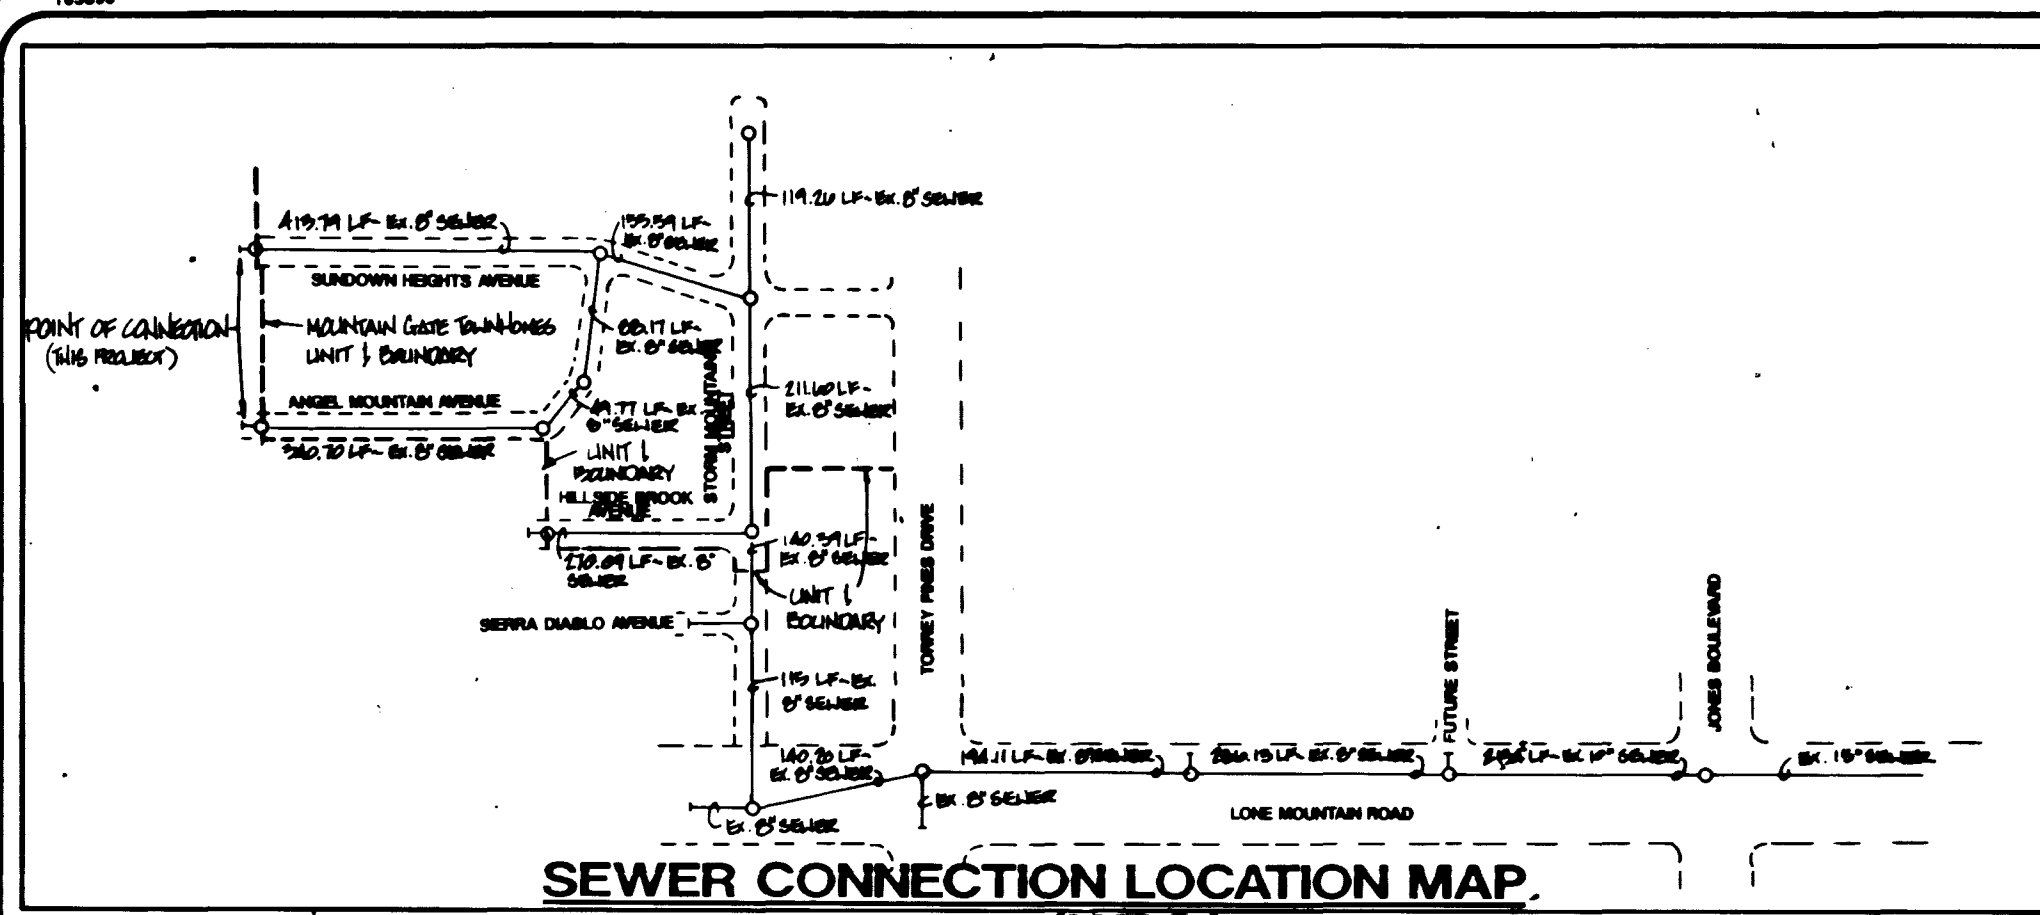


SEWER LATERAL "AS-BUILT" CERTIFICATION

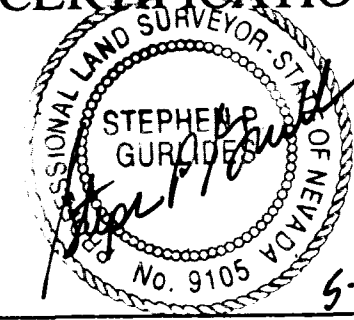


STEPHEN P. GURLIDES, P.L.S.
NEVADA CERT. NO.: 9105

GRAPHIC SCALE

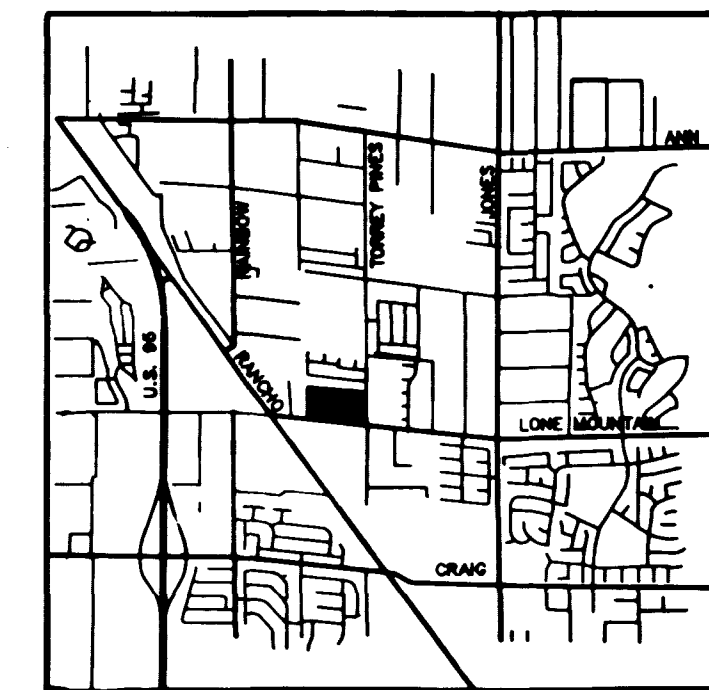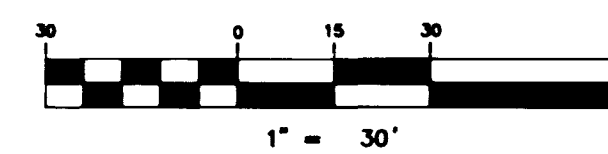



LOCATION MAP

EXIST. NORTHSTAR ESTATES UNIT 3

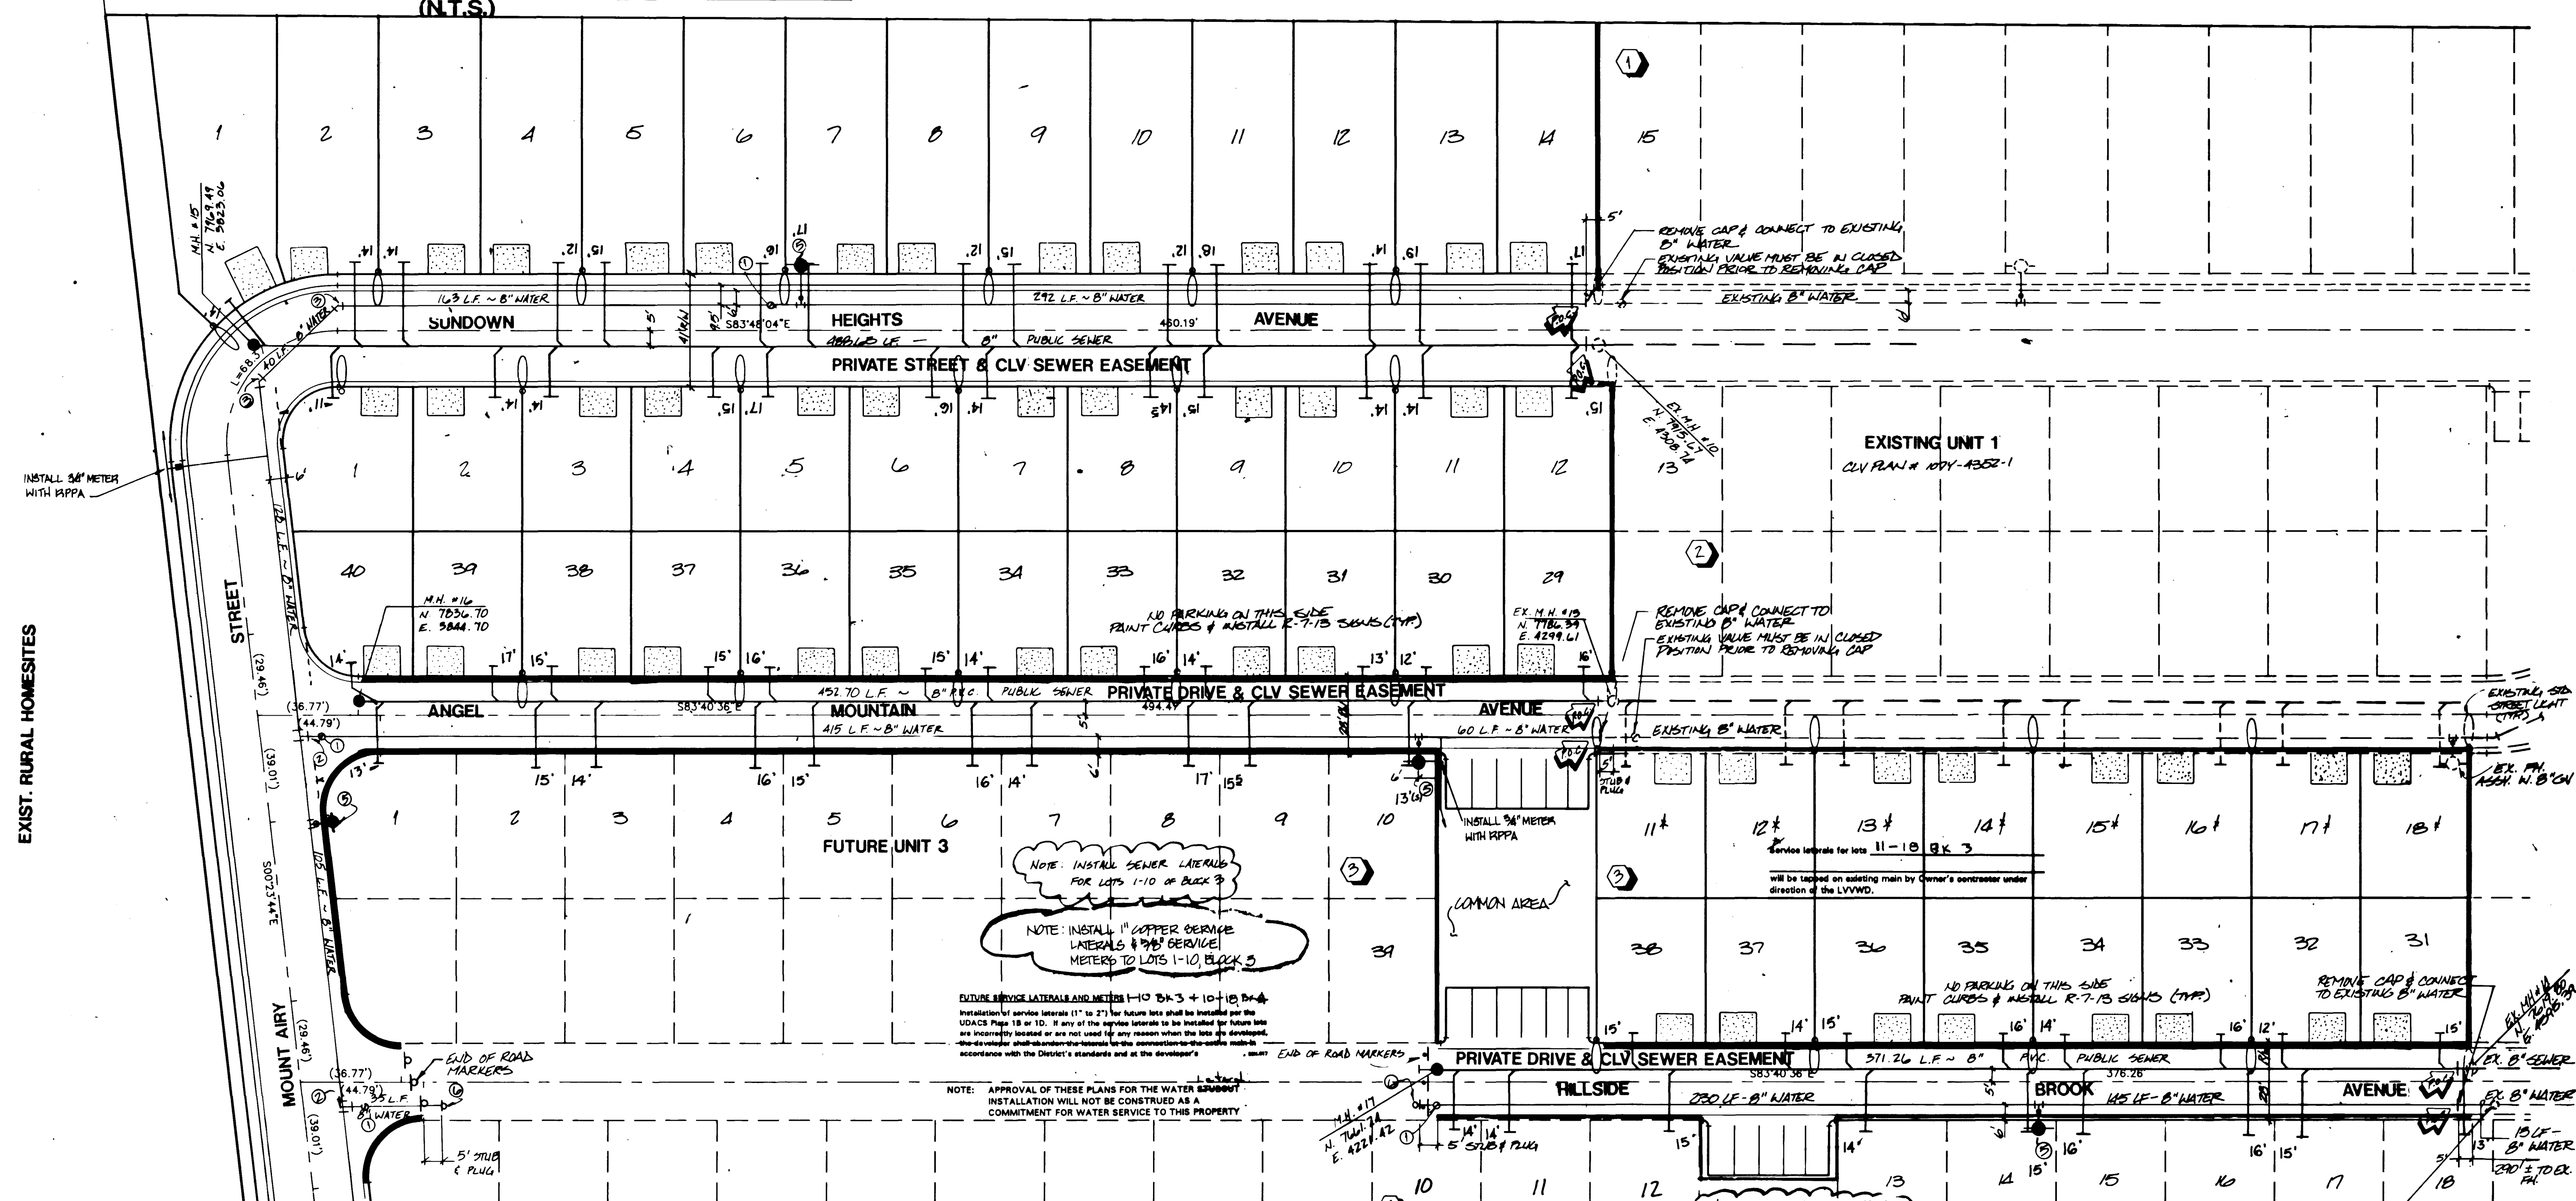

CLV BM 2300-2800
RIVET AND PLATE IN TOP OF CURB, LONE MOUNTAIN ROAD,
550' EAST OF RANCHO ROAD, SOUTH CURB LINE.
ELEVATION: 2314.32 NAD 88
BENCHMARK
BM # 0000 2N1W6
RIVET AND ALUMINUM PLATE IN TOP OF CURB.
SOUTHEAST CORNER OF RANCHO RD.
MOUNTAIN RD. NEAR THE PC OF RANCHO RD.
ELEVATION = 2319.40

2 working days
Call
before you
Dig
1-800-227-2800

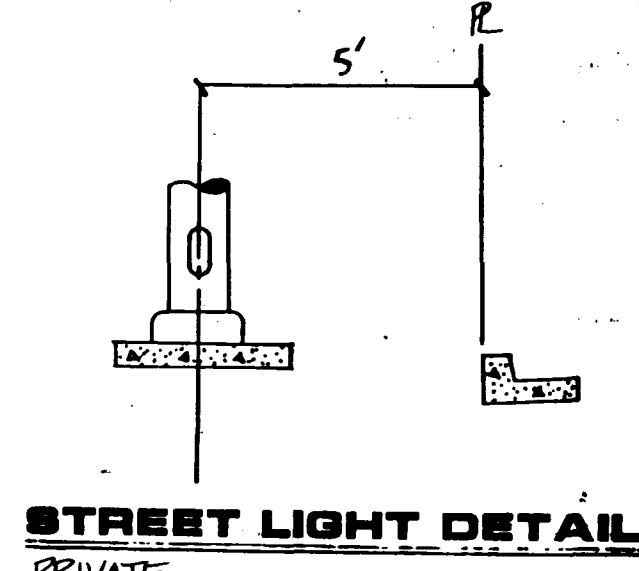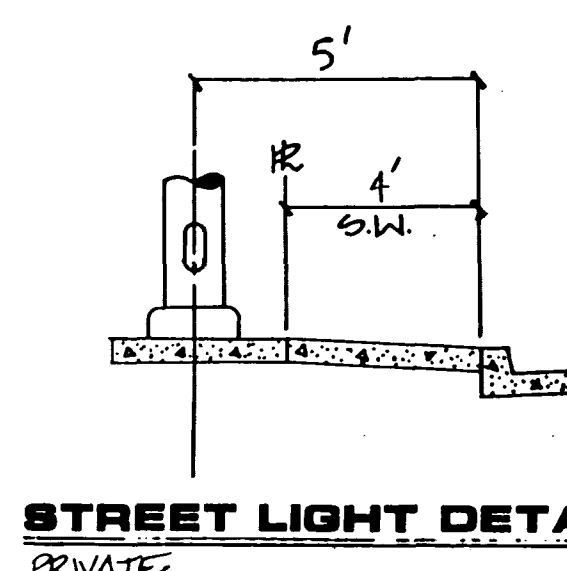

SEWER CONTRIBUTION
PEAK = 0.0031 MGD
AVG. = 0.0015 MGD

PROJECT NAME: MOUNTAIN GATE TOWNHOMES UNIT 2
This project water plan complies with the Las Vegas Valley Water District's technical requirements. However, this water plan is NOT APPROVED FOR CONSTRUCTION at this time and this signature does not provide or imply a water commitment.

APPROVAL:
LAS VEGAS VALLEY WATER DISTRICT
DATE: 9/06/95
CITY OF LAS VEGAS FIRE MARSHALL
DATE: 6/13/95
NEVADA POWER COMPANY
DATE: 6/13/95
NEVADA POWER COMPANY APPROVAL IS ONLY FOR THE PLACEMENT AND CLEARANCE OF STREET LIGHT AND SIGNAL LIGHT INSTALLATION.

AMLAND DEVELOPMENT, INC.
CITY OF LAS VEGAS, NEVADA

SEWER AS-BUILT

MOUNTAIN GATE TOWNHOMES UNIT 2

CONSULTING ENGINEERS • PLANNERS • LAND SURVEYORS
2727 SOUTH RAINBOW BOULEVARD
LAS VEGAS, NEVADA 89102-5148 PHONE (702) 873-7550 FAX (702) 362-2597

DATE: 6-13-95
BY: DT
SCALE: 1"=30'
SHEET: 4 of 8

