


# WATER & SEWER AS-BUILTS

| SEWER QUANTITIES                          |            |
|---|------------|
| 8" SEWER (PUBLIC) : MATERIAL SD-R35       | 484 L.F.   |
| 8" SEWER (PRIVATE) : MATERIAL SD-R35      | 2,538 L.F. |
| 48" MANHOLE (PUBLIC)                      | 6 EACH     |
| 48" MANHOLE (PRIVATE)                     | 10 EACH    |
| SEWER SERVICE (PUBLIC) : MATERIAL SD-R35  | 17 EACH    |
| SEWER SERVICE (PRIVATE) : MATERIAL SD-R35 | 73 EACH    |
| MANUFACTURER OF SD-R35 1/4" PIPE          |            |

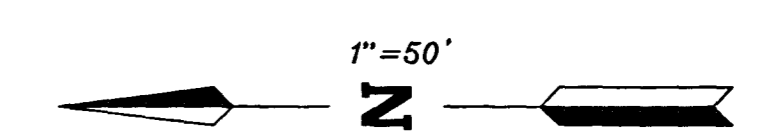

**NOTICE!**  
 EXISTING UTILITIES ARE SHOWN ON PLANS FOR THE CONVENIENCE OF THE CONTRACTOR ONLY. THE CONTRACTOR IS RESPONSIBLE FOR THE PROTECTION OF ALL UTILITIES. THE ENGINEER BEARS NO RESPONSIBILITY FOR UTILITIES NOT SHOWN OR SHOWN INCORRECTLY.

**Call BEFORE YOU Dig**  
 1-800-227-2600  
(LIMITED SERVICE ONLY)

|   |   |          |          |    |          |  |  |  |  |
|---|---|----------|----------|----|----------|--|--|--|--|
| <p style="text-align: center;"><b>ALPHA &amp; ENGINEERING COMPANY</b></p> <p style="font-size: small; text-align: center;">                 2000 N. 10th Street, Suite 100<br/>                 Phoenix, AZ 85016<br/>                 Phone: (602) 998-1111             </p> | <table border="1" style="width: 100%; border-collapse: collapse;"> <tr> <td style="width: 20%;">REVISION</td> <td style="width: 20%;">DATE</td> <td style="width: 20%;">BY</td> <td style="width: 40%;">APPROVED</td> </tr> <tr> <td> </td> <td> </td> <td> </td> <td> </td> </tr> </table> | REVISION | DATE     | BY | APPROVED |  |  |  |  |
| REVISION  | DATE  | BY       | APPROVED |    |          |  |  |  |  |
|   |   |          |          |    |          |  |  |  |  |
| <p><b>WATER &amp; SEWER AS-BUILTS</b></p> <p><b>NORTHSHORE REFLECTIONS</b></p>  |   |          |          |    |          |  |  |  |  |
| <p>TITLE</p>  |   |          |          |    |          |  |  |  |  |
| <p>PROJECT</p>  |   |          |          |    |          |  |  |  |  |
| <p>JOB # N4-76-16</p>   |   |          |          |    |          |  |  |  |  |
| <p>NAME JOHNSON</p>   |   |          |          |    |          |  |  |  |  |
| <p>DATE 8.27.98</p>   |   |          |          |    |          |  |  |  |  |
| <p>SCALE 1" = 50'</p>   |   |          |          |    |          |  |  |  |  |
| <p>PAGE</p>   |   |          |          |    |          |  |  |  |  |
| <p>1</p>  |   |          |          |    |          |  |  |  |  |
| <p style="text-align: right;">As Built 307Y-4373</p>  |   |          |          |    |          |  |  |  |  |

11082

