
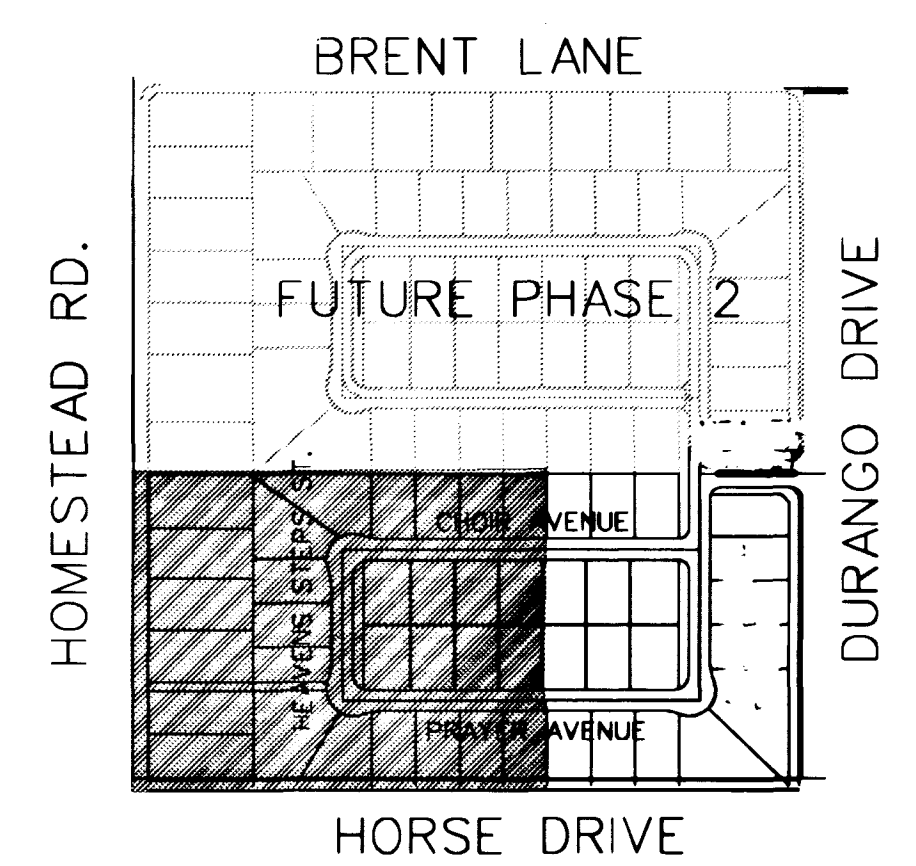
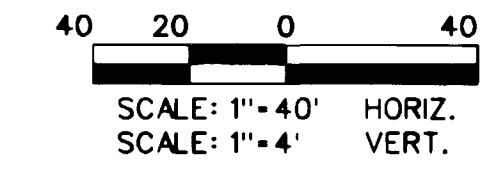
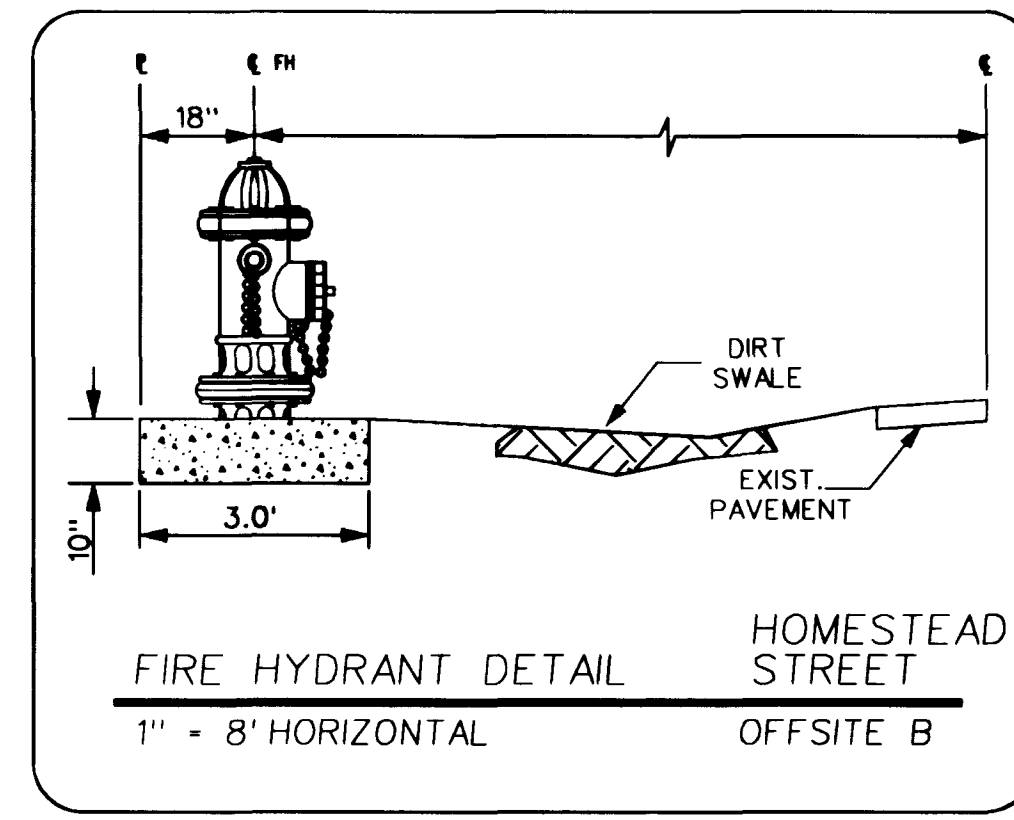
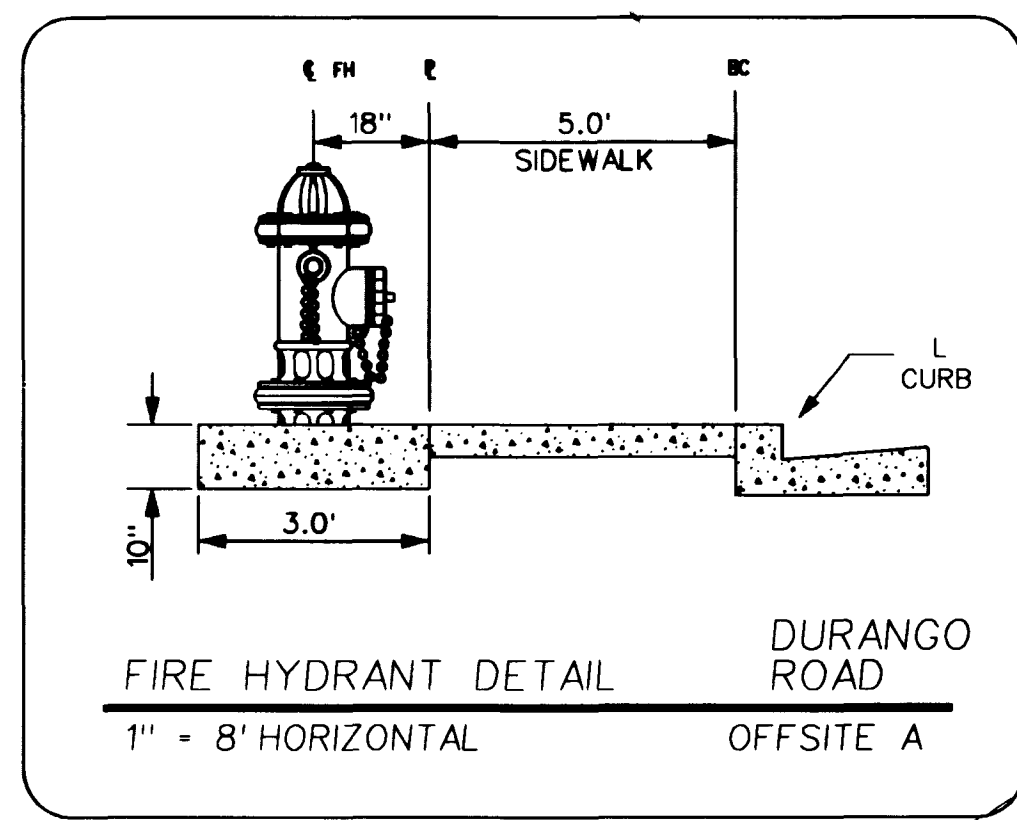


Avoid cutting underground utility lines. It's costly.  
**Call before you Dig**  
 1-800-227-2600

Avoid cutting underground utility lines. It's costly.  
**Call before you Overhead**  
 1-702-593-6111

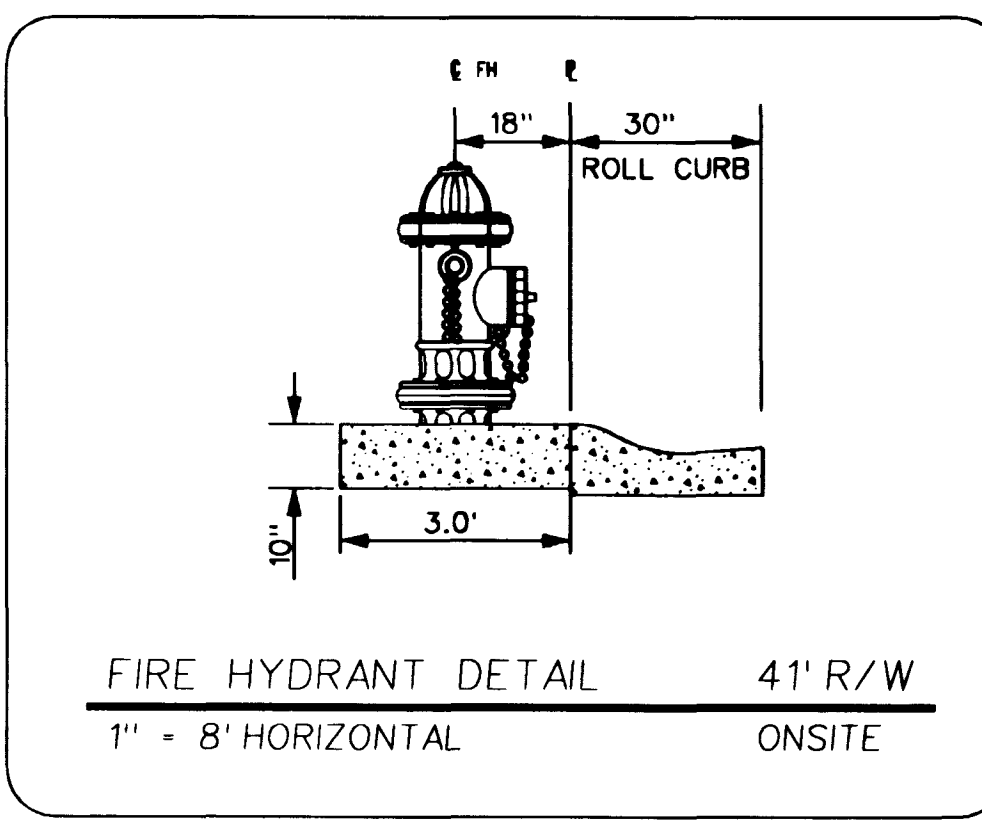

**LOCATION MAP**  
 NTS

**CONSTRUCTION NOTE**

ALL EXISTING UTILITY STRUCTURES WITHIN CONSTRUCTION AREA SHALL BE ADJUSTED TO MATCH FINISH GRADE (I.E. WV, BOX, W/MH, ANNODE BOX, FH, TEL BOX, ETC.)  
**NOTE:**  
 ALL DIMENSIONS TO UTILITIES ARE TO CENTERLINE OF PIPE UNLESS INDICATED OTHERWISE  
 CONTRACTOR SHALL VERIFY HORIZONTAL AND VERTICAL ALIGNMENT OF EXISTING UTILITIES AND TO NOTIFY THE DESIGN ENGINEER IMMEDIATELY ON ANY DISCREPANCIES PRIOR TO CONSTRUCTION


SEE SHEET C4 FOR LVWWD STANDARD NOTES  
 SEE SHEET C5 FOR WATER CONSTRUCTION NOTES AND QUANTITIES  
 [P] PRIVATE DRIVE, P.U.E., C.L.V. SEWER EASEMENT AND PUBLIC DRAINAGE EASEMENT (TO BE PRIVATELY MAINTAINED)

**SEWER CONSTRUCTION NOTES**

- 1 INSTALL 8" PVC PUBLIC SANITARY SEWER LINE
- 2 INSTALL 48" SANITARY SEWER MANHOLE PER DCSWC DWG. SD-1
- 3 REMOVE EXISTING CAP AND CONNECT PROPOSED SEWERLINE TO EXISTING SEWERLINE
- 4 4" WYE
- 5 4" SEWER LATERAL
- 6 INSTALL 8" CAP FOR FUTURE USE
- 7 INSTALL 18" CAP FOR FUTURE USE
- 8 INSTALL 18" PVC PUBLIC SANITARY SEWER
- 9 INSTALL 60" SANITARY SEWER MANHOLE PER DCSWC DWG. SD-1
- (BW) INSTALL SEWER BACKWATER VALVE PER DCSWC DWG. SD-29 (SEE DETAIL ON SHEET C4)

**SEWER CONTRIBUTION**

AVERAGE FLOW = .0115 MGD  
 PEAK FLOW = .0380 MGD

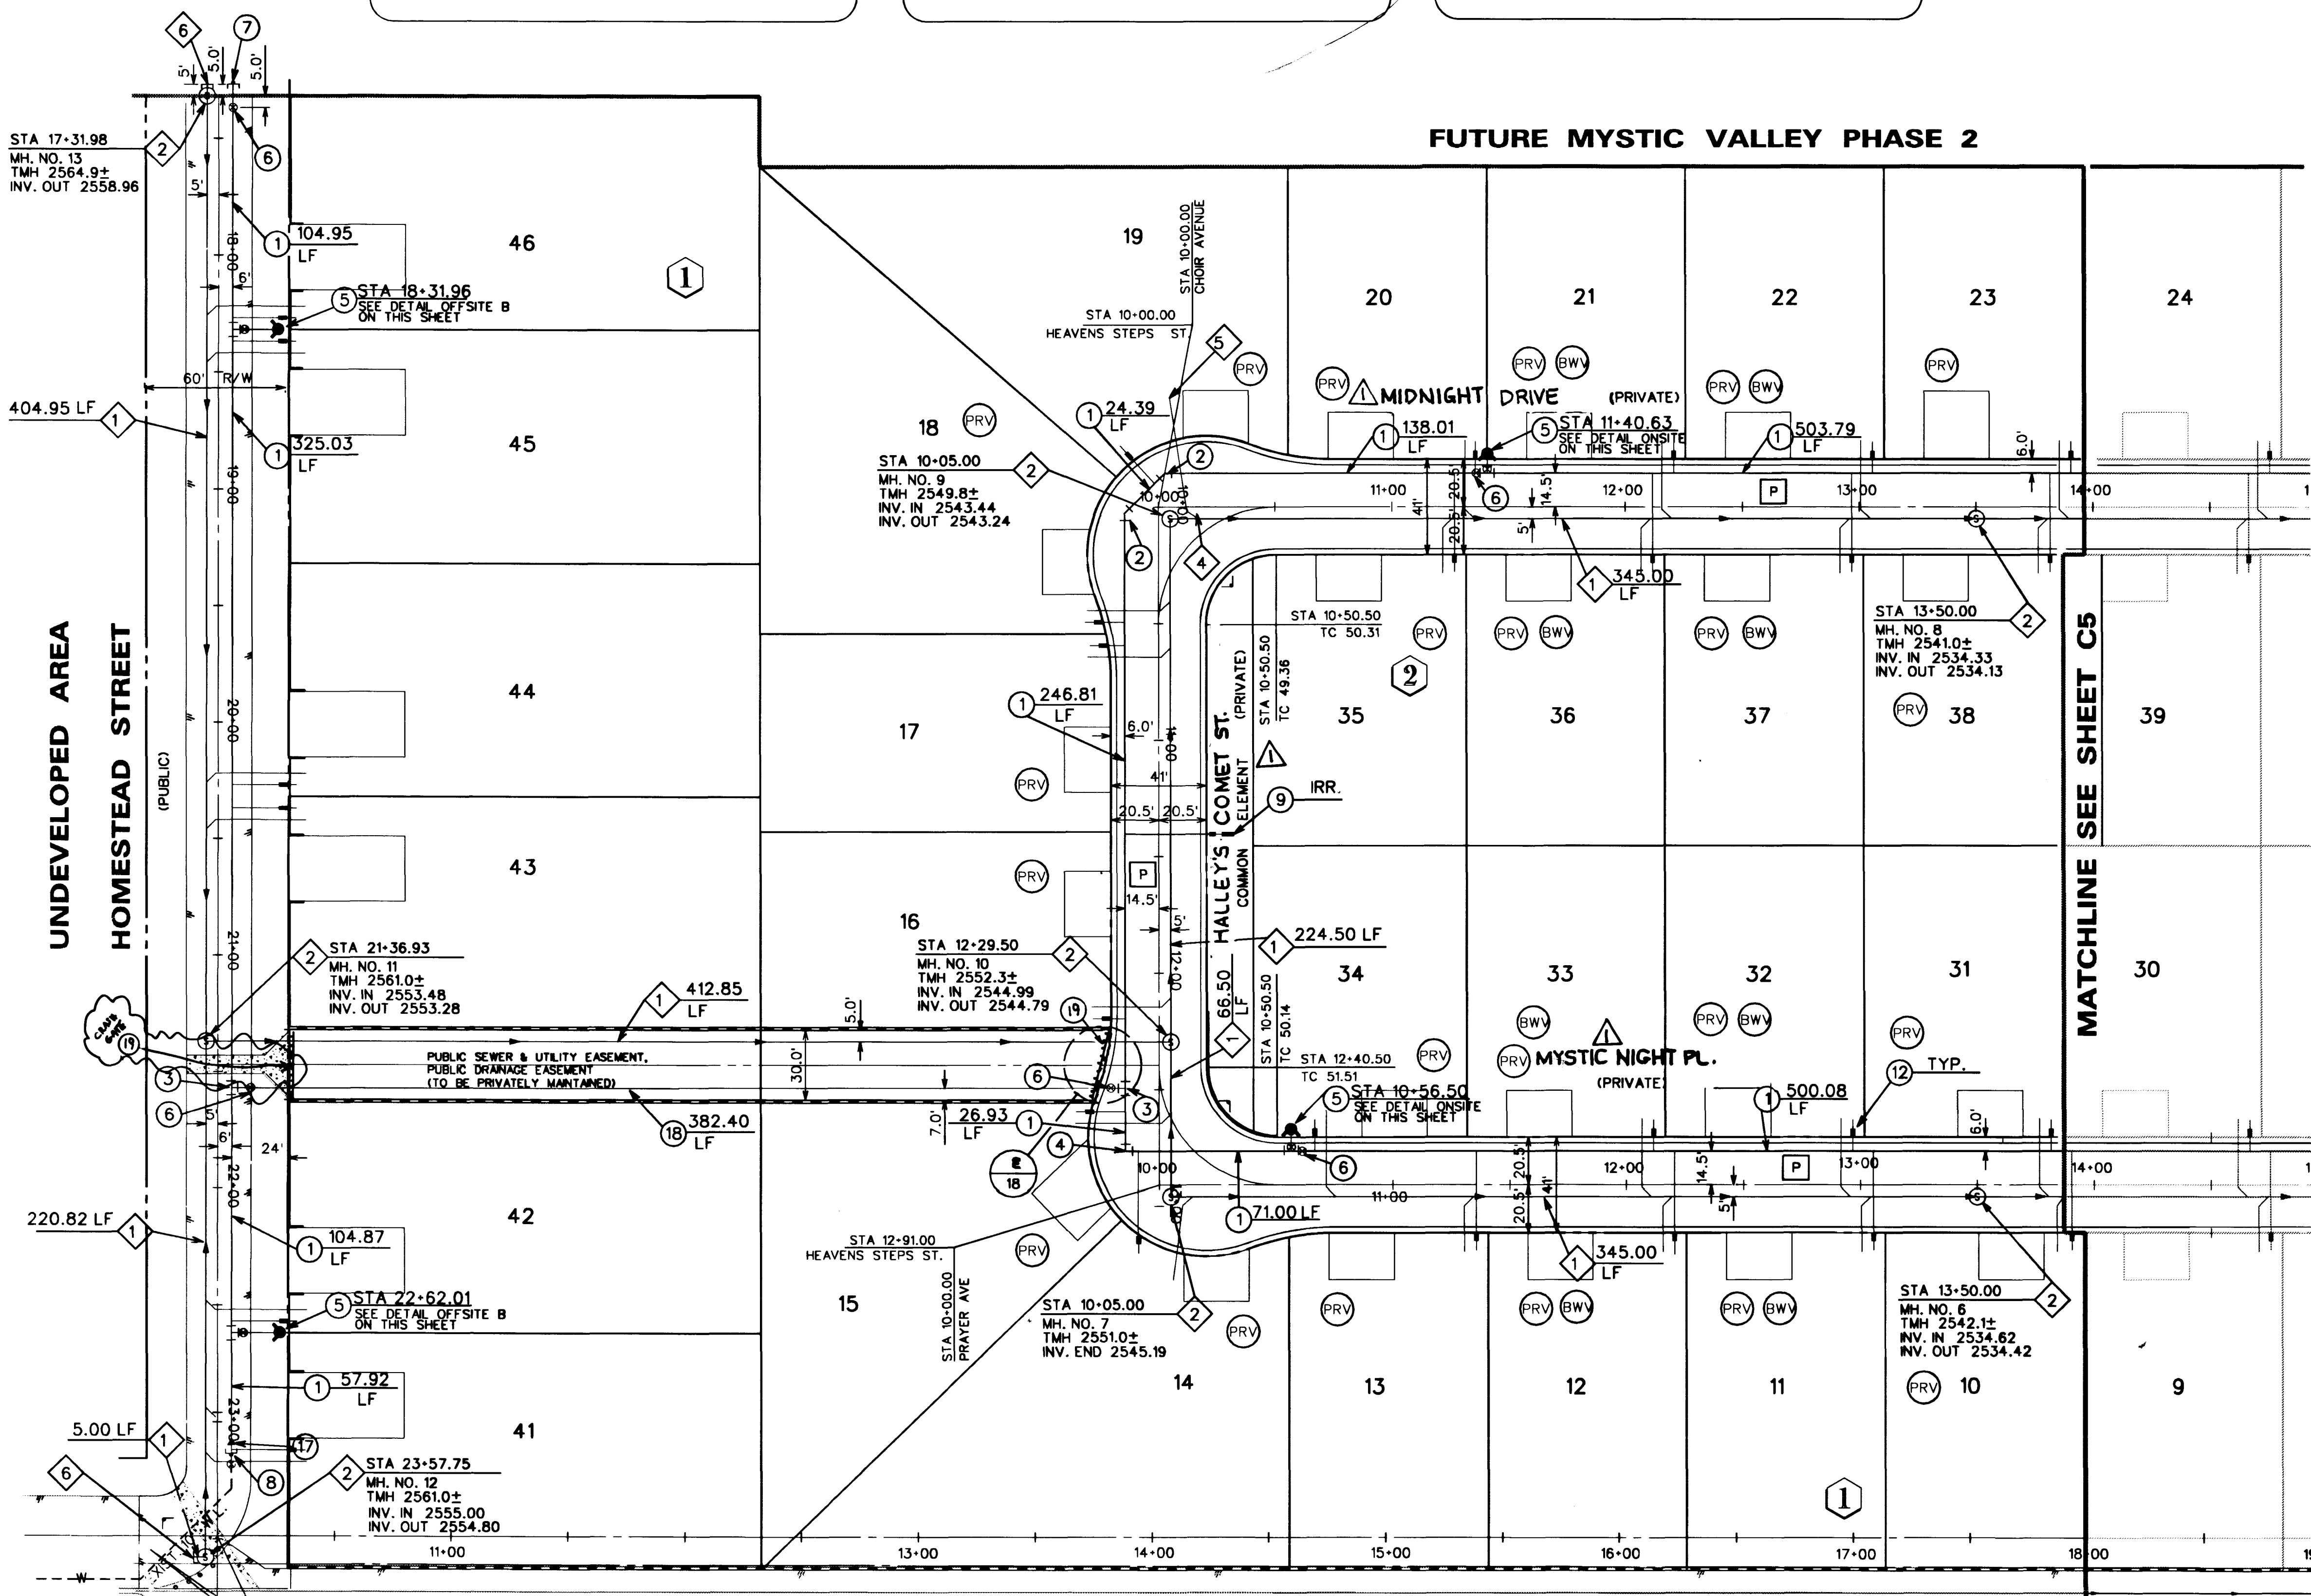

**PROPOSED SPRING MOUNTAIN RANCH**


**APPROVALS**

REVIEWED BY: CLVFD DATE: 3-23-99  
 L.V.V.W.D. DATE: 4/23/99

RICHMOND AMERICAN HOMES OF NEVADA INC.  
 7250 WEST PEAK STE. 212  
 LAS VEGAS, NV 89128  
 (702) 240-9000

MASTER UTILITY PLAN (WEST HALF)  
 MYSTIC VALLEY PHASE 1




DRAWN BY: G. HOWELL, W. KIM 11/4/98  
 DESIGNED BY: E. SERRANO, M. BELLEN 11/4/98  
 CHECKED BY: M. SEEBECK  
 PROJECT NO: 98-9031-03  
 SCALE: 1"=40' HORIZ.

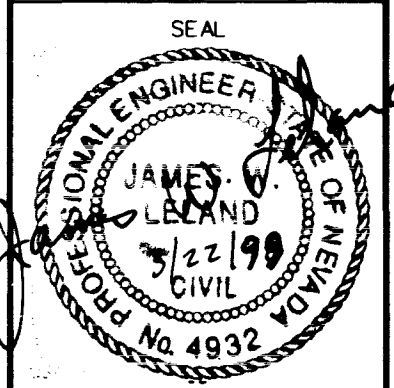

SHEET C6  
 6 OF 18 SHEETS  
 DRAWING NO. 3074-4599-1

Call before  
you Dig  
1-800-227-2600

Call before  
you Overhead  
1-702-593-88

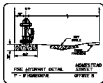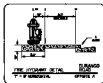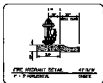


LOCATION MAP

**CONSTRUCTION NOTES**  
 1. ALL UTILITIES TO BE DELETED OR RELOCATED AS SHOWN ON THIS PLAN.  
 2. ALL UTILITIES TO BE DELETED OR RELOCATED AS SHOWN ON THIS PLAN.  
 3. ALL UTILITIES TO BE DELETED OR RELOCATED AS SHOWN ON THIS PLAN.  
 4. ALL UTILITIES TO BE DELETED OR RELOCATED AS SHOWN ON THIS PLAN.

- SERVER CONSTRUCTION NOTES**
- 1. DETAIL OF THE SERVER CONSTRUCTION SHALL BE AS SHOWN ON THIS PLAN.
  - 2. DETAIL OF SERVER CONSTRUCTION SHALL BE AS SHOWN ON THIS PLAN.
  - 3. DETAIL OF SERVER CONSTRUCTION SHALL BE AS SHOWN ON THIS PLAN.
  - 4. DETAIL OF SERVER CONSTRUCTION SHALL BE AS SHOWN ON THIS PLAN.
  - 5. DETAIL OF SERVER CONSTRUCTION SHALL BE AS SHOWN ON THIS PLAN.
  - 6. DETAIL OF SERVER CONSTRUCTION SHALL BE AS SHOWN ON THIS PLAN.
  - 7. DETAIL OF SERVER CONSTRUCTION SHALL BE AS SHOWN ON THIS PLAN.
  - 8. DETAIL OF SERVER CONSTRUCTION SHALL BE AS SHOWN ON THIS PLAN.
  - 9. DETAIL OF SERVER CONSTRUCTION SHALL BE AS SHOWN ON THIS PLAN.
  - 10. DETAIL OF SERVER CONSTRUCTION SHALL BE AS SHOWN ON THIS PLAN.

**SERVER CONTRIBUTION**  
 1.00 PER FOOT OF FRONT YARD  
 2.00 PER FOOT OF REAR YARD

APPROVALS  
 [Signature]  
 [Signature]

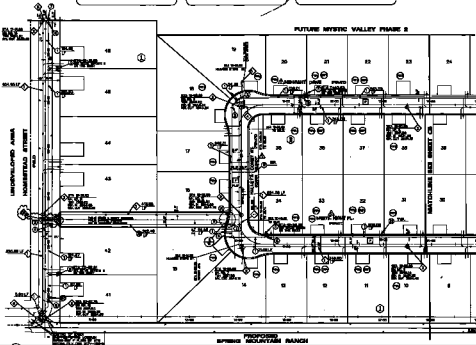

RECORDED AMERICAN HOUSE OF MYSTIC VALLEY INC.  
 1000 MYSTIC VALLEY DRIVE  
 LAS VEGAS, NV 89119  
 702-735-1111

REGISTERED UTILITY PLAN  
 MYSTIC VALLEY PHASE 1  
 MYSTIC VALLEY PHASE 2

SCALE: 1" = 40' (PLAN)  
 SCALE: 1" = 20' (SECTION)

DATE: 10/1/01

BY: [Signature]