

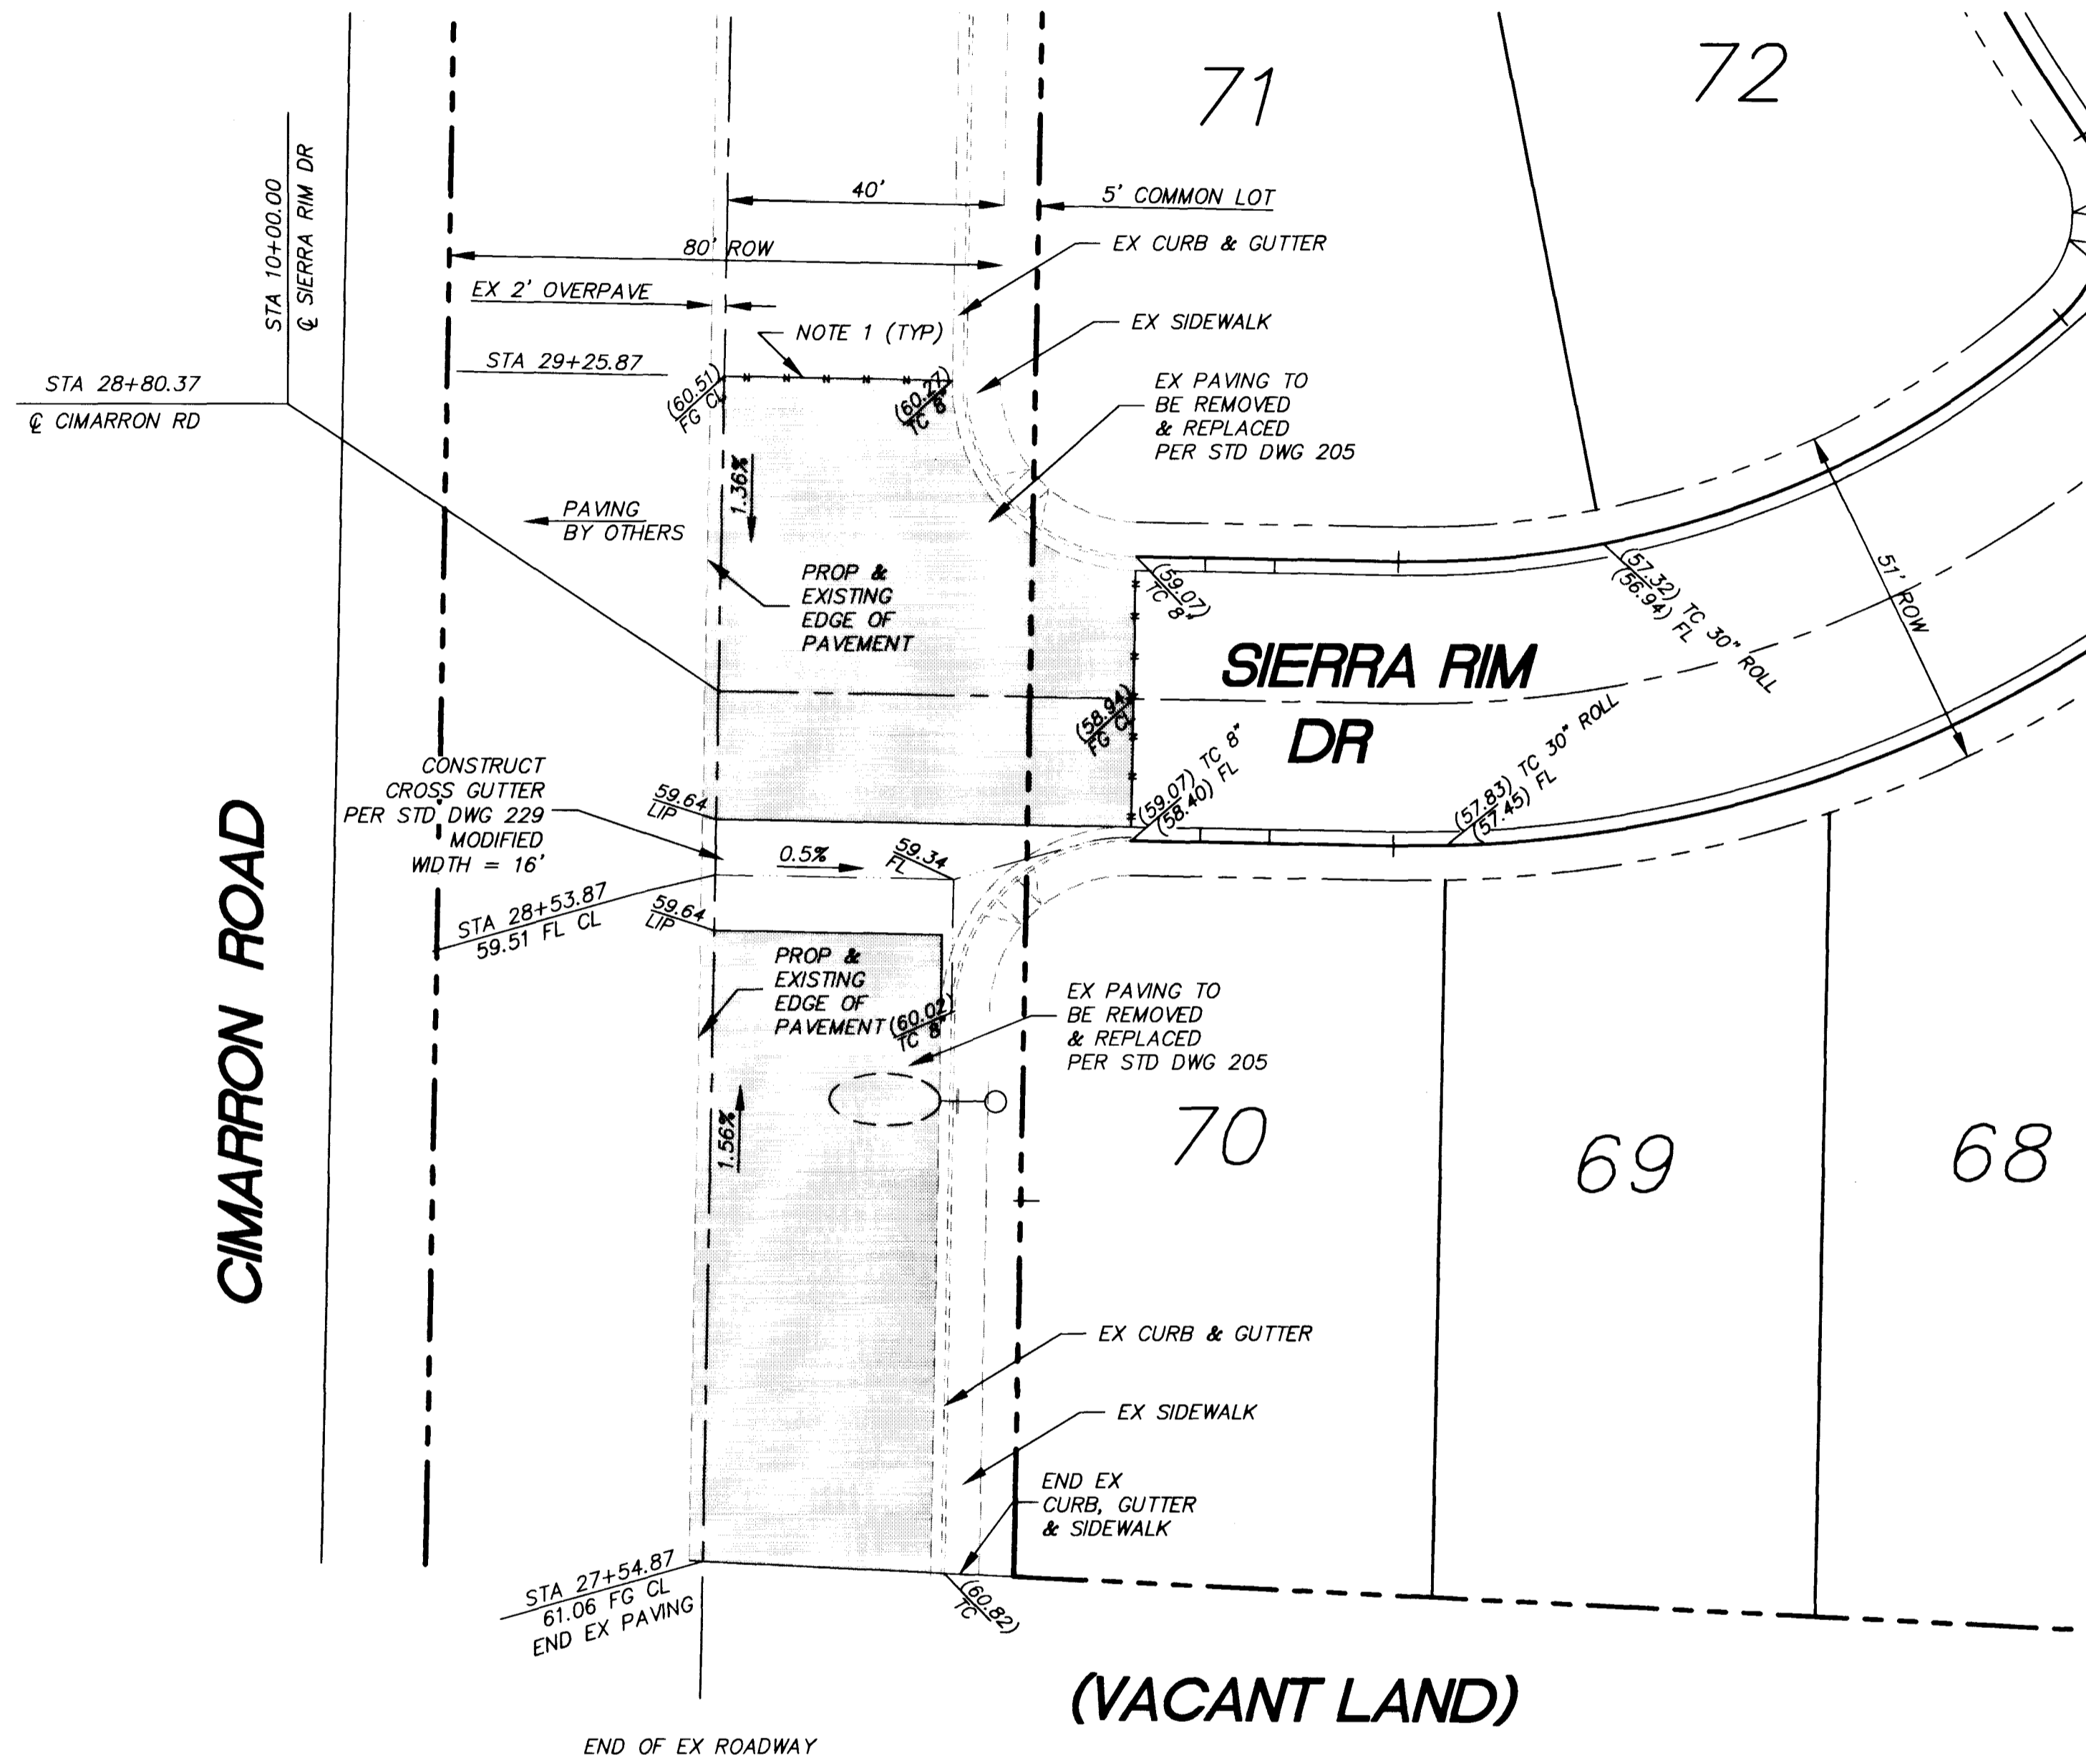


G:\DHI\50655\655PH2-8 Mes Jul 16 16:13:39 1997 COLOR 650C 686-200-03 ANDREW
 HP DesignJet 650C C:\ACAD12\DRW\HPGL2\TKM1.CFG !! HP-GL/2 ADI 4.2 Ver. 1.3 by Hewlett-Packard

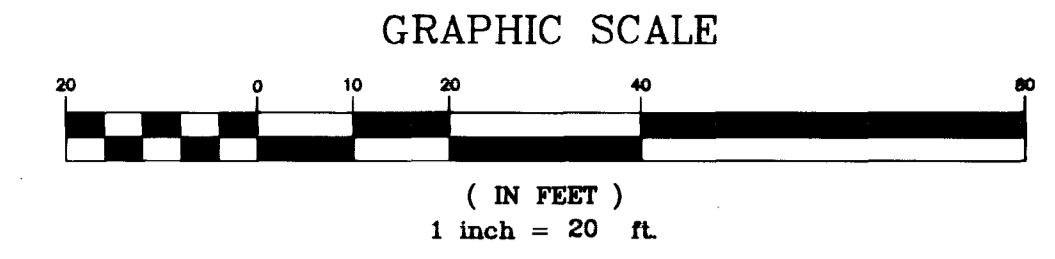

GENERAL NOTES
 1. MATCH EXISTING PAVEMENT

LEGEND
 --- SAWCUT

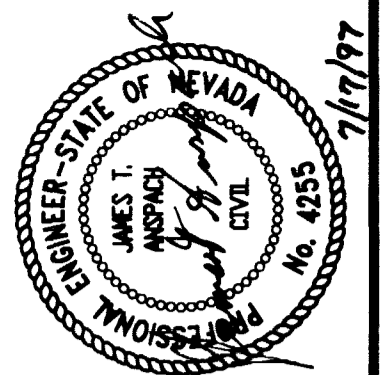

REV.	DATE	DESCRIPTION	APPROVAL
1	7/17/97	THIS DRAWING REPLACES DWG # 8 DATED 12-12-96	
	7/18/97		

- PLANNING
- CIVIL ENGINEERING
- ENVIRONMENTAL SERVICES
- LAND SURVEYING
- LAND DEVELOPMENT
- PUBLIC WORKS
- WATER RESOURCES

THE KEITH COMPANIES, NEVADA



DUNMORE HOMES INC.
MountainAire AT ELKHORN SPRINGS
 CIMARRON ROAD CROSS DRAIN

SHEET NO.:
8
 8 OF 11 SHEETS

July 16, 1997 4:12:52 p.m. Drawing: G:\DHI\50655\655PH2-8.DWG

5360

REVISED 327 Y - 4443 - 2

