




14-107

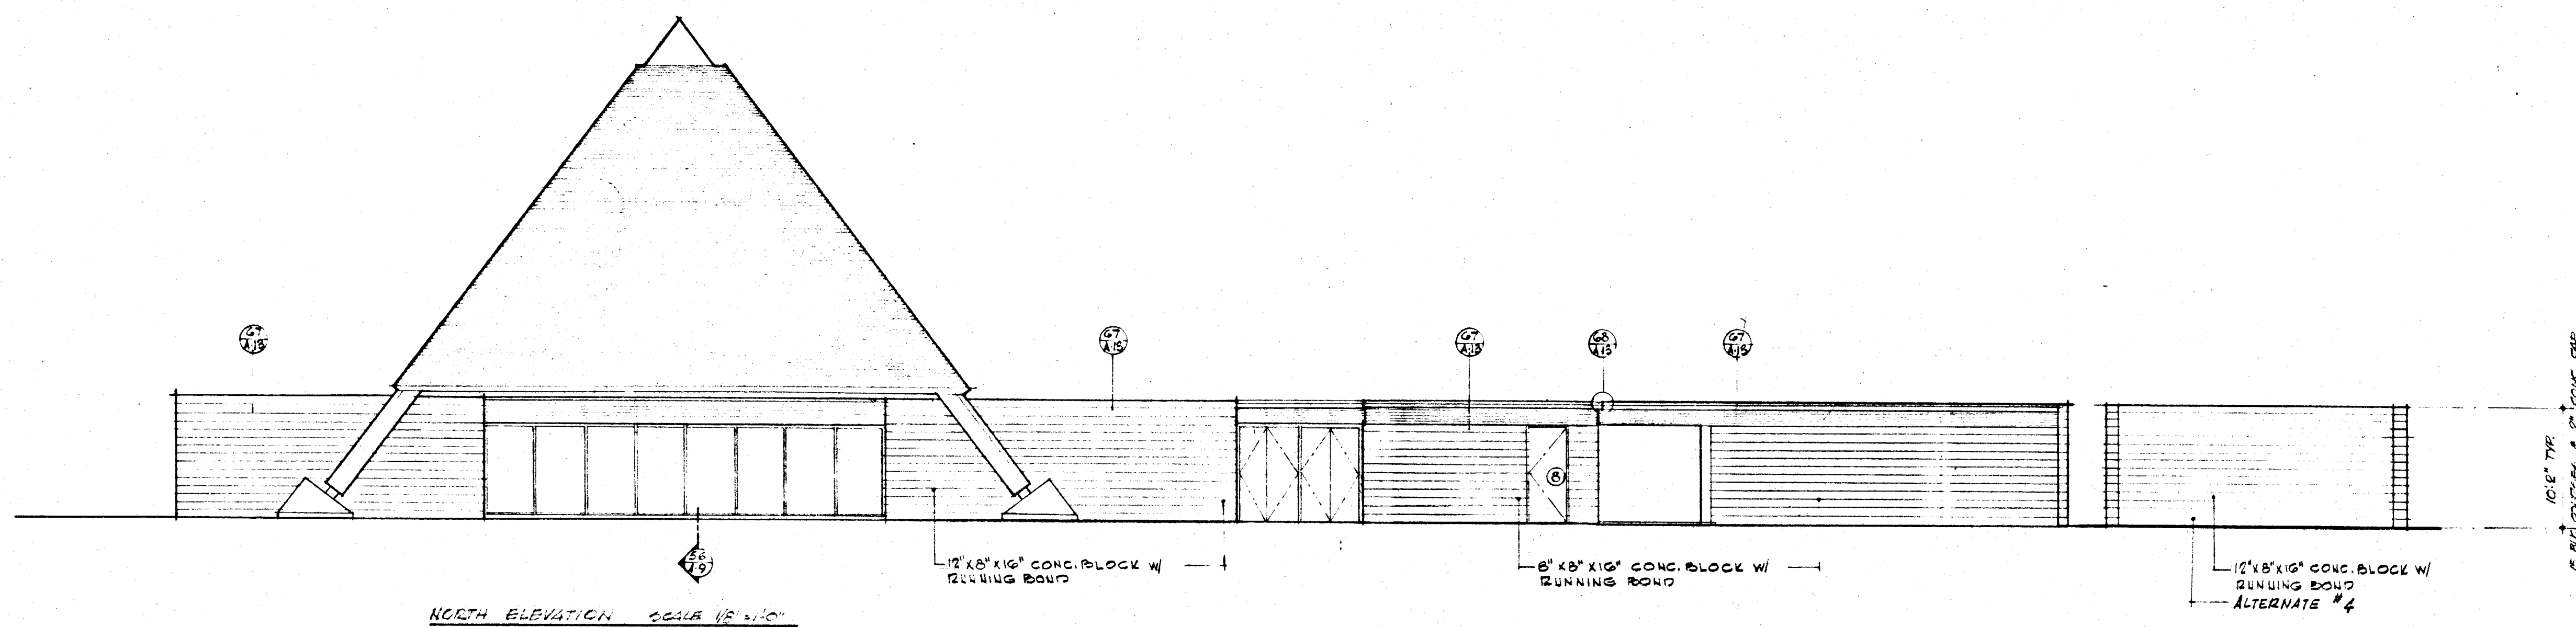

NORTH ELEVATION SCALE 1/8"=1'-0"

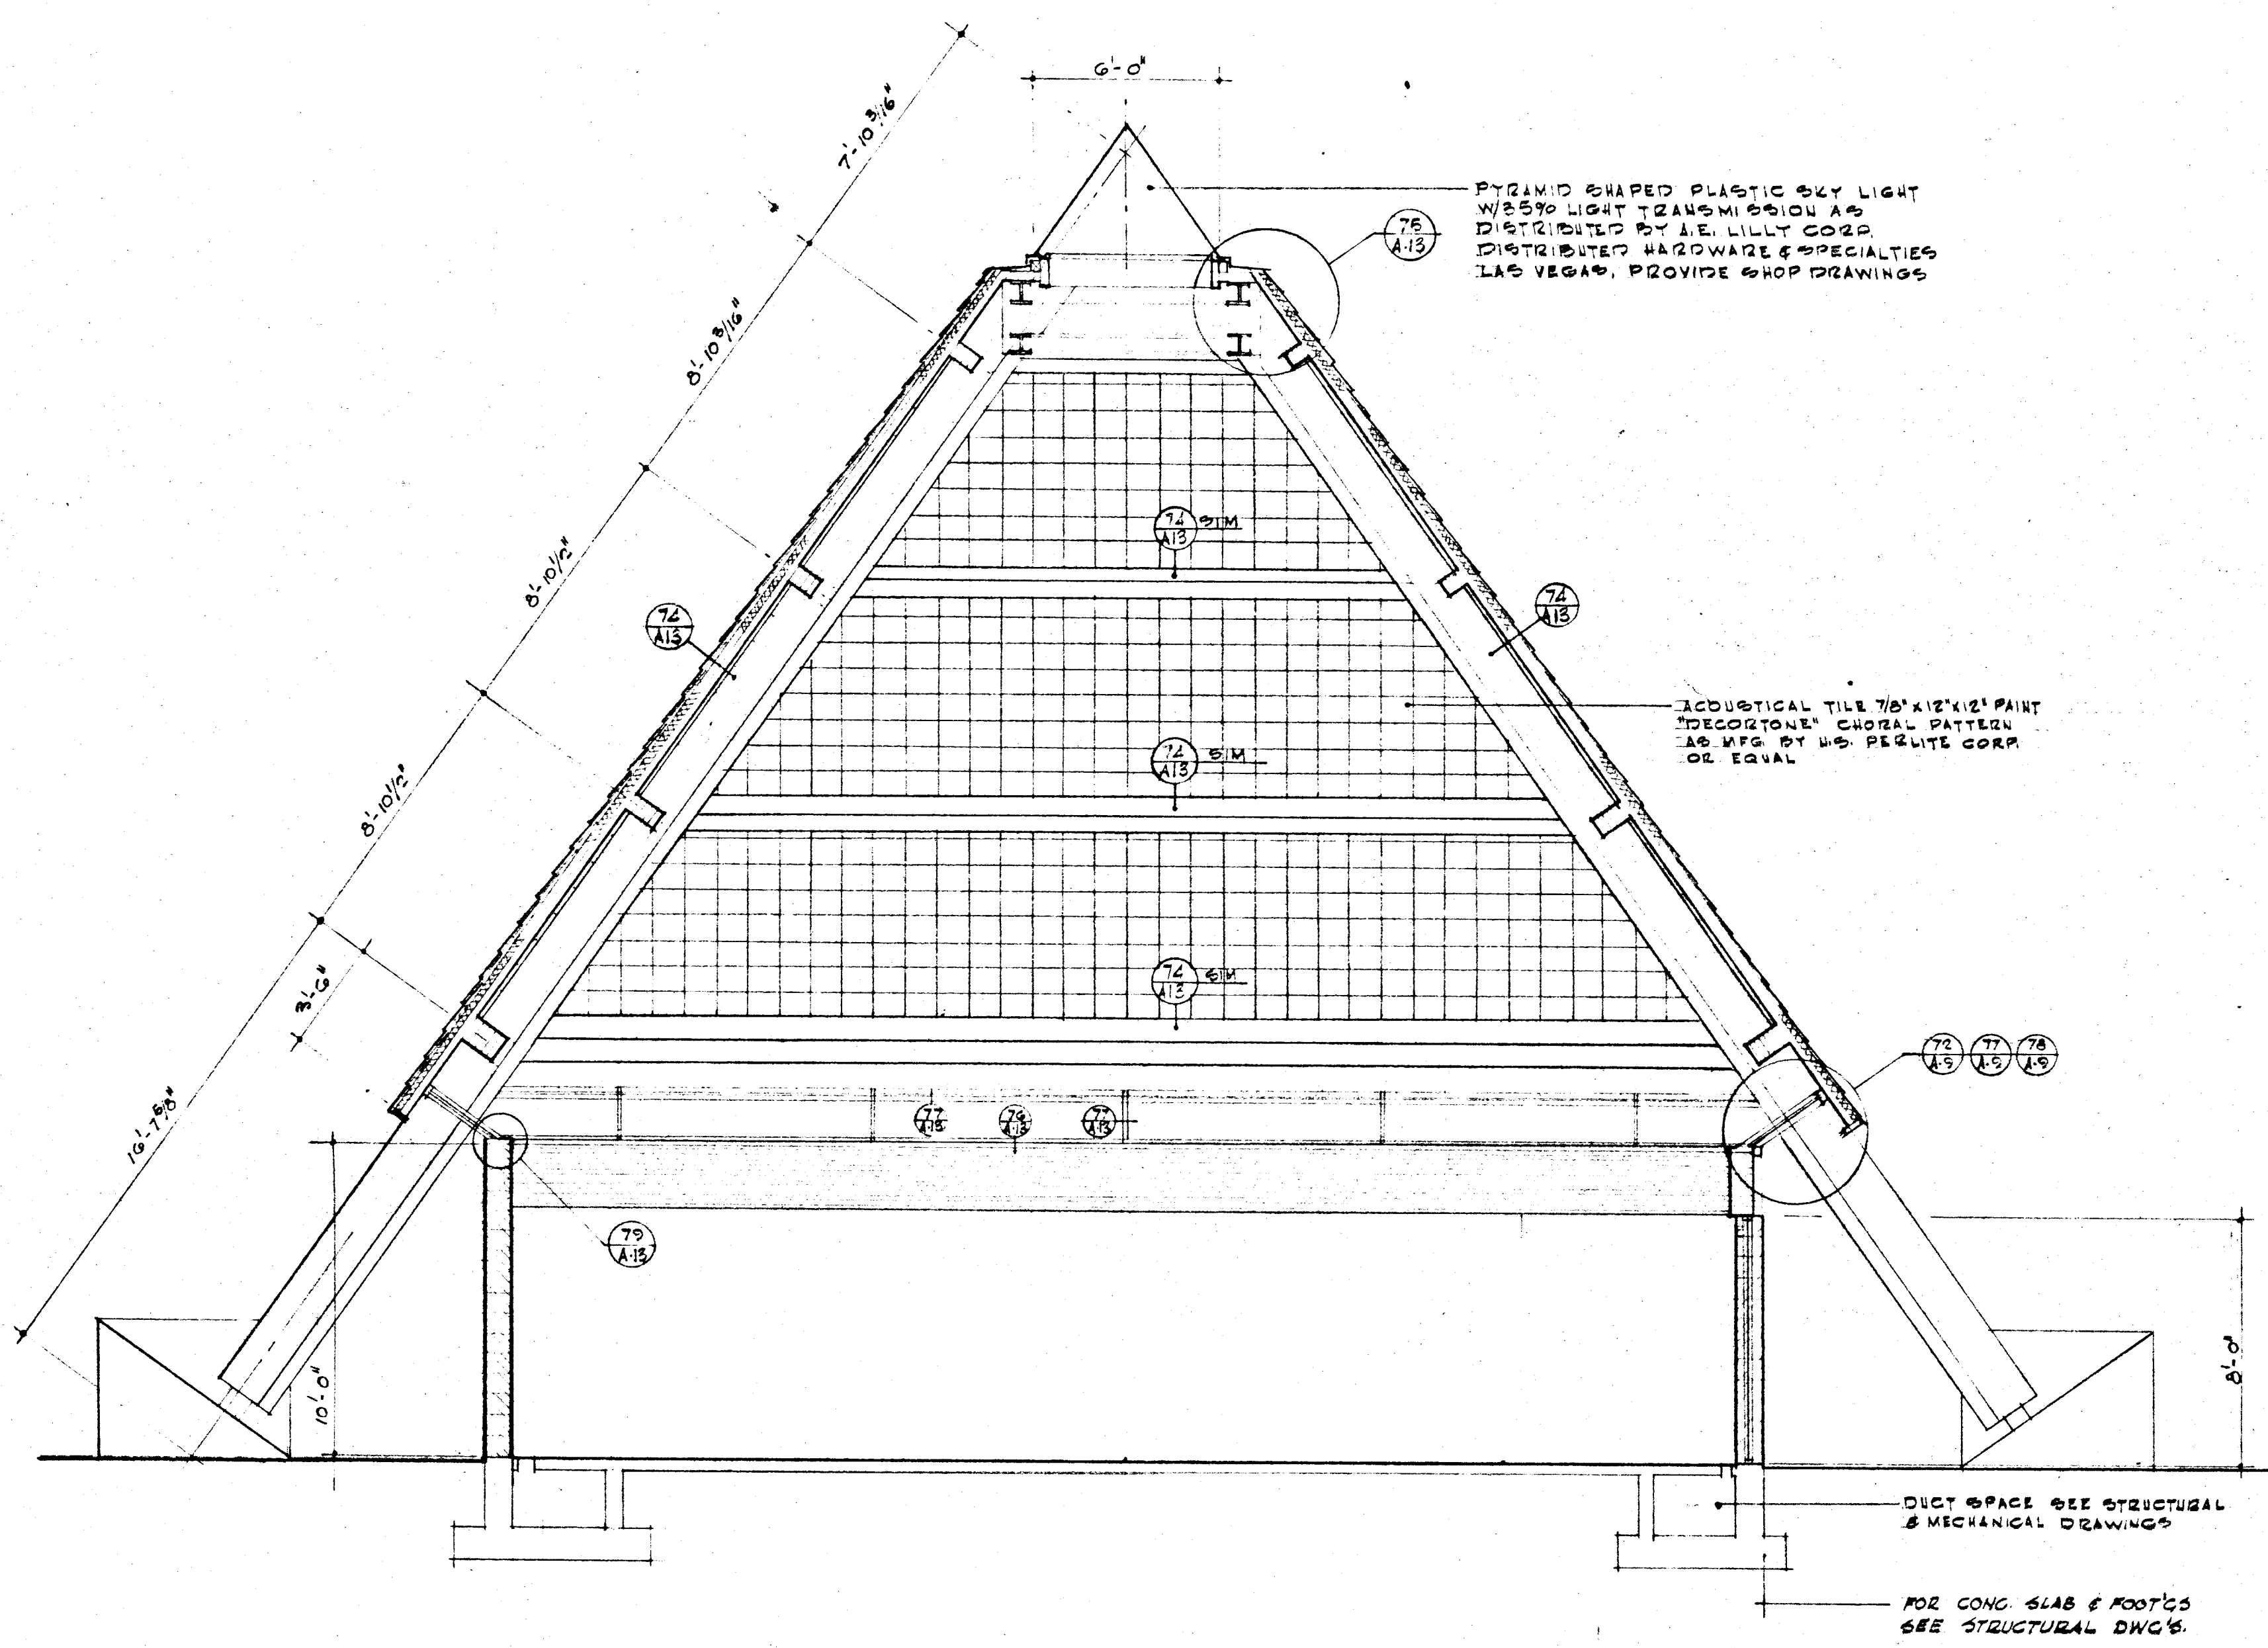

SECTION A-A sc. 1/4"=1'-0"

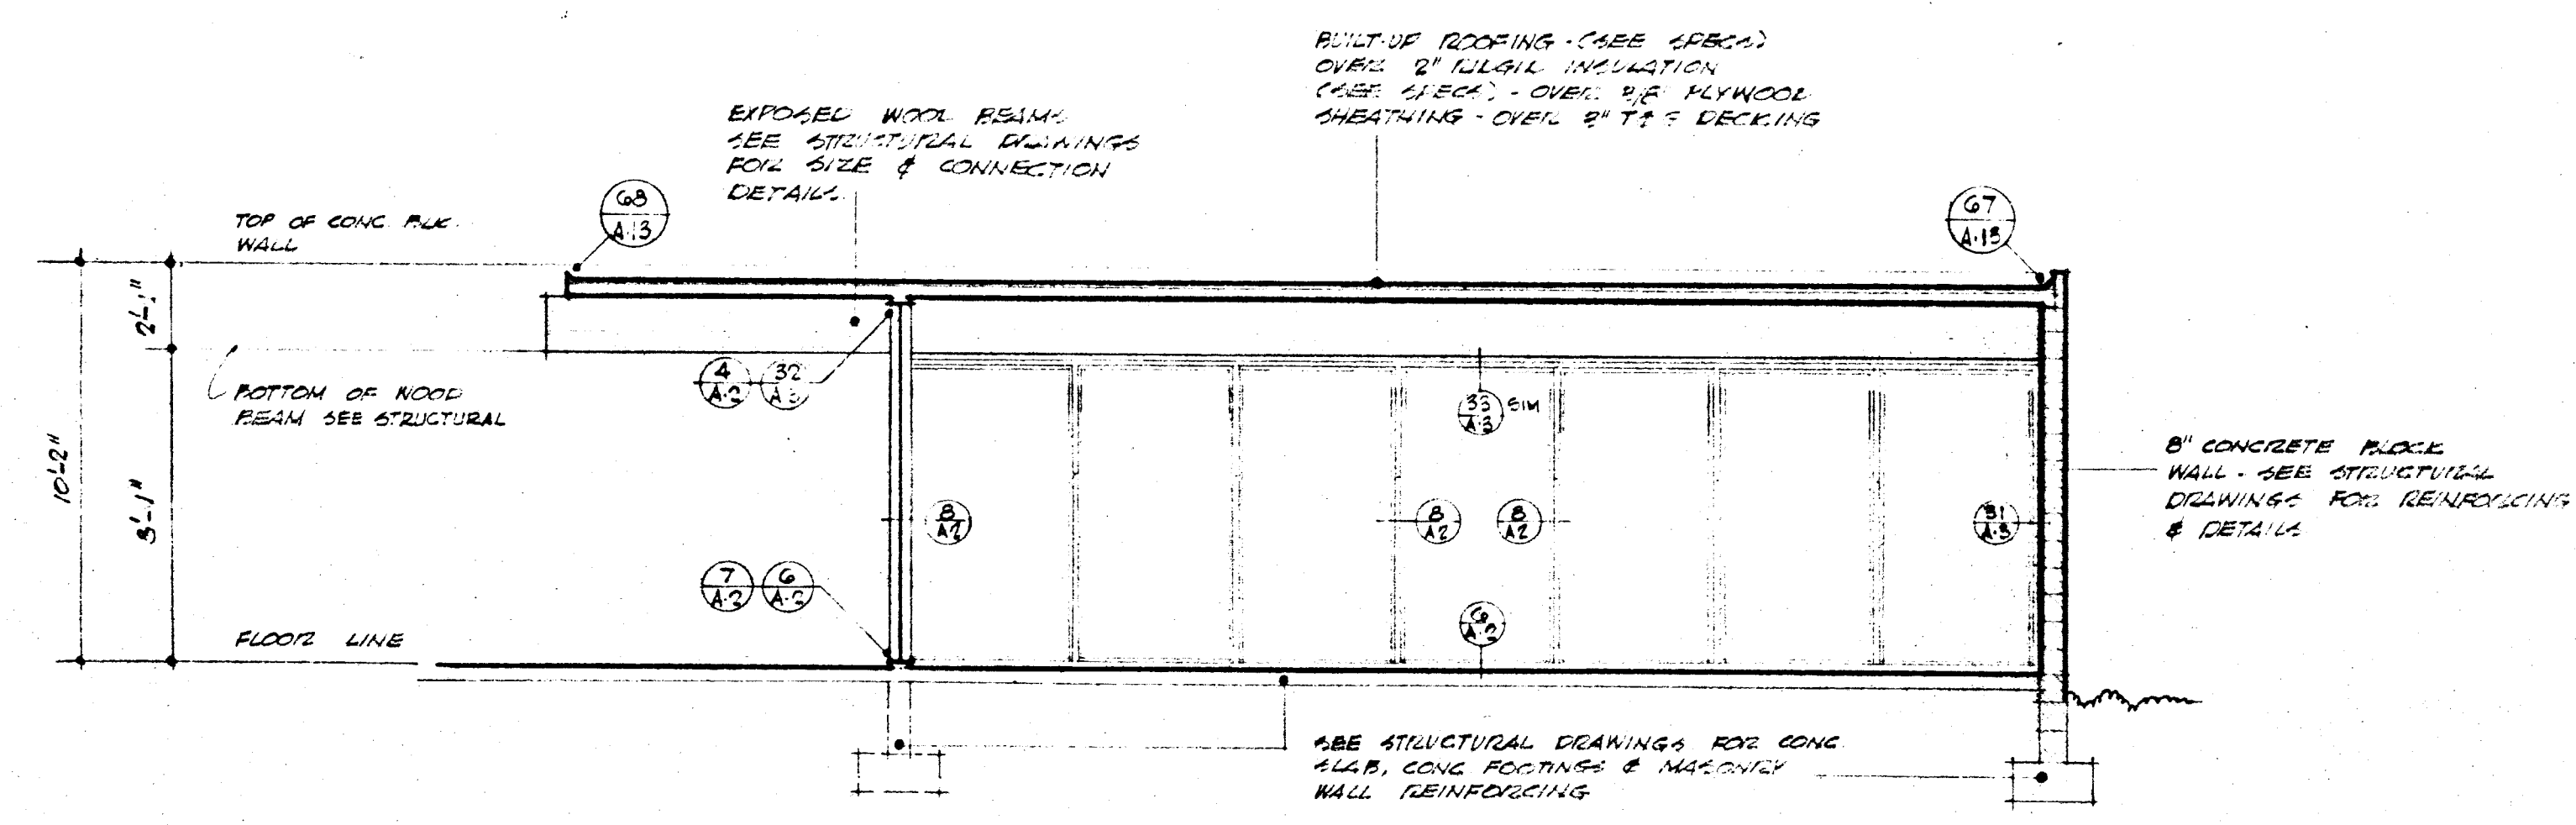

SECTION B-B SCALE 1/8"=1'-0"



**iam**  
**James Brooks McDaniel · architect**  
 maryland parkway & boulevard du montparnasse 382-4350

Job title: RECREATION CENTER  
 CITY OF LAS VEGAS  
 LAS VEGAS, NEVADA

drawn by	WMM			
checked by	JMS			
job number	54-16			
title	SA HOTEL			
date	MARCH - 1966			
no.	date	revision	by	chk
1				
2				
3				

513-27D  
 EXTERIOR ELEVATIONS & SECTIONS  
 M. BUILT DRAWINGS MAY 5 1966  
 sheet title  
 sheet number  
**AS BUILT**  
**AG**  
 of 113