

APPROXIMATE QUANTITIES THIS SHEET			
ITEM	DESCRIPTION	UNIT	QUANTITY

FREEWAY

TO N.P.C. POWER POLE

BIKEPATH

PEDESTAL PANEL 125 AMP
120/240 VOLT W/ 2 TIME
CLOCKS (A/B) AND 2 EA.
2 POLE 40 AMP BREAKER.

PULL BOX


PULL BOX

HARGROVE

TEEN CENTER

- ⊗ EXISTING 175 w. MV. POST TOP LUMINAIRE
- PROPOSED 100 w. H.P.S. POST TOP LUMINAIRE
- 1 1/4" P.V.C. CONDUIT

AS BUILT

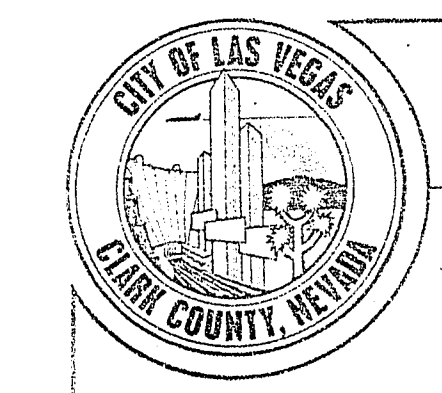

Department of Public Services
Engineering Design Division

**MIRABELLI
TEEN CENTER
EXPANSION**
ELECTRICAL PLAN

scale (h) 1" = 20'-0"	scale (v) —	drawing no.
w.o.no. 6800	f.sk.no. 76 - IX	513-49A
design by C. KAJKOWSKI	drawn by PATTIANNE	date 3-1-77
approved by Director of Public Services	date	sh. 1 of 1

6-12