

FOUNDER NAIL PLASTER
FOUND ACCEPTED (USED)

S 81° 51' 32" W --- 1741.15 ---

S 34 1 1 1
S 3 5 2
NAIL FOUND
ACCEPTED (USED)

S 8° 41' 51" W --- 1330.23 ---


NE 1/4 NE 1/4 SECTION 3, T.20S., R.60E., MDB&M.

N 0° 51' 52" E --- 1336.35 ---

FOUND 2x2 W/NAIL RE 560
ACCEPTED (USED)
(CORNER)

S 89° 52' 42" E --- 1345.23 ---

FOUND 2x2 W/NAIL RE 560
ACCEPTED (USED) (CORNER)

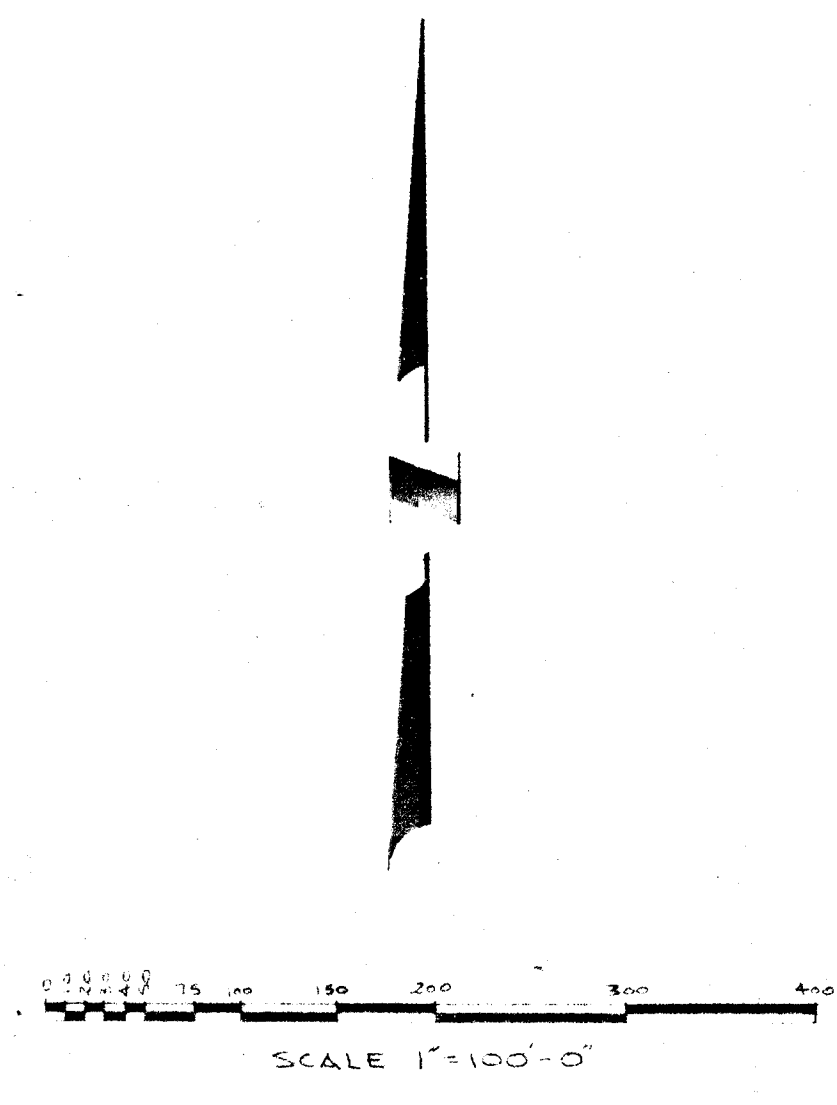

ENGINEER'S CERTIFICATE

I, RALPH L. KRAEMER, REGISTERED CIVIL ENGINEER AND LICENSED LAND SURVEYOR
DO HEREBY CERTIFY THAT THIS MAP IS A TRUE AND ACCURATE PLAT OF THE LAND
SURVEYED BY ME AT THE INSTANCE OF THE NEVADA LAND & MORTGAGE CO.
INC. AND DESCRIBED AS THE NE 1/4 NE 1/4 SECTION 3, T.20S., R.60E., MDB&M,
CLARK COUNTY, NEVADA AND THAT THIS SURVEY WAS COMPLETED ON MAY 10, 1960.
Ralph L. Kraemer
REGISTERED PROFESSIONAL ENGINEER RPE 1349
LICENSED LAND SURVEYOR RLS 1096

BASIS OF BEARINGS

BASIS OF BEARINGS (N 0° 31' 52" E) EAST LINE OF SECTION 3, T.20S., R.60E.,
MDB&M. (RECORDED, CLARK COUNTY RECORDERS OFFICE, CLARK COUNTY,
NEVADA, IN FILE 1, PAGE 46)

• INDICATES 2x2 HUB WITH TAG MARKED RPE 1349 SET AS SHOWN HEREON

WESTERN ENGINEERS INC
7-17-60 11:04 AM
9 32
254

250 P.E.M.



MAP FOR RECORD OF SURVEY
FOR
NEVADA LAND & MORTGAGE CO. INC.
NE 1/4 NE 1/4 SECTION 3, T.20S., R.60E.
MDB&M.
COUNTY OF CLARK STATE OF NEVADA