


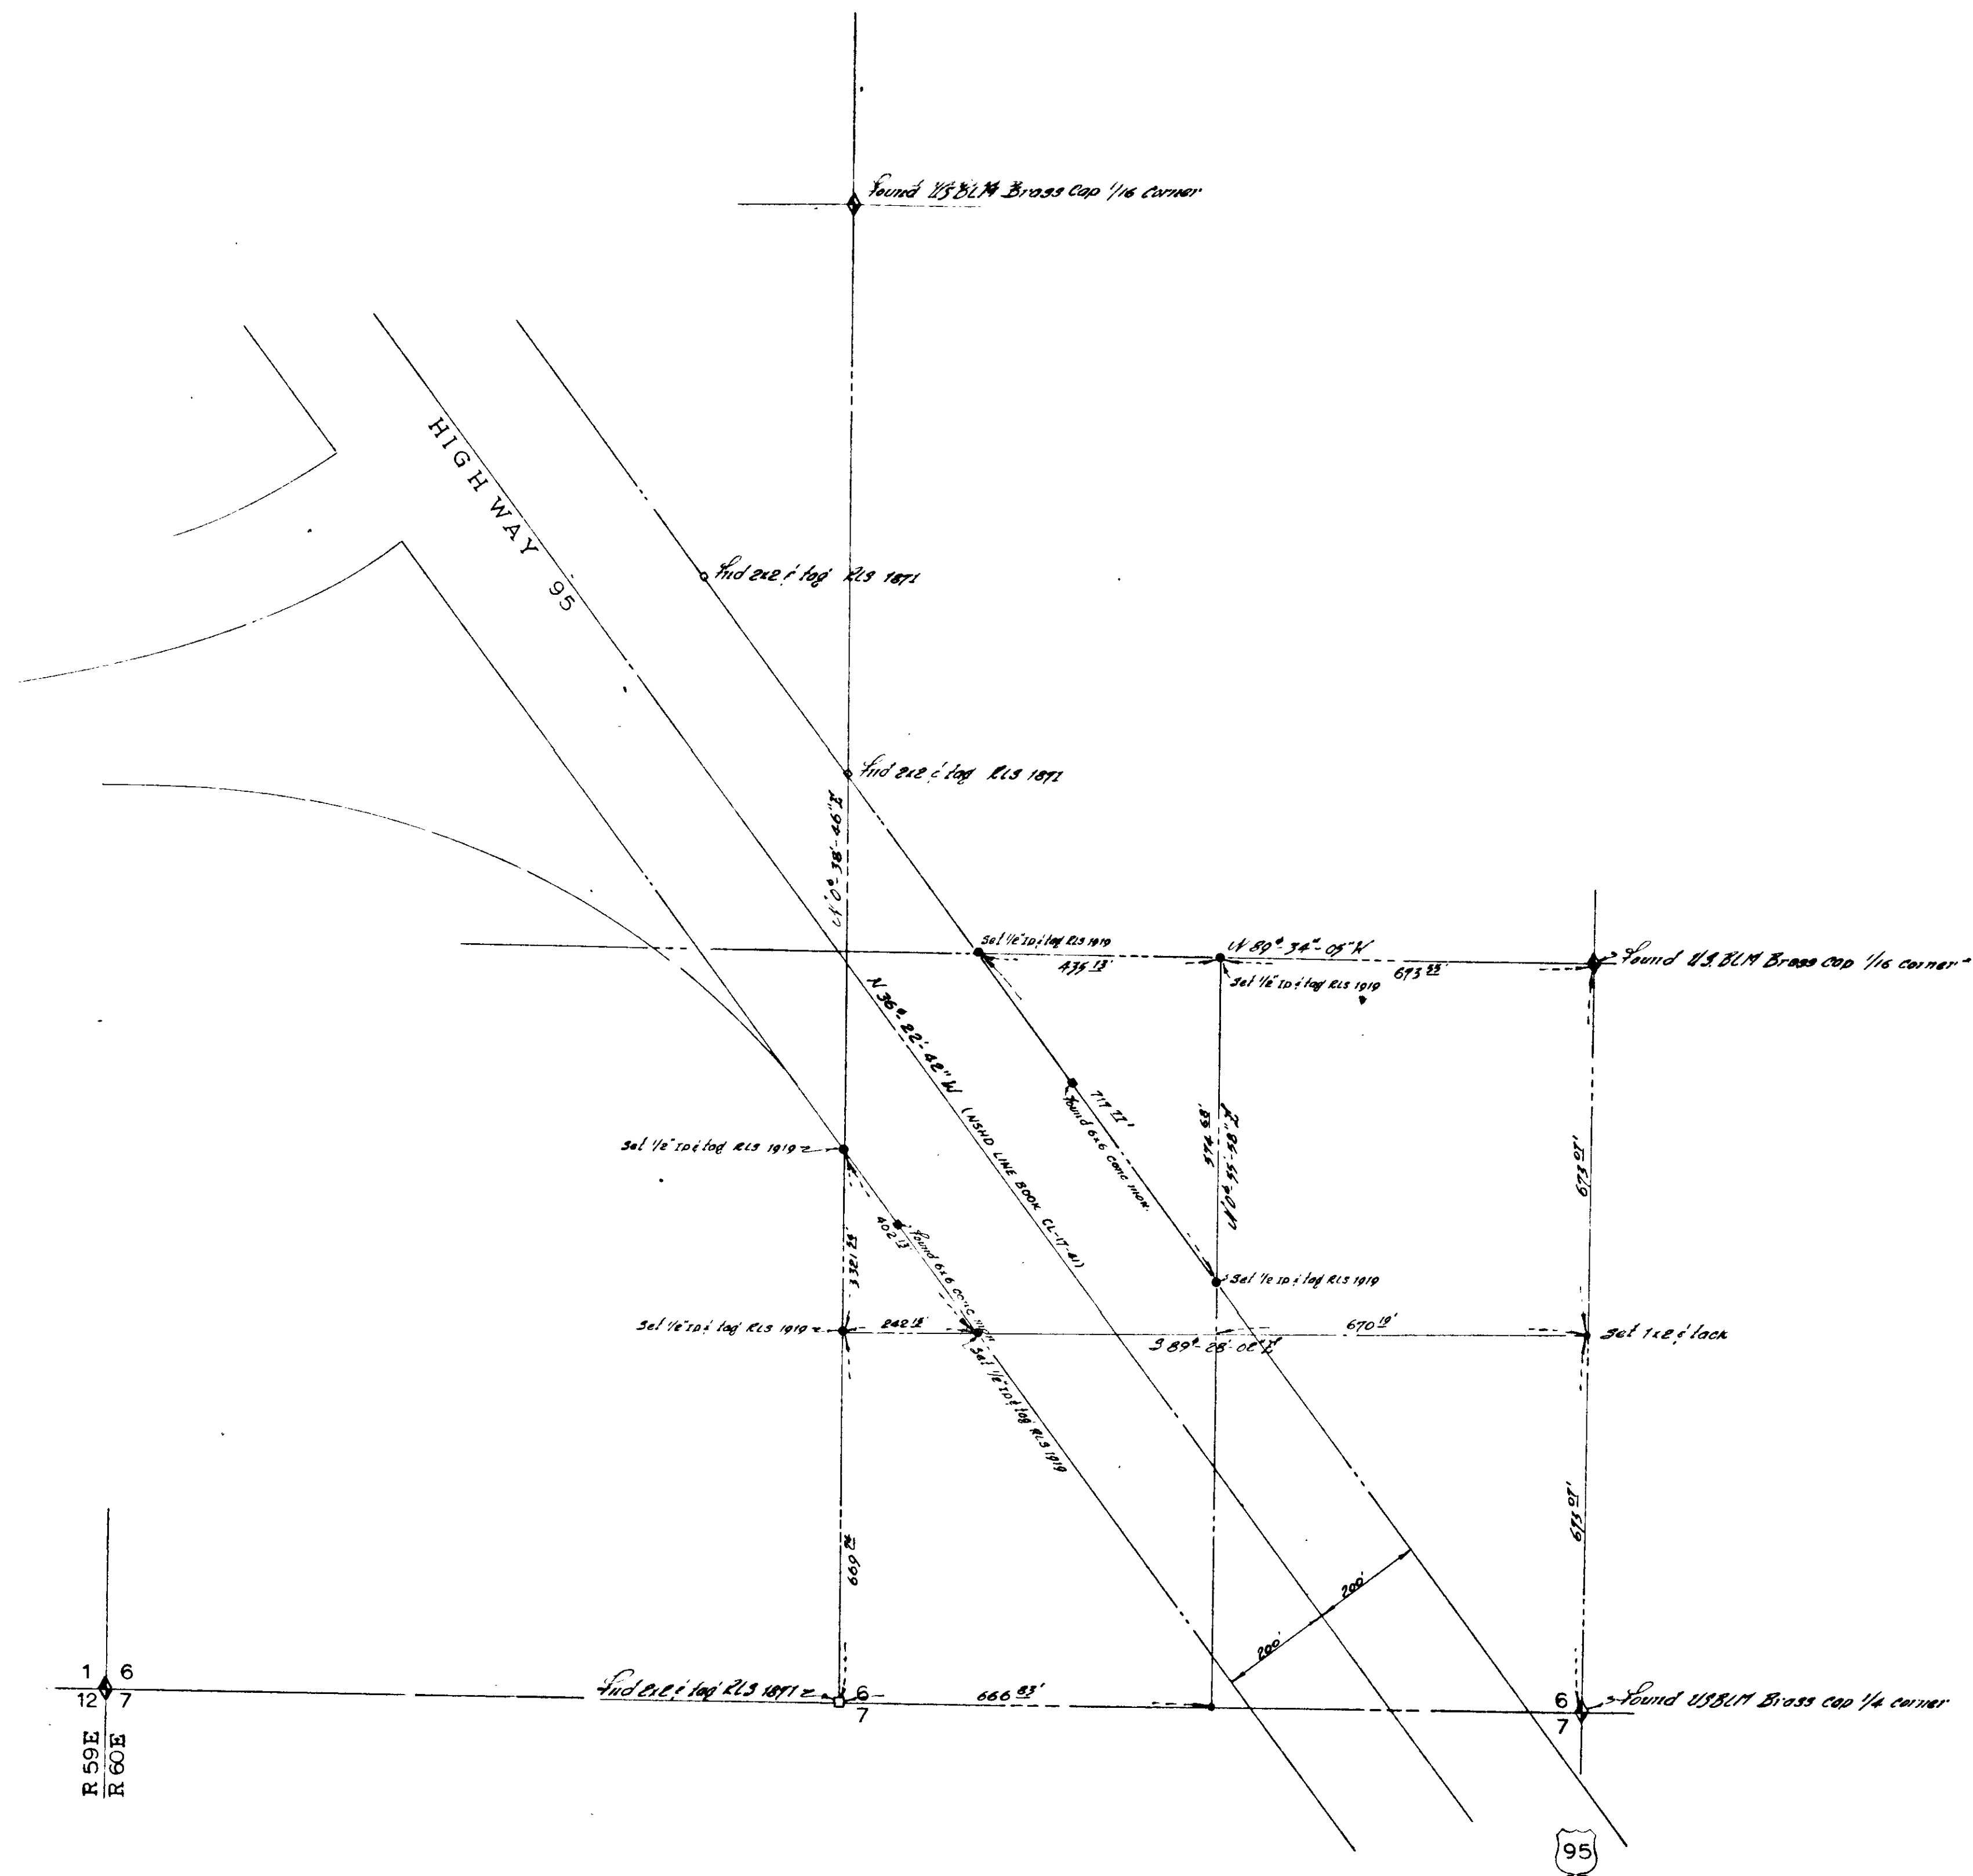

Scale: 1" = 200'

BASIS OF BEARINGS


THE BASIS OF BEARINGS FOR THIS SURVEY IS THE WEST LINE OF THE SE $\frac{1}{4}$ /SW $\frac{1}{4}$ SECTION 6, T19S, R60E, M.D.M. SHOWN AS N0°38'46"E IN FILE 14, PAGE 62 OF SURVEYS, ON FILE IN THE OFFICE OF THE RECORDER, CLARK COUNTY, NEVADA.

SURVEYOR'S CERTIFICATE

I BEN G. SWEET JR. A REGISTERED LAND SURVEYOR IN THE STATE OF NEVADA, HEREBY CERTIFY THAT THIS PLAT CONSISTING OF ONE SHEET, ACCURATELY DELINEATES A SURVEY MADE BY ME, AT THE INSTANCE OF LOYD R. RAMSTAD AND COMPLETED ON THE 13TH DAY OF SEPTEMBER, 1972, OF THE NW $\frac{1}{4}$ /SE $\frac{1}{4}$ /SW $\frac{1}{4}$ SECTION 6, T19S, R60E, M.D.M. THAT THE POINTS FOUND AND THE POINTS SET ARE CORRECTLY SHOWN HEREON.
THAT THIS IS NOT INTENDED AS A SUBDIVISION AS DEFINED IN SECTION 506.3, NEVADA COMPILED LAWS, SUPPLEMENT 1943-1949.

Ben G. Sweet Jr.

BEN G. SWEET JR. REGISTERED LAND SURVEYOR NEVADA CERT. NO. 1919

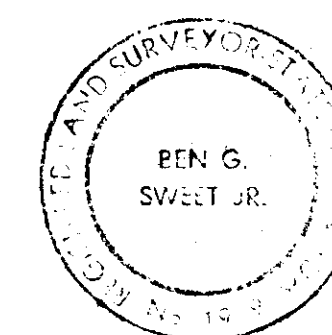

NO. 238532
FILED AT THE REQUEST OF
BEN G. SWEET JR.
DATE 11-15-72 AT 3:16 PM.
FILE 23 PAGE 100 OF SURVEYS
OFFICIAL RECORDS BOOK
NO. 279
CLARK COUNTY NEVADA RECORDS
PAUL E. HORN RECORDER
FEE 2.50 DEPUTY G.V. E.S.

MAP of SURVEY
For
Lloyd R. Ramstad
of
The NW $\frac{1}{4}$ /SE $\frac{1}{4}$ /SW $\frac{1}{4}$ Section 6,
T19S, R60E, M.D.M.
CLARK COUNTY, NEVADA

FILE 23 PAGE 100

055-474