


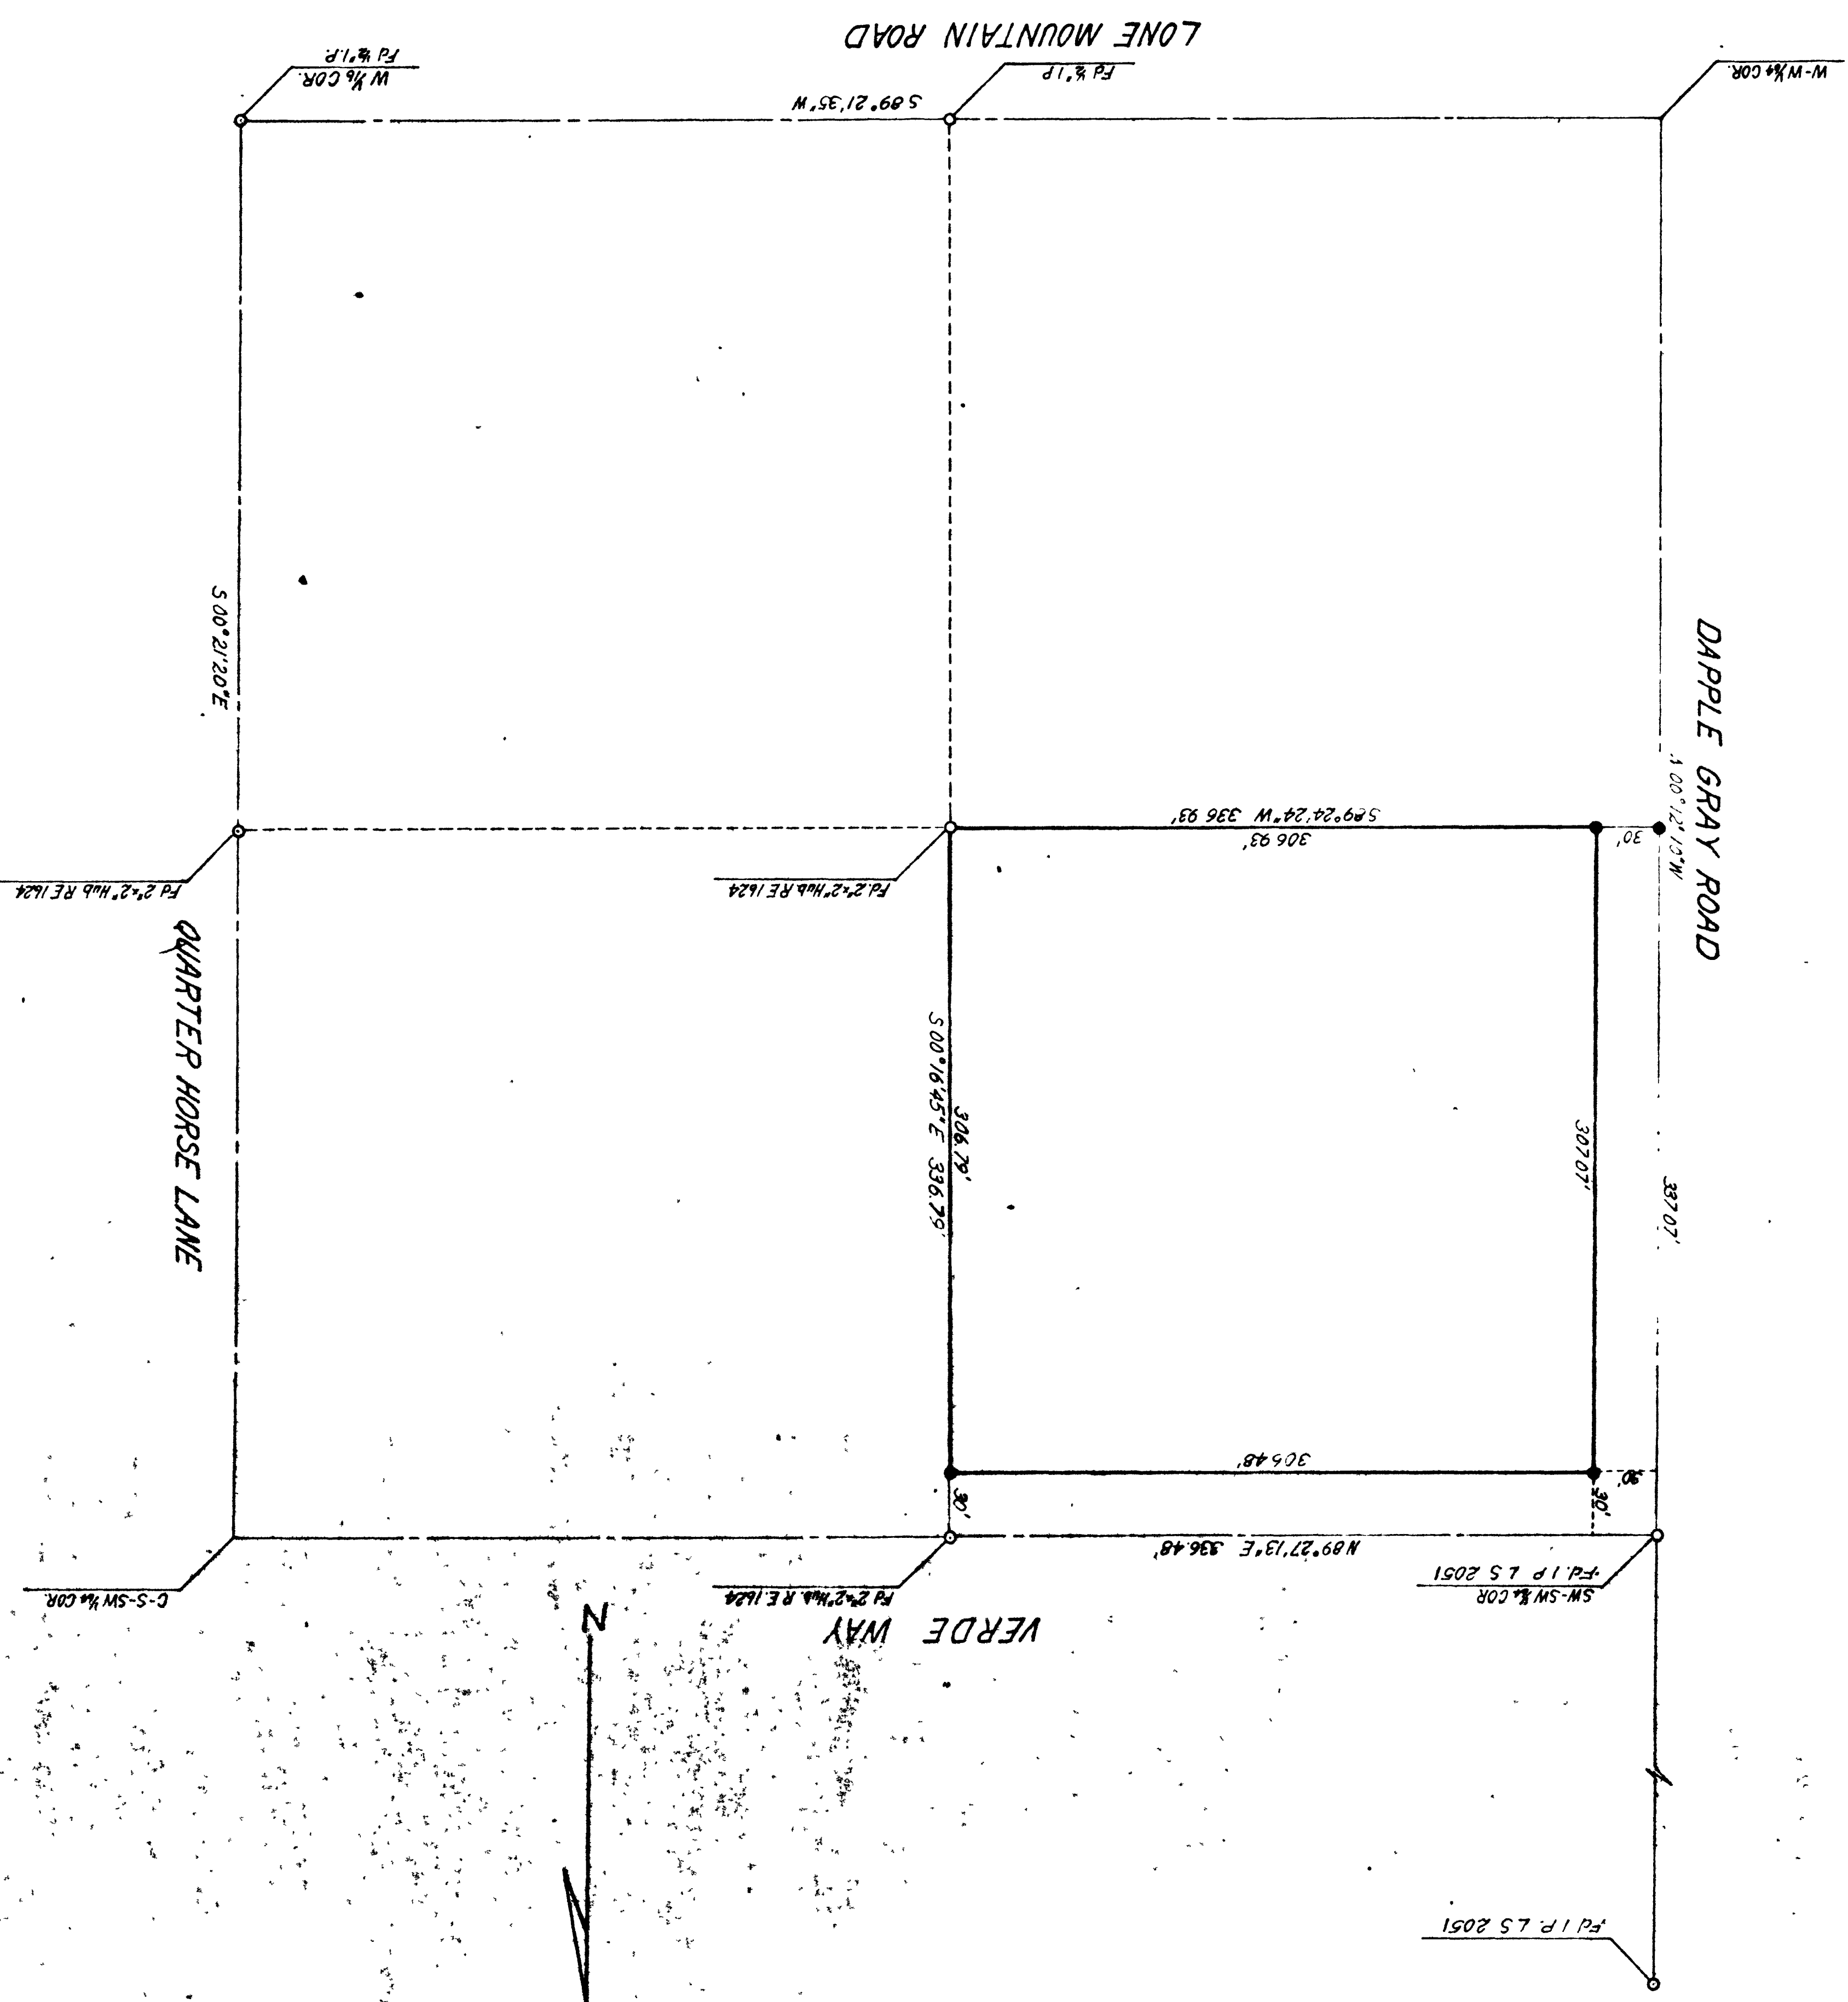

BASIS OF BEARINGS

(S 89° 21' 35\"/>

SURVEYOR'S CERTIFICATE

I, WARREN L. JAUBERT, A DULY LICENSED LAND SURVEYOR DO
HEREBY CERTIFY THAT THIS MAP IS A TRUE AND ACCURATE RE-
PRESENTATION OF THE LANDS SHOWN HEREON. ALL POINTS FOUND
OR SET ARE CORRECTLY DESIGNATED. THIS SURVEY WAS COM-
PLETED ON JUNE 9, 1973 AT THE INSTANCE OF RY ANGLONE AND
DOES NOT CONSTITUTE A SUBDIVISION AS DEFINED BY NEVADA
STATE LAW.

Warren L. Jaubert
WARREN L. JAUBERT, Nevada License No. 2052



LEGEND

- INDICATES 1/8\"/>
- INDICATES POINTS FOUND

SCALE: 1\"/>

MAP FOR RECORD OF SURVEY
FOR
RY ANGLONE
NW 1/4 SEC 32 SW 1/4 SW 1/4 SEC 32 T19S R60E
M.D.B.M. CLARK COUNTY, NEVADA

NO. 300859
FILED AT THE REQUEST OF
WARREN L. JAUBERT
Date 6-28-73 at 1:45 PM
File 26 Page 16
Official Records Book No. 341
Clark County, Nevada, Records
Paul E. Horn, Recorder
Fees \$2.50
G.V. Deputy
E.S.

11330-117
11330-117

MAP FOR RECORD IN CLERK'S
OFFICE OF THE
COUNTY CLERK
OF
NEW YORK COUNTY, NEW YORK
FILED
11330-117

MAP FOR RECORD IN CLERK'S
OFFICE OF THE
COUNTY CLERK
OF
NEW YORK COUNTY, NEW YORK
FILED
11330-117

SEE 546 546 SEC 32 7195 A 60E

SCALE: 1" = 50'


LEGEND
• BOUNDARY MARKERS
• BOUNDARY MARKERS



NOTARY PUBLIC
JAMES J. HENRY
NEW YORK COUNTY, NEW YORK

NOTICE TO THE PUBLIC
I, JAMES J. HENRY, Notary Public for the County of New York, do hereby certify that the foregoing is a true and correct copy of the original of the same as the same appears from the records of the County of New York, New York.

NOTICE TO THE PUBLIC
I, JAMES J. HENRY, Notary Public for the County of New York, do hereby certify that the foregoing is a true and correct copy of the original of the same as the same appears from the records of the County of New York, New York.

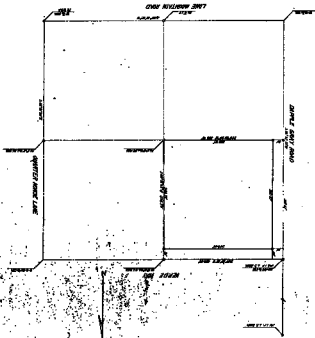

11330-117

11330-117