


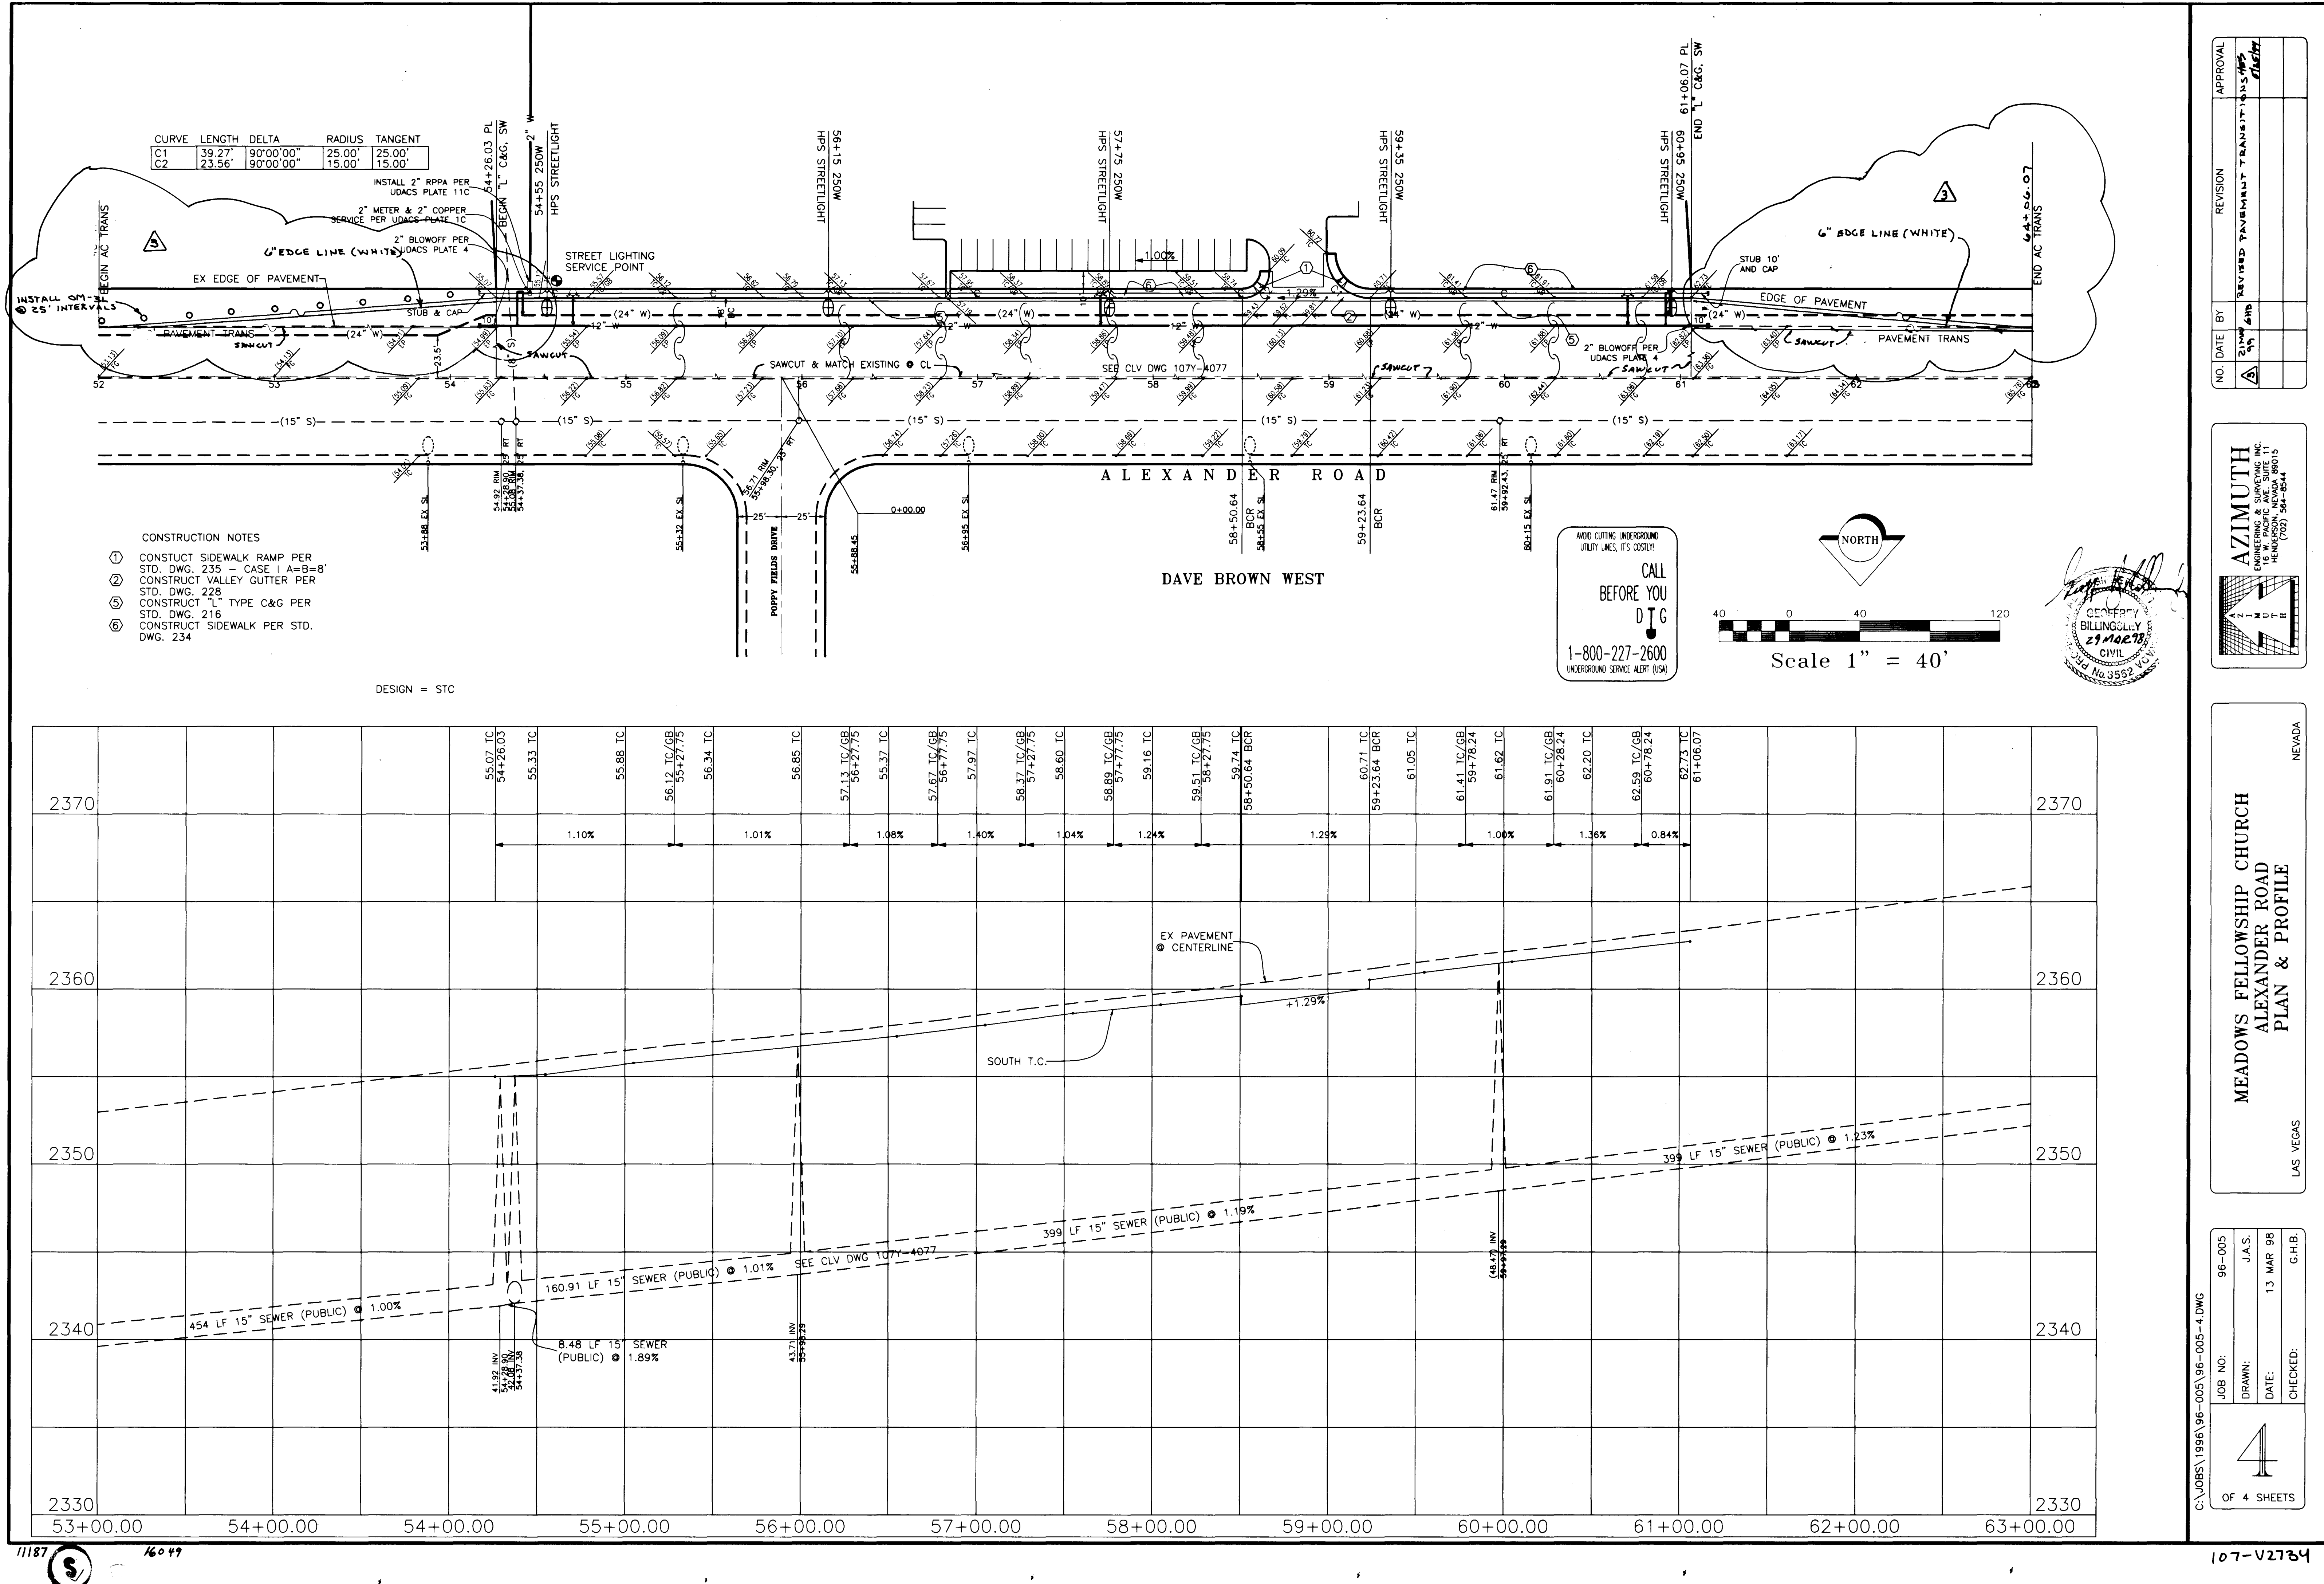

NO.	DATE	BY	REVISION	APPROVAL
1	2/11/98	SHB	REVISED PAVEMENT TRANSITIONS	MS
2	3/98			MS

AZIMUTH
ENGINEERING & SURVEYING INC.
16 W. PACIFIC AVE. SUITE 11
HENDERSON, NEVADA 89015
(702) 504-6844

GEORFFREY BILLINGSLEY
29 MAR 98
CIVIL
No. 3592

MEADOWS FELLOWSHIP CHURCH
ALEXANDER ROAD
PLAN & PROFILE

LAS VEGAS NEVADA

JOB NO:	96-005
DRAWN:	J.A.S.
DATE:	13 MAR 98
CHECKED:	G.H.B.

4
OF 4 SHEETS

C:\JOBS\1996\96-005\96-005-4.DWG

