



1  
6

SECTION

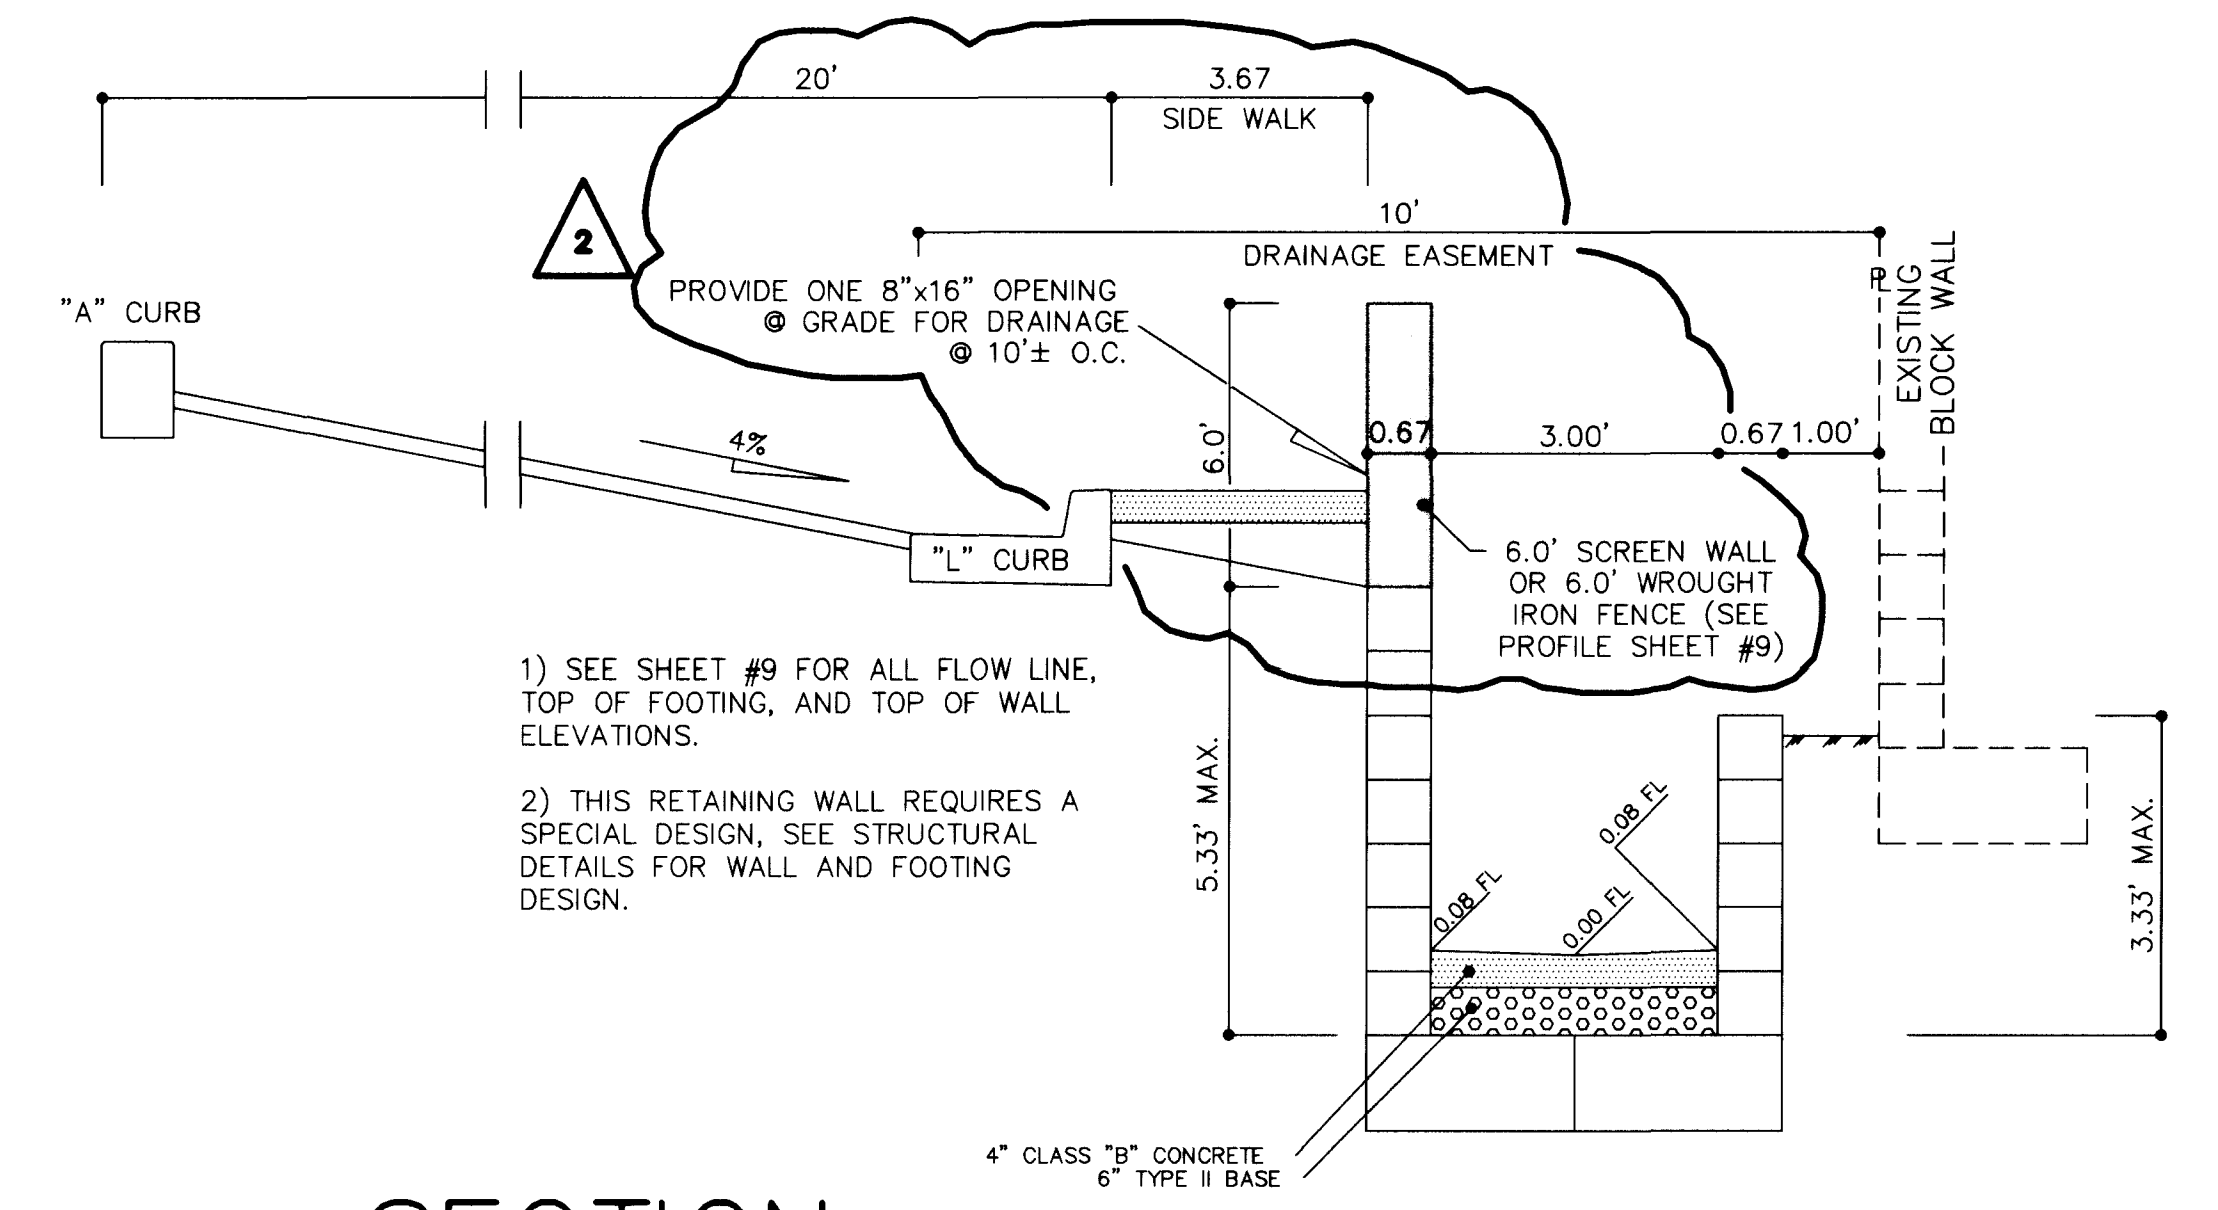


2  
6

SECTION

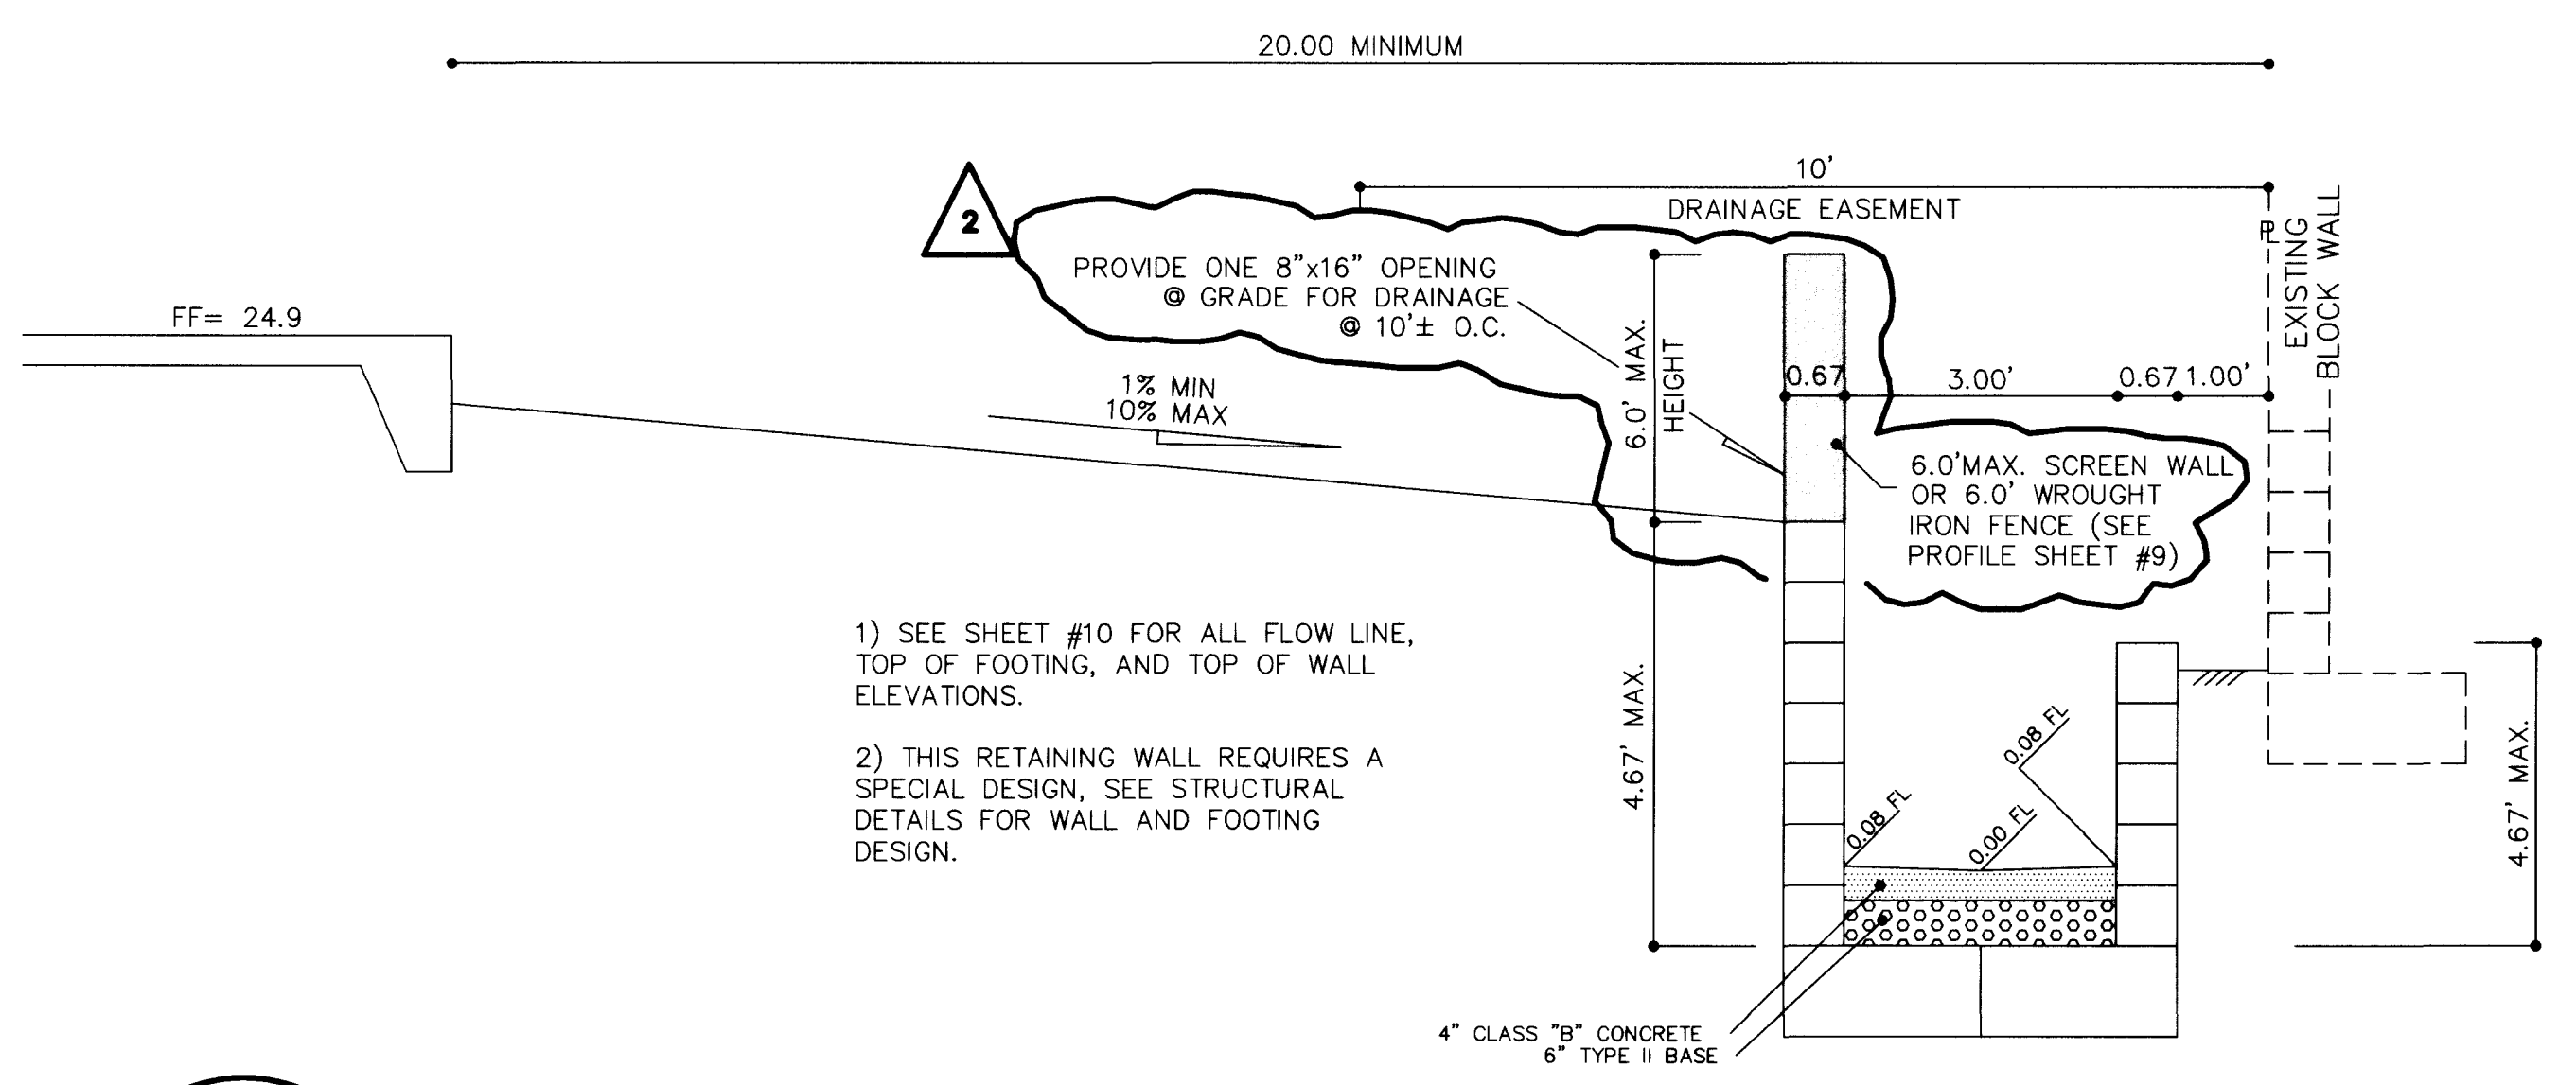

3  
6


SECTION

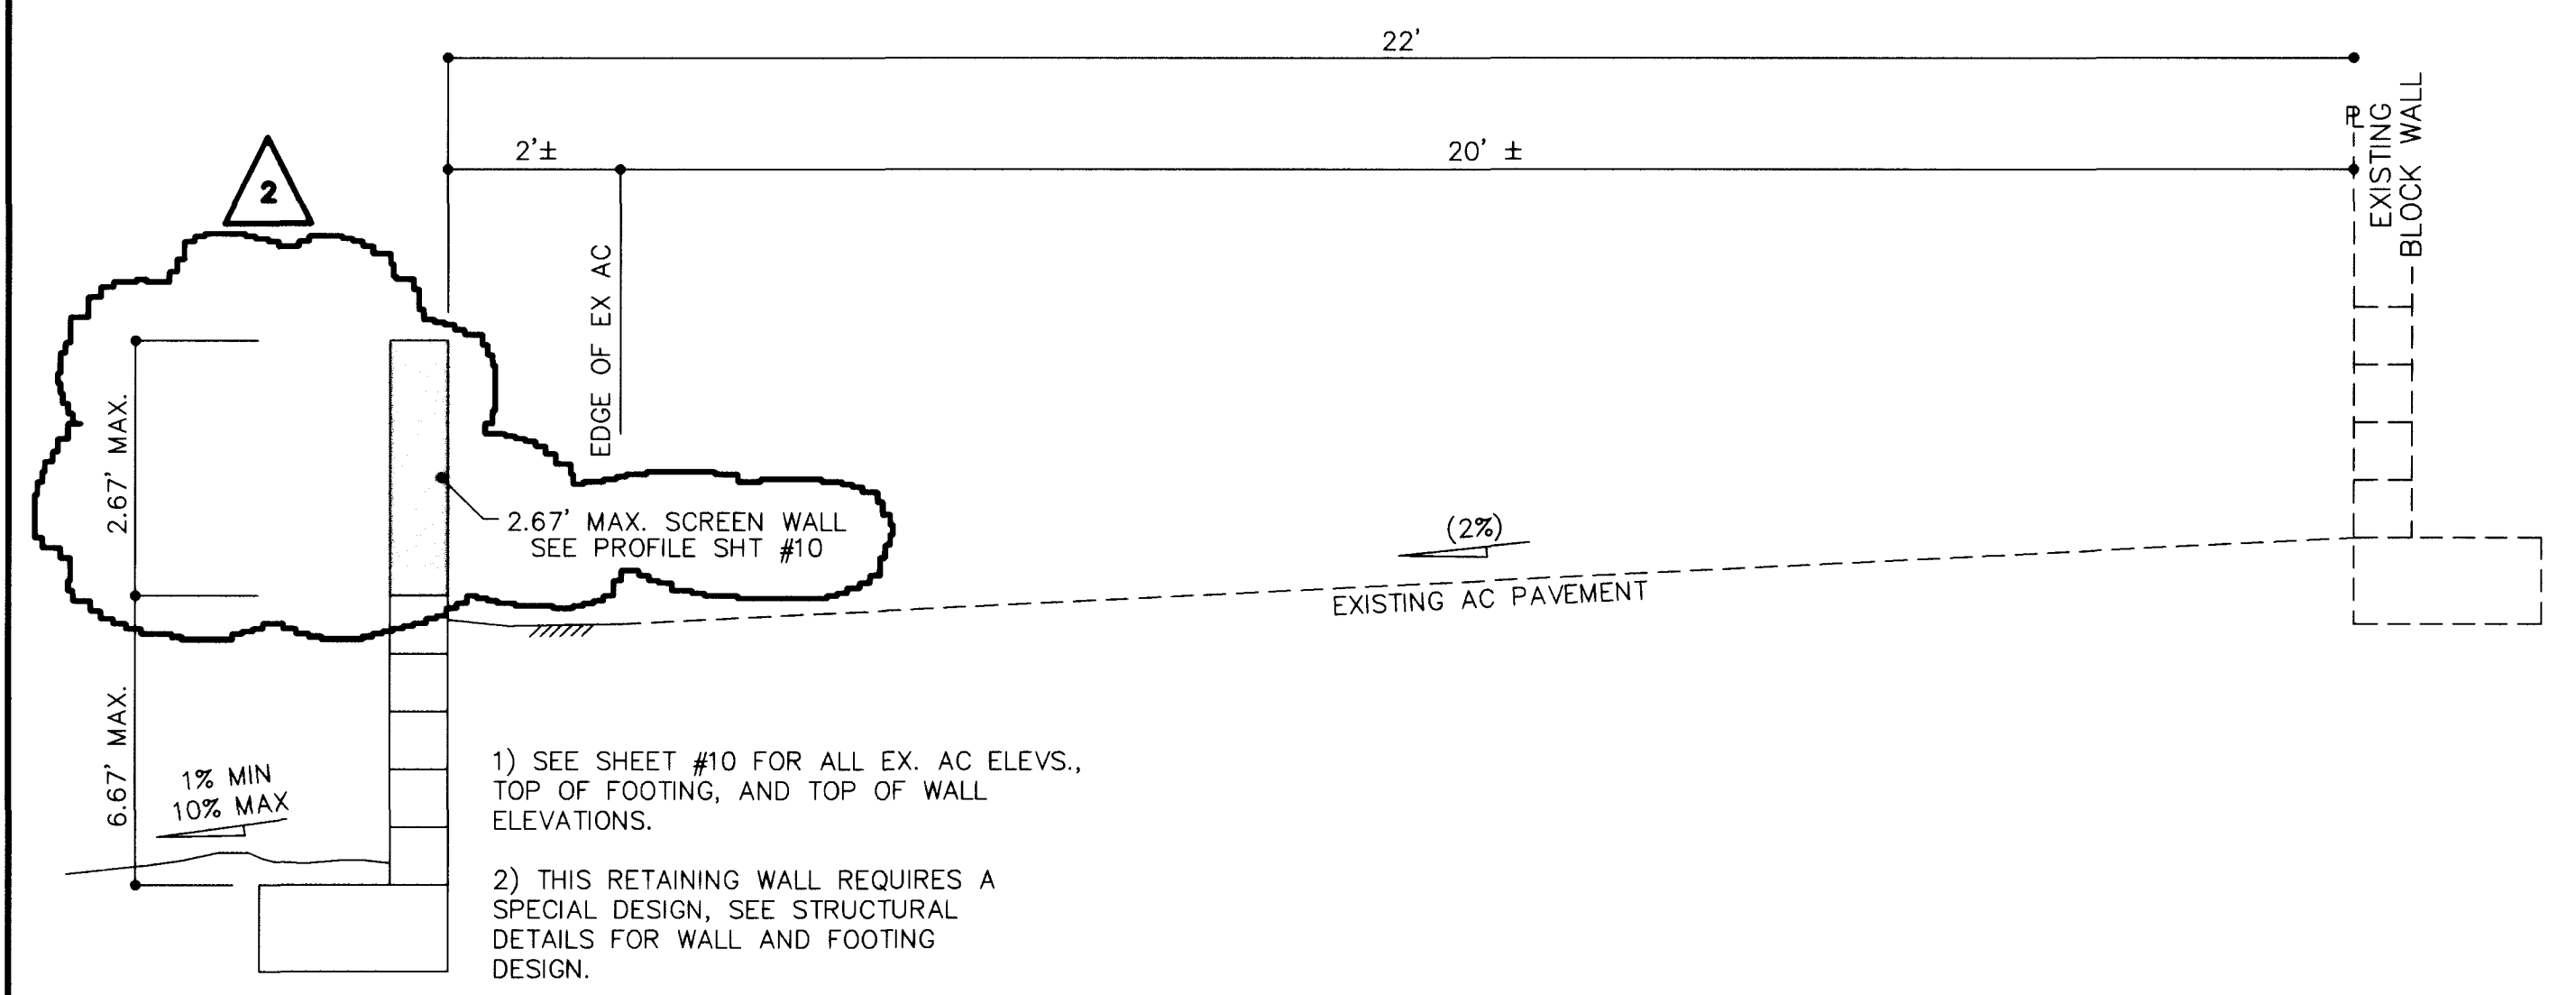

4  
6


SECTION

GALLAHER CONSTRUCTION, INC. 9066 BROOKS ROAD, SOUTH WINDSOR, CA, 95492 (707) 836-0473		DUNNAM CIVIL ENGINEERS 3305 SPRING MOUNTAIN ROAD SUITE 82 LAS VEGAS, NV 89102 (702) 367-0588 (702) 367-8145 FAX	
DETAIL SHEET		OAKMONT RETIREMENT COMMUNITY #4	
SHEET		TITLE	
DRAWN BY:		SCALE: 1" = 2'	
DESIGNED BY:		PROJECT NO: GALL 03C	
CHECKED BY:		SHEET	
PROJECT NO: GALL 03C		D1	
SHEET		12 OF 13 SHEETS	
DRAWING NO.		107-V2893	
GALL 03D1 1" = 2'		Re-plot	

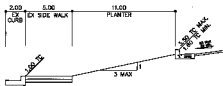


1  
6

SECTION

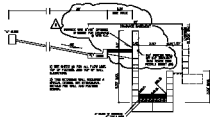


2  
6

SECTION

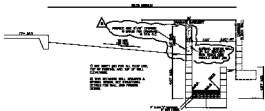

3  
6

SECTION

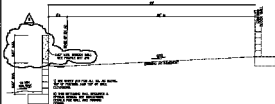

4  
6

SECTION

GALLAGHER CONSTRUCTION, INC.  
 1000 S. GARDEN ST. SUITE 100  
 GARDEN CITY, MISSOURI 64503  
 (816) 481-1111  
 FAX (816) 481-1112  
 WWW.GALLAGHERCONSTRUCTION.COM

DETAIL SHEET  
 THE CHAMBERS RESIDENTIAL  
 COMMUNITY #4

DATE: \_\_\_\_\_  
 DRAWN BY: \_\_\_\_\_  
 CHECKED BY: \_\_\_\_\_  
 REVISIONS: \_\_\_\_\_  
 SCALE: \_\_\_\_\_  
 SHEET NO. 4 OF 6