




STA 64+05.39 OAKLEY BLVD
STA 10+00 RAINBOW BLVD


CURVE TABLE • BACK OF CURB					SIDEWALK RAMP DIMENSIONS	
NUMBER	RADIUS	DELTA	TANGENT	LENGTH	'A'	'B'
①	25'	88°09'09"	24.20'	38.46'	4.5'	12.0'
②	15'	91°52'32"	15.50'	24.05'	8'	8'
③	25'	88°07'28"	14.52'	23.07'	12'	4.5'
④	24'	88°03'05"	23.19'	36.88'	8.0'	8.0'

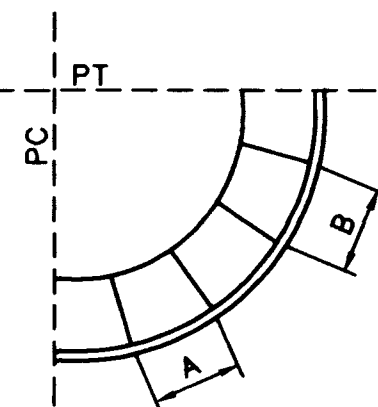

SIDEWALK RAMP
SEE TABLE FOR
TRANSITION LENGTHS


OAKLEY BOULEVARD

HORIZONTAL SCALE 1"=40'
VERTICAL SCALE 1"=10'

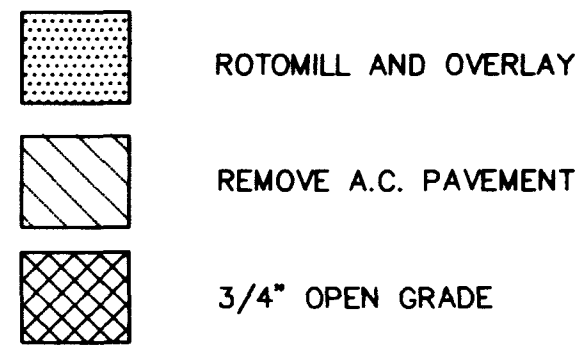


CONSTRUCTION NOTES


- ① CONSTRUCT ASPHALT CONCRETE PAVEMENT (SEE TYP. SECTION SHT. 4)
- ② CONSTRUCT TACK ON ISLAND (STD DWG NO. 220)
- ③ CONSTRUCT CONCRETE SIDEWALK (STD DWG NO. 234)
- ④ CONSTRUCT L-TYPE CURB AND GUTTER (STD DWG NO. 216)
- ⑤ CONSTRUCT SIDEWALK RAMP (STD DWG NO. 235)
- ⑥ CONSTRUCT CROSS GUTTER (STD DWG NO. 228)
- ⑦ CONSTRUCT RESIDENTIAL DRIVEWAY (STD DWG NO. 223)
- ⑧ CONSTRUCT COMMERCIAL DRIVEWAY
- ⑨ CONSTRUCT 8" DRIVEWAY TRANSITION (MATCH EXISTING SURFACE)
- ⑩ CONSTRUCT TRANSITION PAVEMENT 2" AC OVER 6" TYPE II AGG. BASE
- ⑪ CONSTRUCT RETAINING WALL
- ⑫ SAWCUT AND MATCH EXISTING
- ⑬ SET NEW SURVEY MONUMENT, TYPE I (STD DWG NO. 239)
- ⑭ SET NEW SURVEY MONUMENT, TYPE III (STD DWG NO. 241)
- ⑮ ADJUST EXISTING MANHOLE (STD DWG NO. 408)
- ⑯ ADJUST EXISTING WATER VALVE (STD DWG NO. 517)
- ⑰ REMOVE ASPHALT CONCRETE PAVEMENT
- ⑱ REMOVE L-TYPE CURB AND GUTTER
- ⑲ REMOVE CONCRETE SIDEWALK PC TO PT
- ⑳ REMOVE BLOCKWALL
- ㉑ REMOVE FENCE
- ㉒ REMOVE CROSS GUTTER
- ㉓ RELOCATE FIRE HYDRANT (MIN. 20' FROM CURB RETURN)
- ㉔ RELOCATE MAIL BOX
- ㉕ REMOVE TREE
- ㉖ NO CONSTRUCTION EASEMENT
- ㉗ RELOCATE WATER METER
- ㉘ RELOCATE STREET LIGHT (SEE TRAFFIC SHTS)
- ㉙ RELOCATE TRAFFIC SIGN (SEE TRAFFIC SHTS)
- ㉚ REMOVE & REPLACE CROSS GUTTER SPANDREL TO ACCOMMODATE NEW WHEELCHAIR RAMP
- ㉛ SAWCUT
- ㉜ SET NEW SURVEY MONUMENT TYPE II (STD DWG NO. 240)
- ㉝ ADJUST WATER METER
- ㉞ CONSTRUCT TRANSITION PAVEMENT 4" AC OVER 6" TYPE II AGG. BASE FROM END OF RETURN
- ㉟ TEMPORARY CONSTRUCTION EASEMENT
- ㊱ NEW INLET - SEE STORM DRAIN SHEET
- ㊲ RELOCATE FENCE TO NEW R/W
- ㊳ REMOVE PLANTER WALL
- ㊴ RECONSTRUCT BLOCK WALL
- ㊵ CONSTRUCT 3'x5' BUS STOP PAD (STD DWG #234)
- ㊶ EXIST POWER POLE TO BE RELOCATED BY NEVADA POWER
- ㊷ REMOVE/RECONSTRUCT BLOCK WALL - W/ WROUGHT-IRON ORNAMENT
- ㊸ INSTALL 6" WATER LINE INCLUDING 8" X 6" TAPPING TEE AND 6" VALVE
- ㊹ INSTALL 4" SEWER SERVICE WITH INVERT AT 4' BELOW GRADE AT PROPERTY LINE.

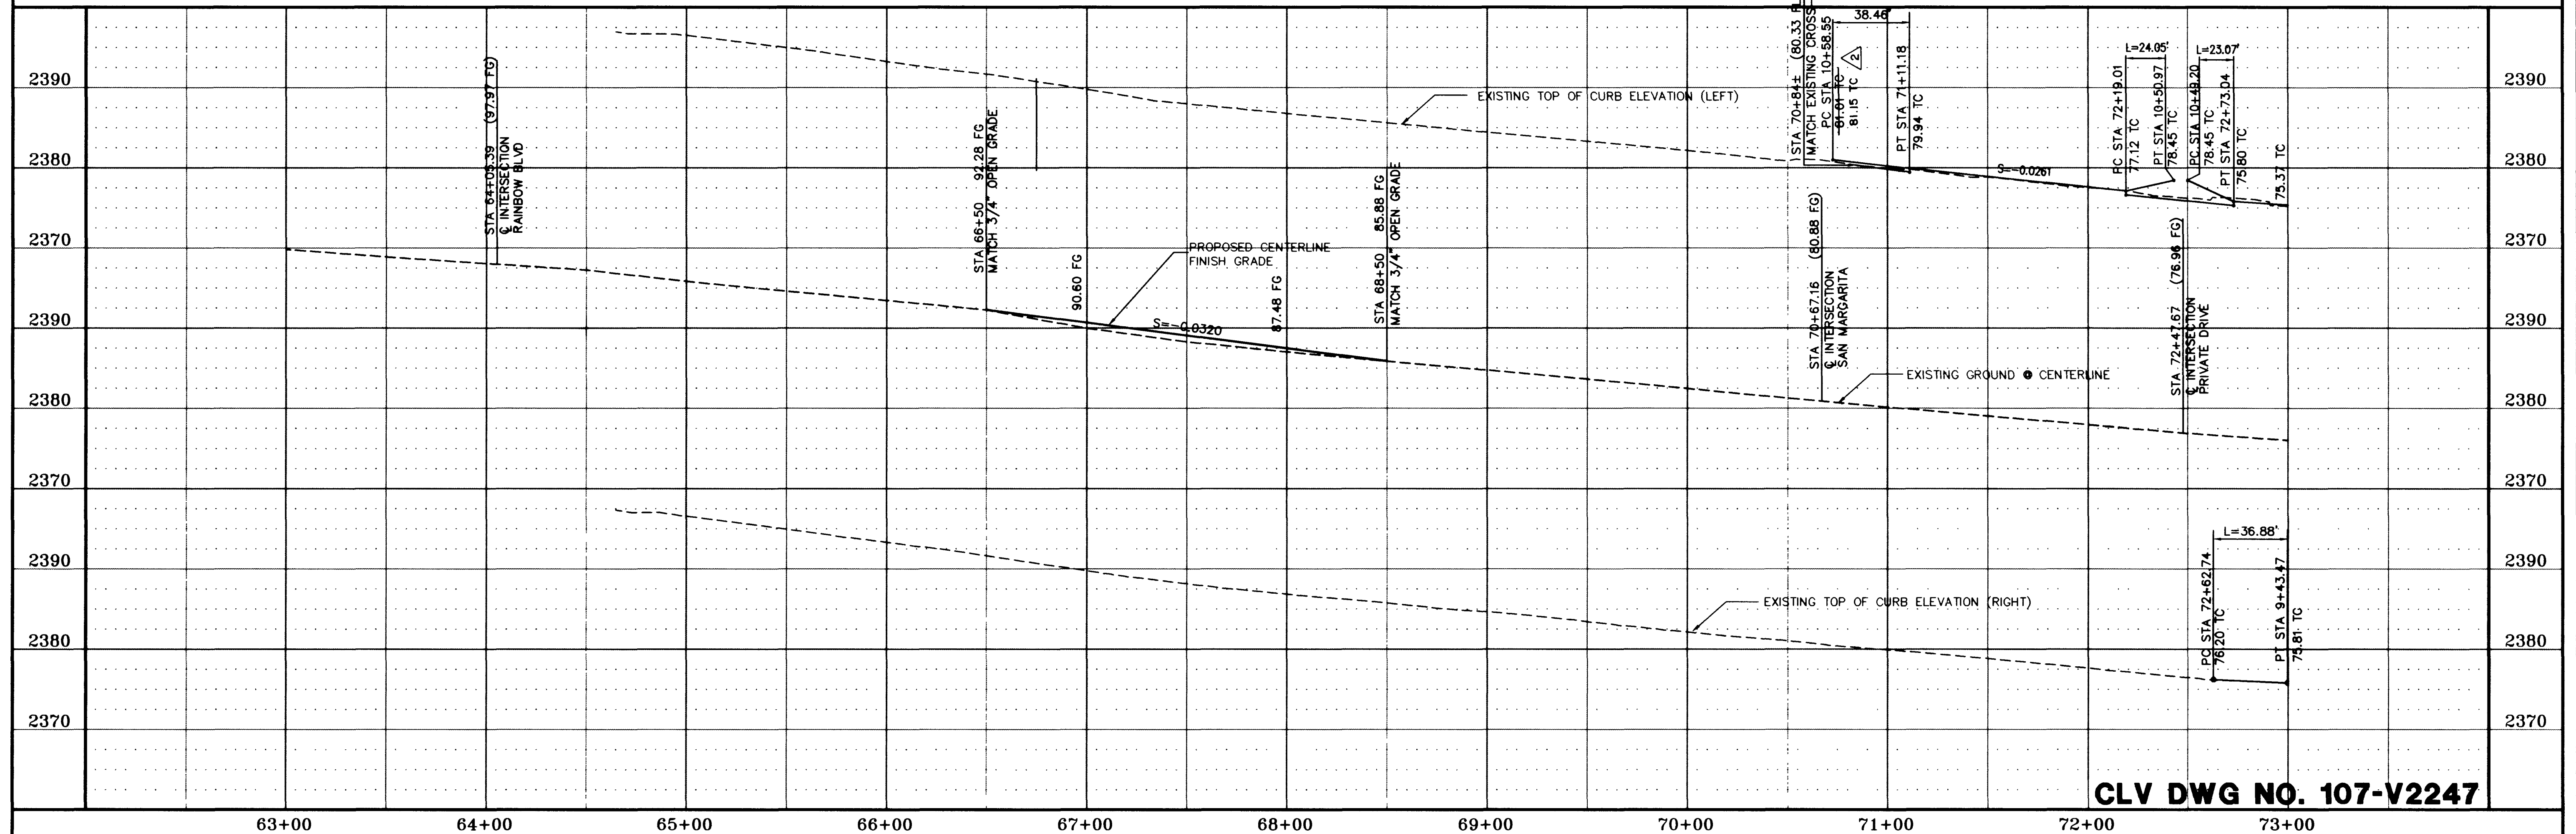

CLV DWG NO. 107-V2247

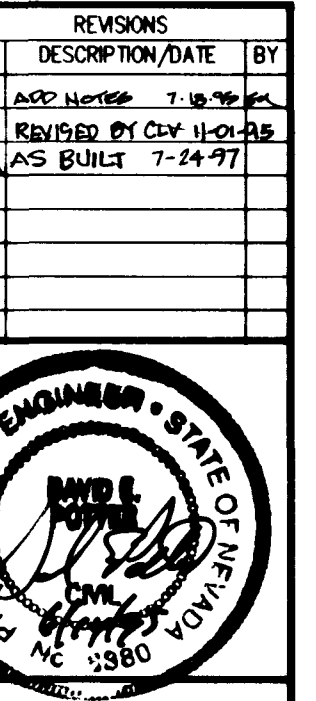

1100 GRIER DRIVE
LAS VEGAS, NEVADA 89119
PHONE (702) 361-9050
FAX (702) 361-0659

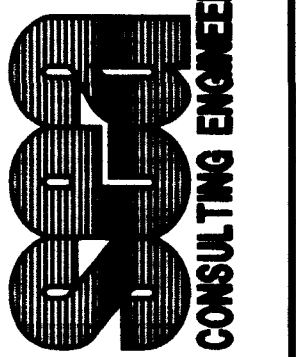

CLARK COUNTY
ENGINEERS

ROADWAY PLAN AND PROFILE
FROM STA. 63+00 TO STA. 73+00
OAKLEY BOULEVARD
RAINBOW BLVD. TO DECATUR BLVD.

JOB NO. 2-241-073
ACAD FILE: OAKEPP01
DESIGNED: DP
DRAWN: GJV/TL
CHECKED: DP
DATE: JUNE 1995

C1

9 OF 62 SHEETS

AS BUILT

18-558

