

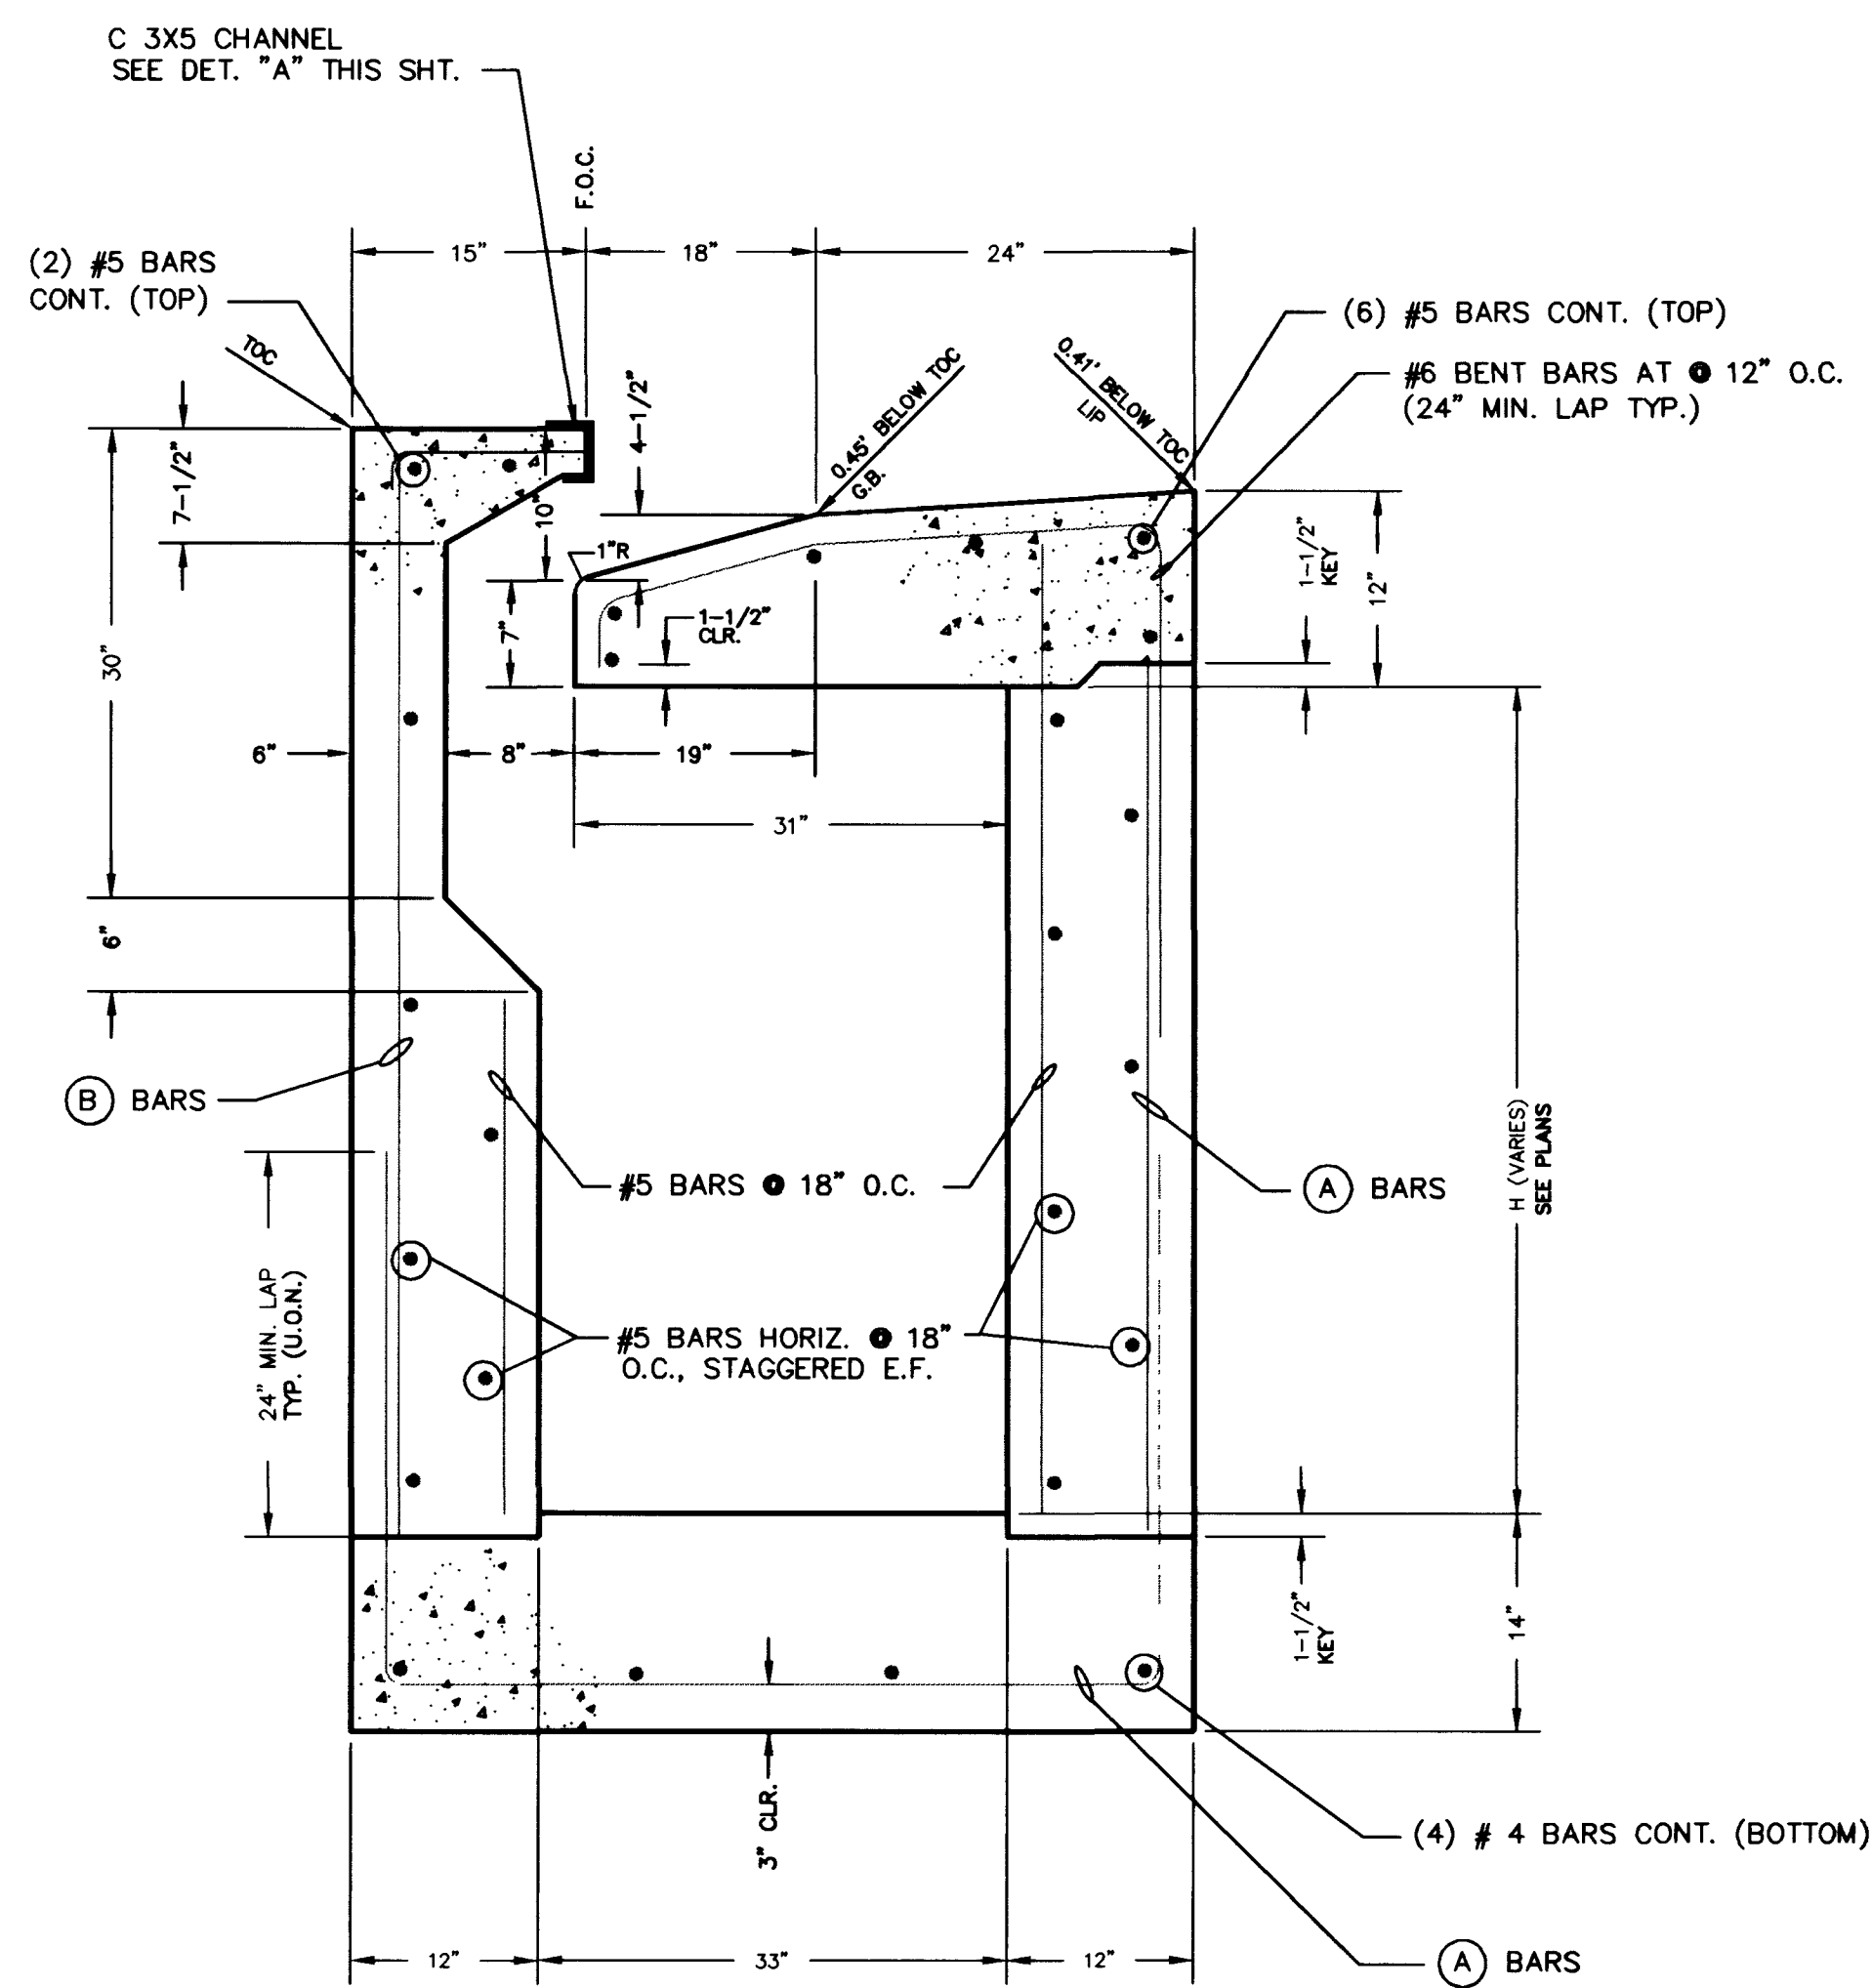
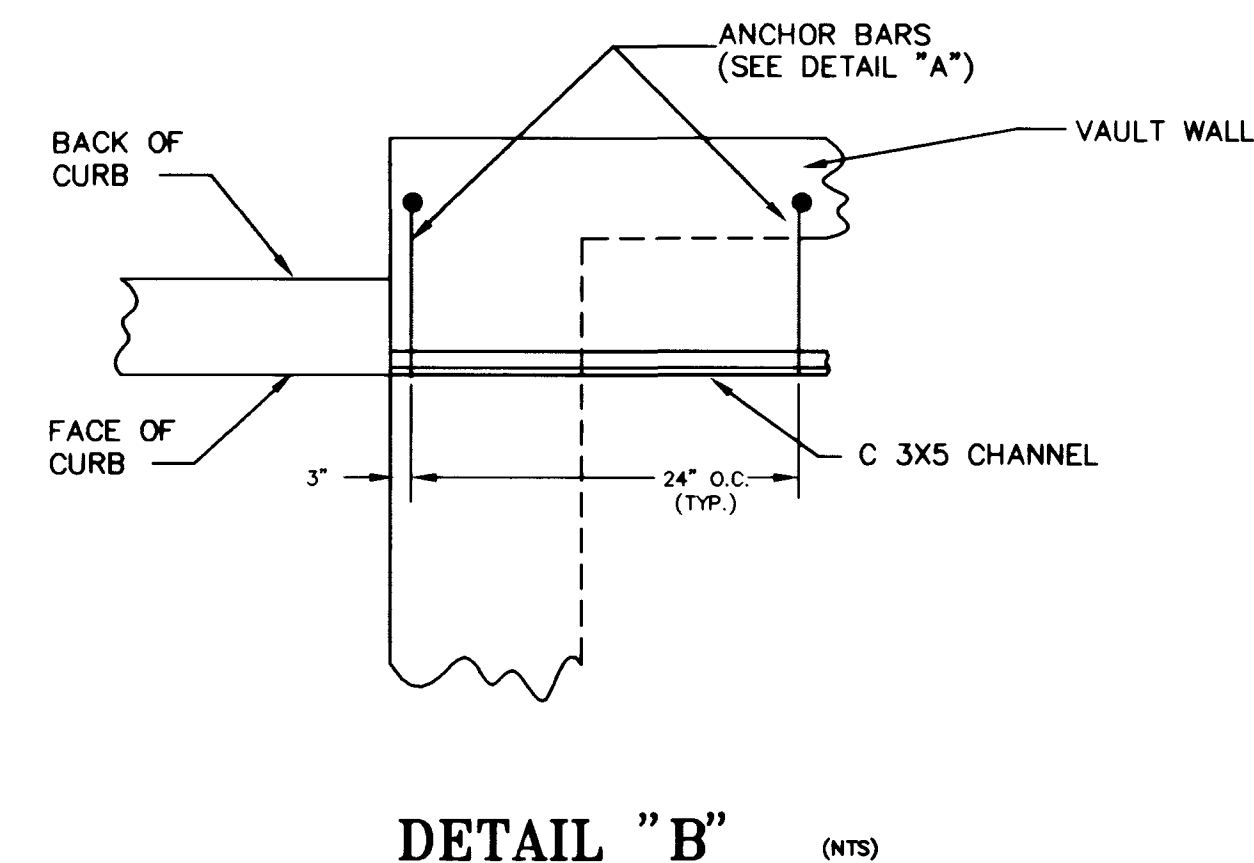


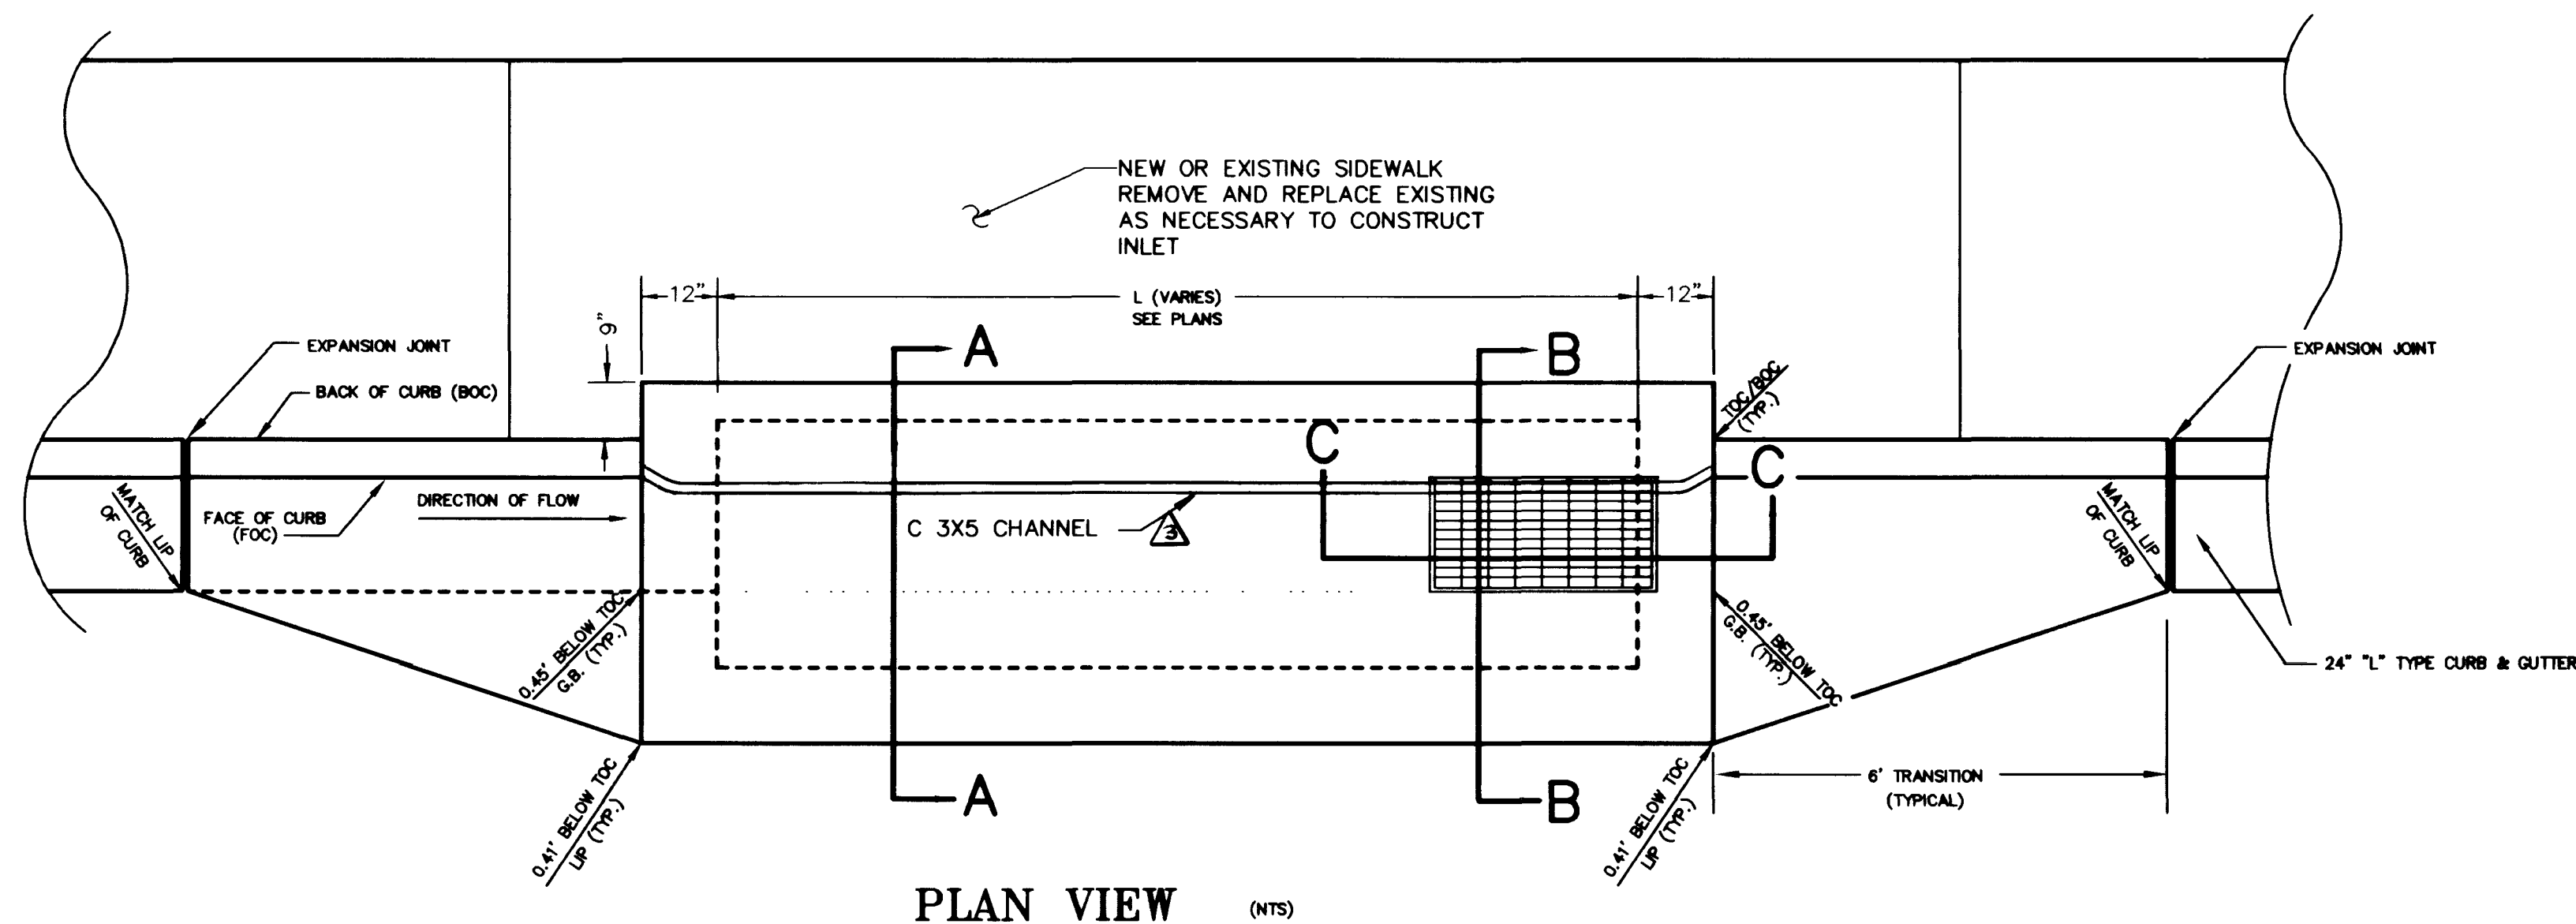


H (max)	(A) BARS	(B) BARS
4'-0"	#6 @ 12" O.C.	#5 @ 18" O.C.
6'-0"	#6 @ 10" O.C.	#5 @ 18" O.C.
8'-0"	#6 @ 6" O.C.	#5 @ 18" O.C.
10'-0"	#6 @ 5" O.C.	#5 @ 10" O.C.


SECTION A-A (NTS)

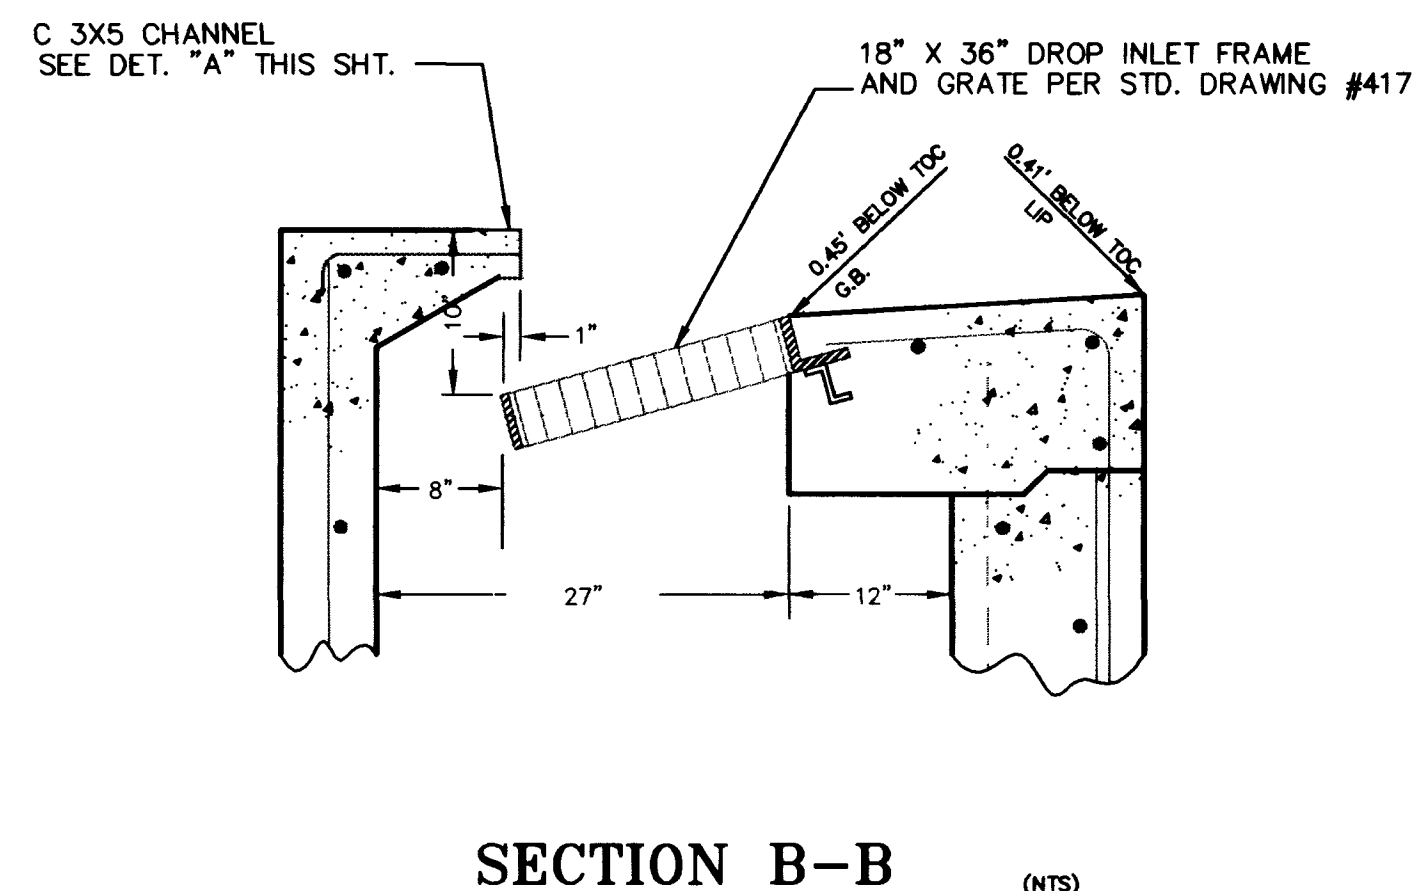

SECTION B-B (NTS)

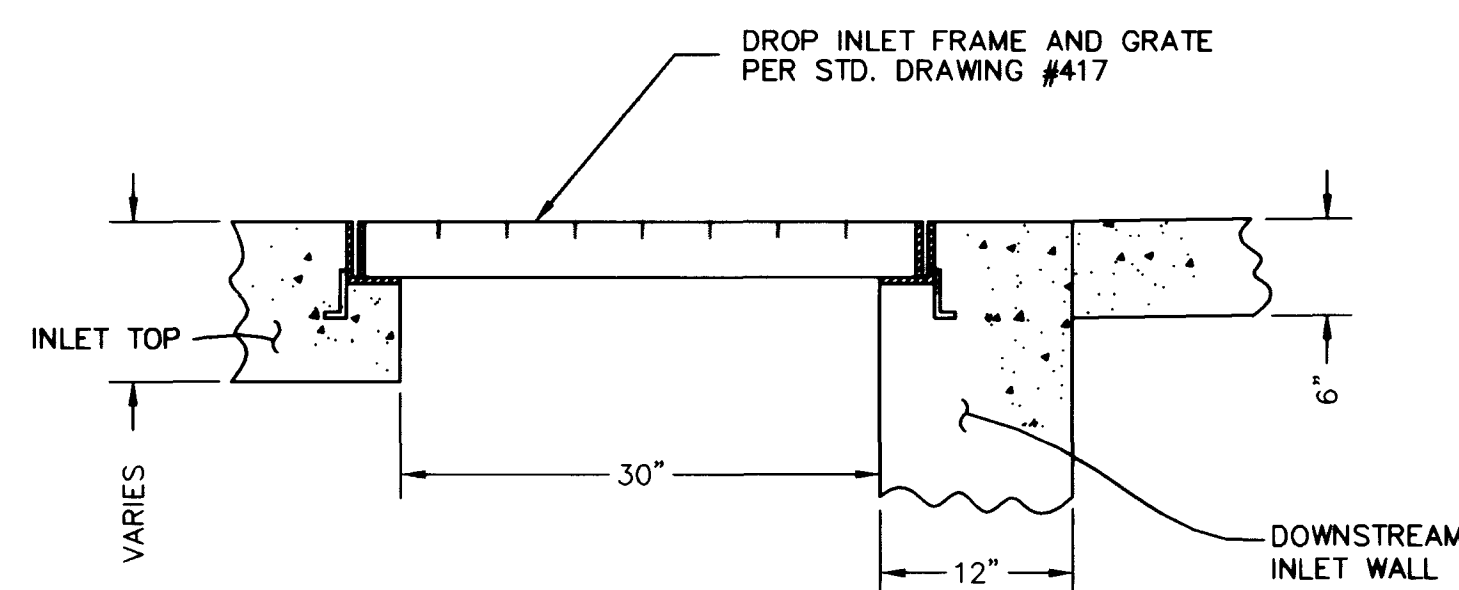

SECTION C-C (NTS)

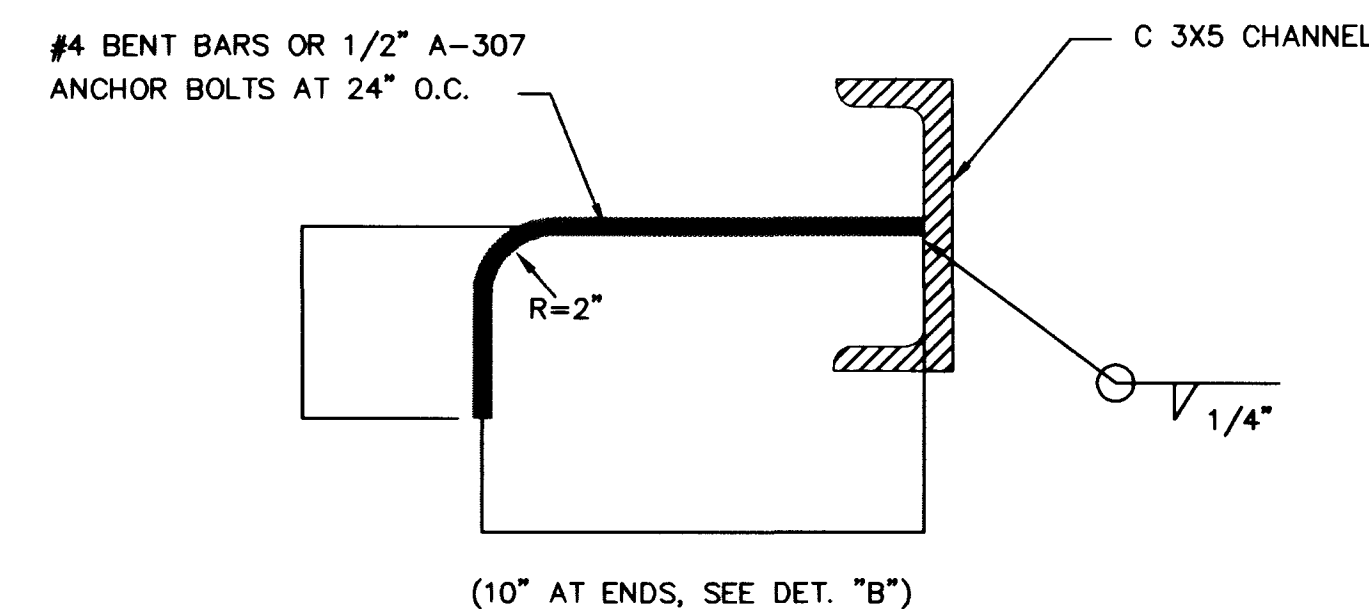

DETAIL "A" (NTS)

NOTES:

ALL REBAR SHALL HAVE 2-1/2" COVER UNLESS OTHERWISE NOTED

ALL CONCRETE SHALL BE CLASS D OR DA (MIN. 3000 psi AT 28 DAYS)

SEE PLANS FOR LENGTH (L) AND DEPTH (H) OF EACH INLET

SEE PLANS FOR SIZE AND LOCATION OF OUTLET PIPE

ALL EXPOSED STEEL SHALL BE HOT DIPPED GALVANIZED, INCLUDING FRAME AND GRATE.

ALL DAMAGED GALVANIZED STEEL SHALL BE PAINTED WITH A MINIMUM 3.5 MIL. COAT OF ONE OF THE FOLLOWING ZINC RICH PAINTS:
GALVANOX TYPE I
LPS COLD GALVANIZE
SHERWIN-WILLIAMS "ZINC CLAD I"


ALL REBAR SHALL BE GRADE 60

ALL STRUCTURAL STEEL SHALL BE A36


ALL ANCHOR BOLTS SHALL BE A-307

BEDDING FOR DROP INLET SHALL BE 6" MIN. OF TYPE II AGGREGATE BASE COMPACTED TO 95% MAXIMUM DENSITY PER ASTM D1557

NO	REVISIONS	DESCRIPTION/DATE	BY
1	REVISED BY CLV 11-06-95		
2	AS BUILT 7-24-97		

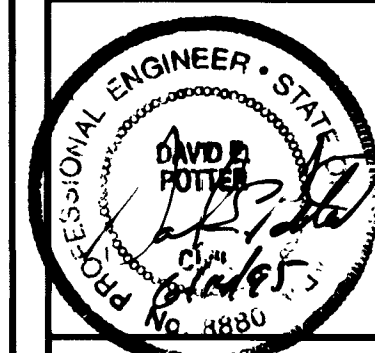

1100 GRIER DRIVE
LAS VEGAS, NEVADA 89119
PHONE (702) 361-9050
FAX (702) 361-0669

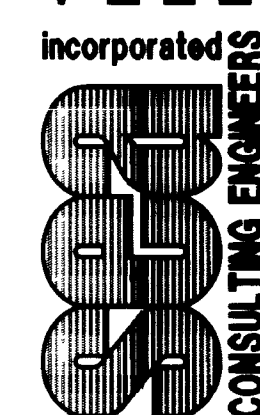

NEVADA

DETAIL SHEET
DROP INLET-TYPE 'A' MODIFIED
OAKLEY BOULEVARD
RAINBOW BLVD. TO DECATUR BLVD.

CLARK COUNTY

CITY OF LAS VEGAS

JOB NO.:	2-241-073
ACAD FILE:	OAKEDT01
DESIGNED:	RHS
DRAWN:	TL
CHECKED:	DP
DATE:	JUNE 1995




D1

7 OF 62 SHEETS

CLV DWG NO. 107-V2247


AS BUILT

16 5-56

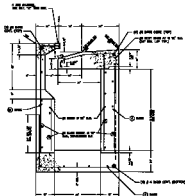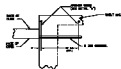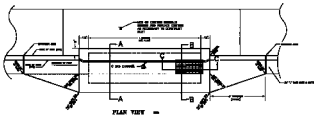


1. 問題	2. 結果	3. 考察
1-1	100% 合格	100% 合格
1-2	100% 合格	100% 合格
1-3	100% 合格	100% 合格
1-4	100% 合格	100% 合格


SECTION A-A —

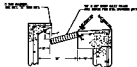

SECTION B-B

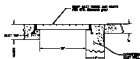

SECTION C-C 1

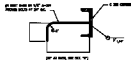

ИТАЛИЯ "А" —

NOTES:

- [illegible]

- ALL OTHERS HAVE TO STAY ON
ALL INFORMATION FROM BUREAU ON AIR
ALL PERSONS HAVE TO STAY ON A-100
REMARKS FOR THIS MESSAGE IS 27 MAY OF TYPE 1 MESSAGE HAVE
APPROVED TO BE CLOSURE NUMBER FOR JUNE 1960

CLY DWG NO. 107-V2247

AS NOTED



1530

LEADS TO
CROSSING
TO BE
TO BE

DET
MAY 1964
U.S. DEPT. OF JUSTICE

A.B. JENSEN
JENSEN & COMPANY
JENSEN & COMPANY
JENSEN & COMPANY
JENSEN & COMPANY

D1

16 2-57