




12-5-109

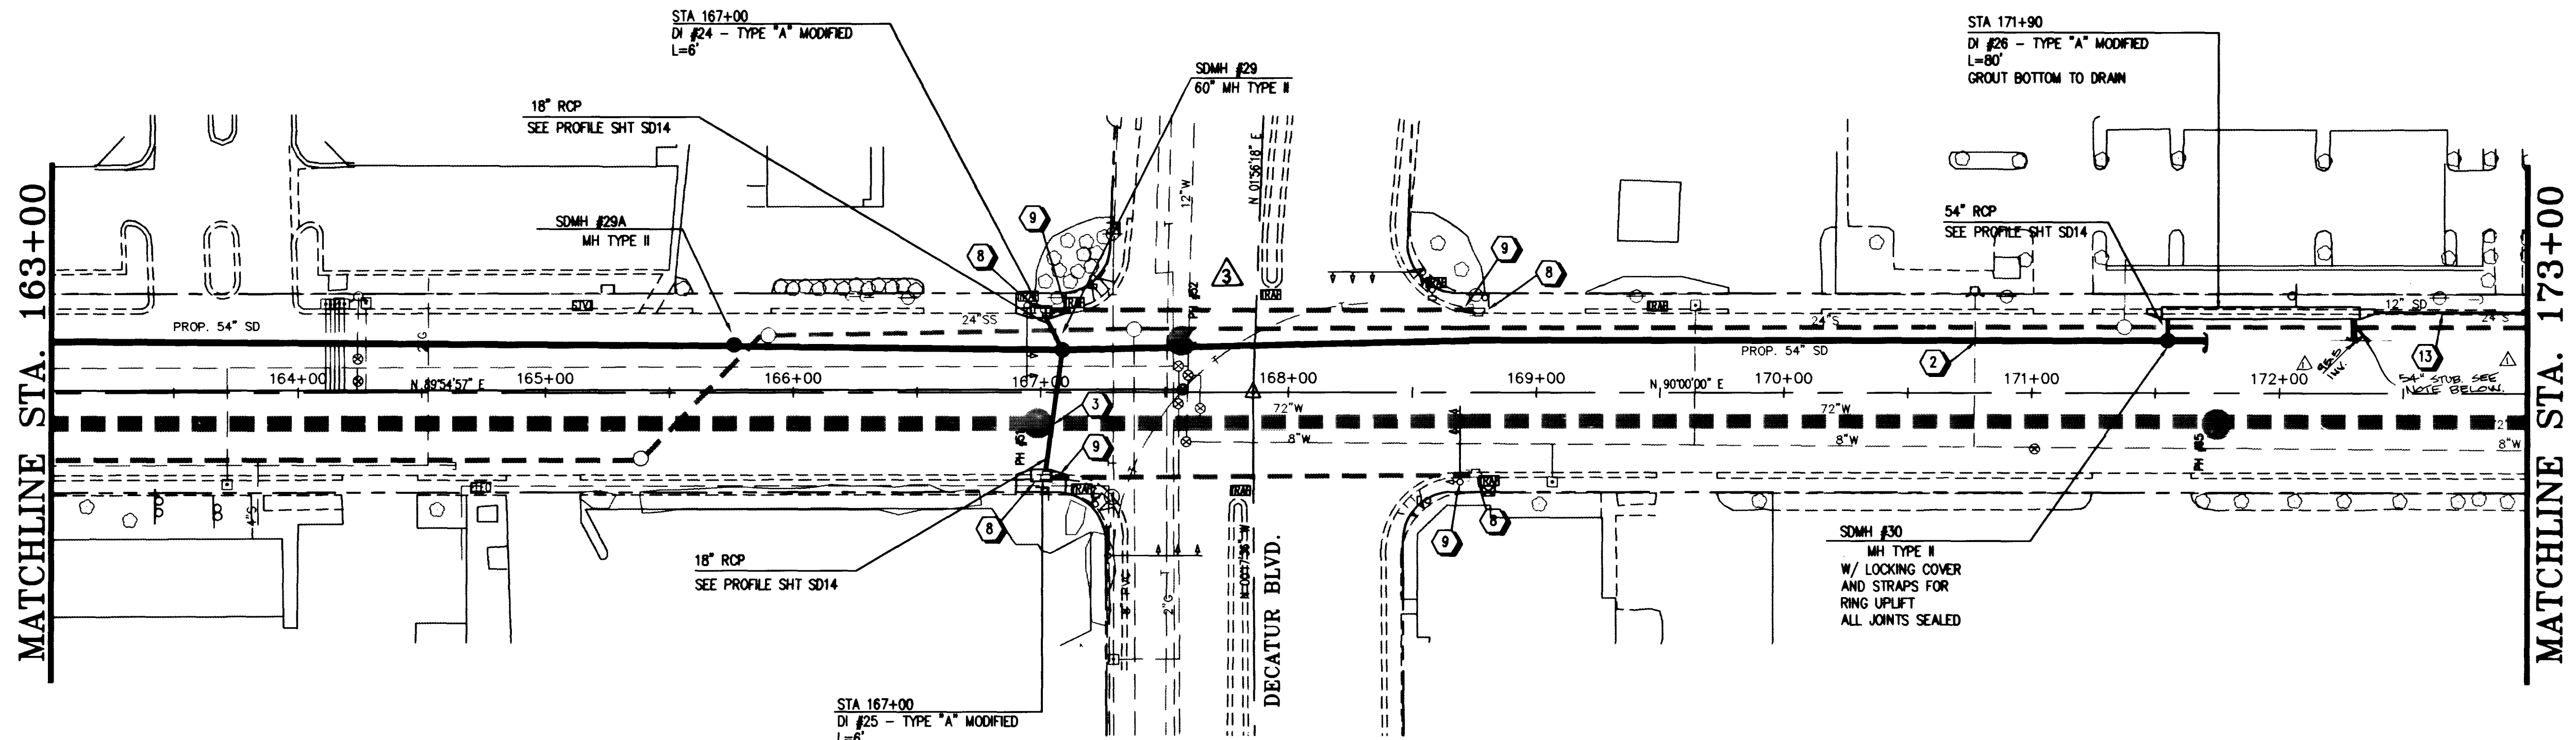

33


1. The first step is to identify the problem or question that needs to be answered. This involves understanding the context and the specific requirements of the task.



DAKEY, HENRYAND
 1924 FEB 22

- | SOLUTIONS/ANSWERS | |
|---|--|
| 1. The answer is 100 . The number of the following numbers: 100, 200, 300, 59000, | |

Call
before you
Die.

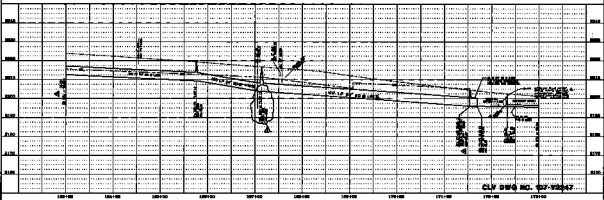

AS BUILT

14-5-109