


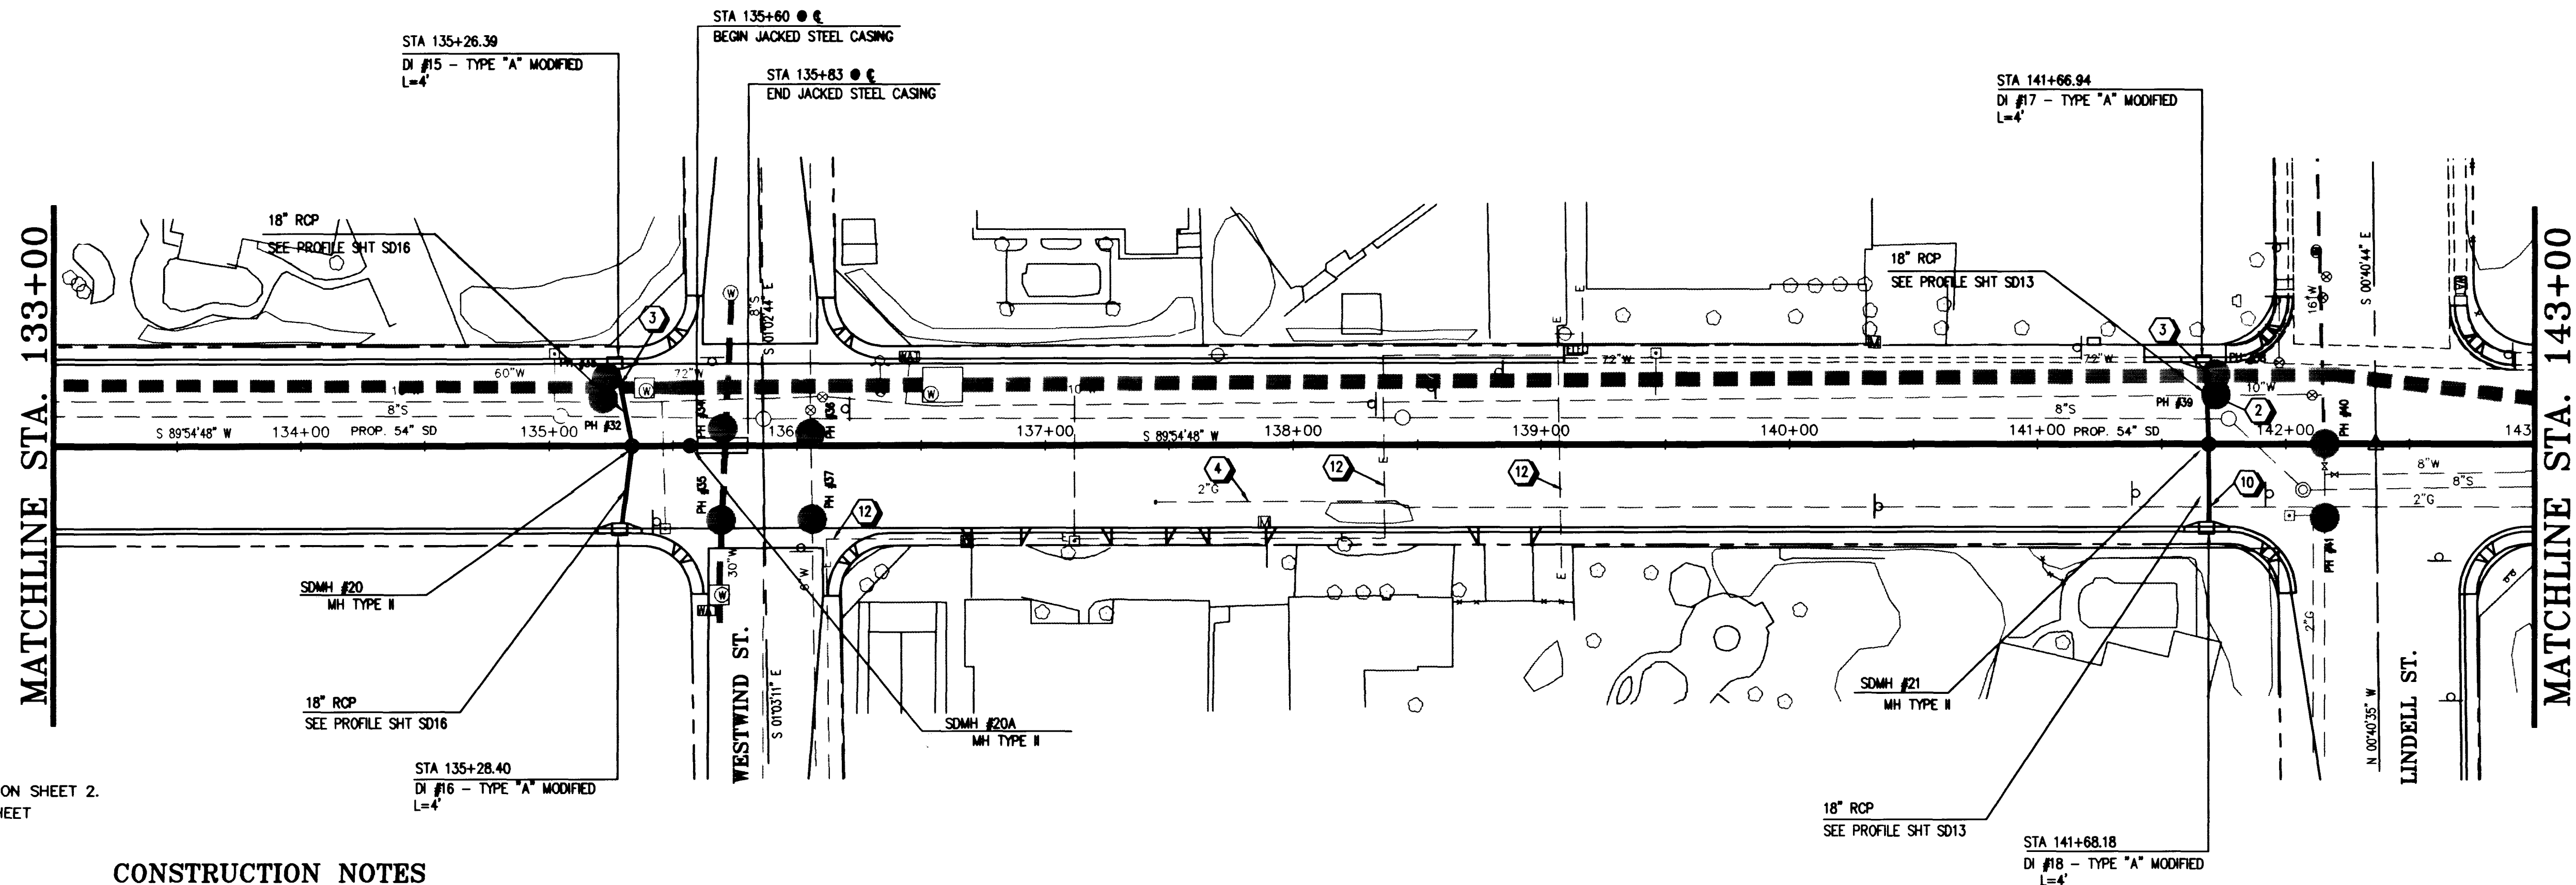

NOTE:
1. REFERENCE POTHOLE TABLE ON SHEET 2.
2. SEE CORRESPONDING S.S. SHEET


CONSTRUCTION NOTES

- ① SEE SANITARY SEWER (SS) SHEETS FOR WATERLINE RELOCATION.
- ② DEPRESS WATERLINE. SEE DETAIL SHEET D2.
- ③ ENCASE SD WITH 4" MIN. CONCRETE ENCASMENT TO 10" MIN. EACH SIDE OF WATERLINE. -SEE SHEET D2-
- ④ SEE SANITARY SEWER (SS) SHEETS FOR GAS RELOCATION BY SW. GAS.
- ⑤ PLUG AND ABANDON STORM SEWER.
- ⑥ 2" GAS LINE TO BE RELOCATED BY S/W GAS CORP FROM APPROXIMATELY STA 66+45 TO 76+25, STA 101+00 TO STA 101+60, STA 109+70 TO STA 110+30 AND STA 115+30 TO STA 115+90.
- ⑦ CONNECT TO EXISTING MANHOLE (NO EXISTING STUBOUT) RECONSTRUCT MANHOLE AS REQUIRED.
- ⑧ REMOVE EXISTING INLET.
- ⑨ PLUG AND CAP EXISTING CULVERT.
- ⑩ RELOCATE WATER SERVICE LATERAL:
A. IF POLYETHYLENE, REMOVE AND REPLACE PER SPEC'S
B. IF COPPER, REPAIR AND ADJUST
- ⑪ REMOVE & REPLACE L-TYPE CURB & GUTTER (STD. DWG. NO.216)
- ⑫ CAUTION: THESE ARE ENERGIZED CABLES. A NPC QUALIFIED REPRESENTATIVE MUST BE PRESENT DURING CONSTRUCTION IN OR AROUND THIS EQUIPMENT. CALL 657-4117 FOR AN APPOINTMENT 48 HOURS PRIOR.

OAKLEY BOULEVARD

HORIZONTAL SCALE 1"=40'
VERTICAL SCALE 1"=10'

Call
before you
Dig.
1-800-227-2800

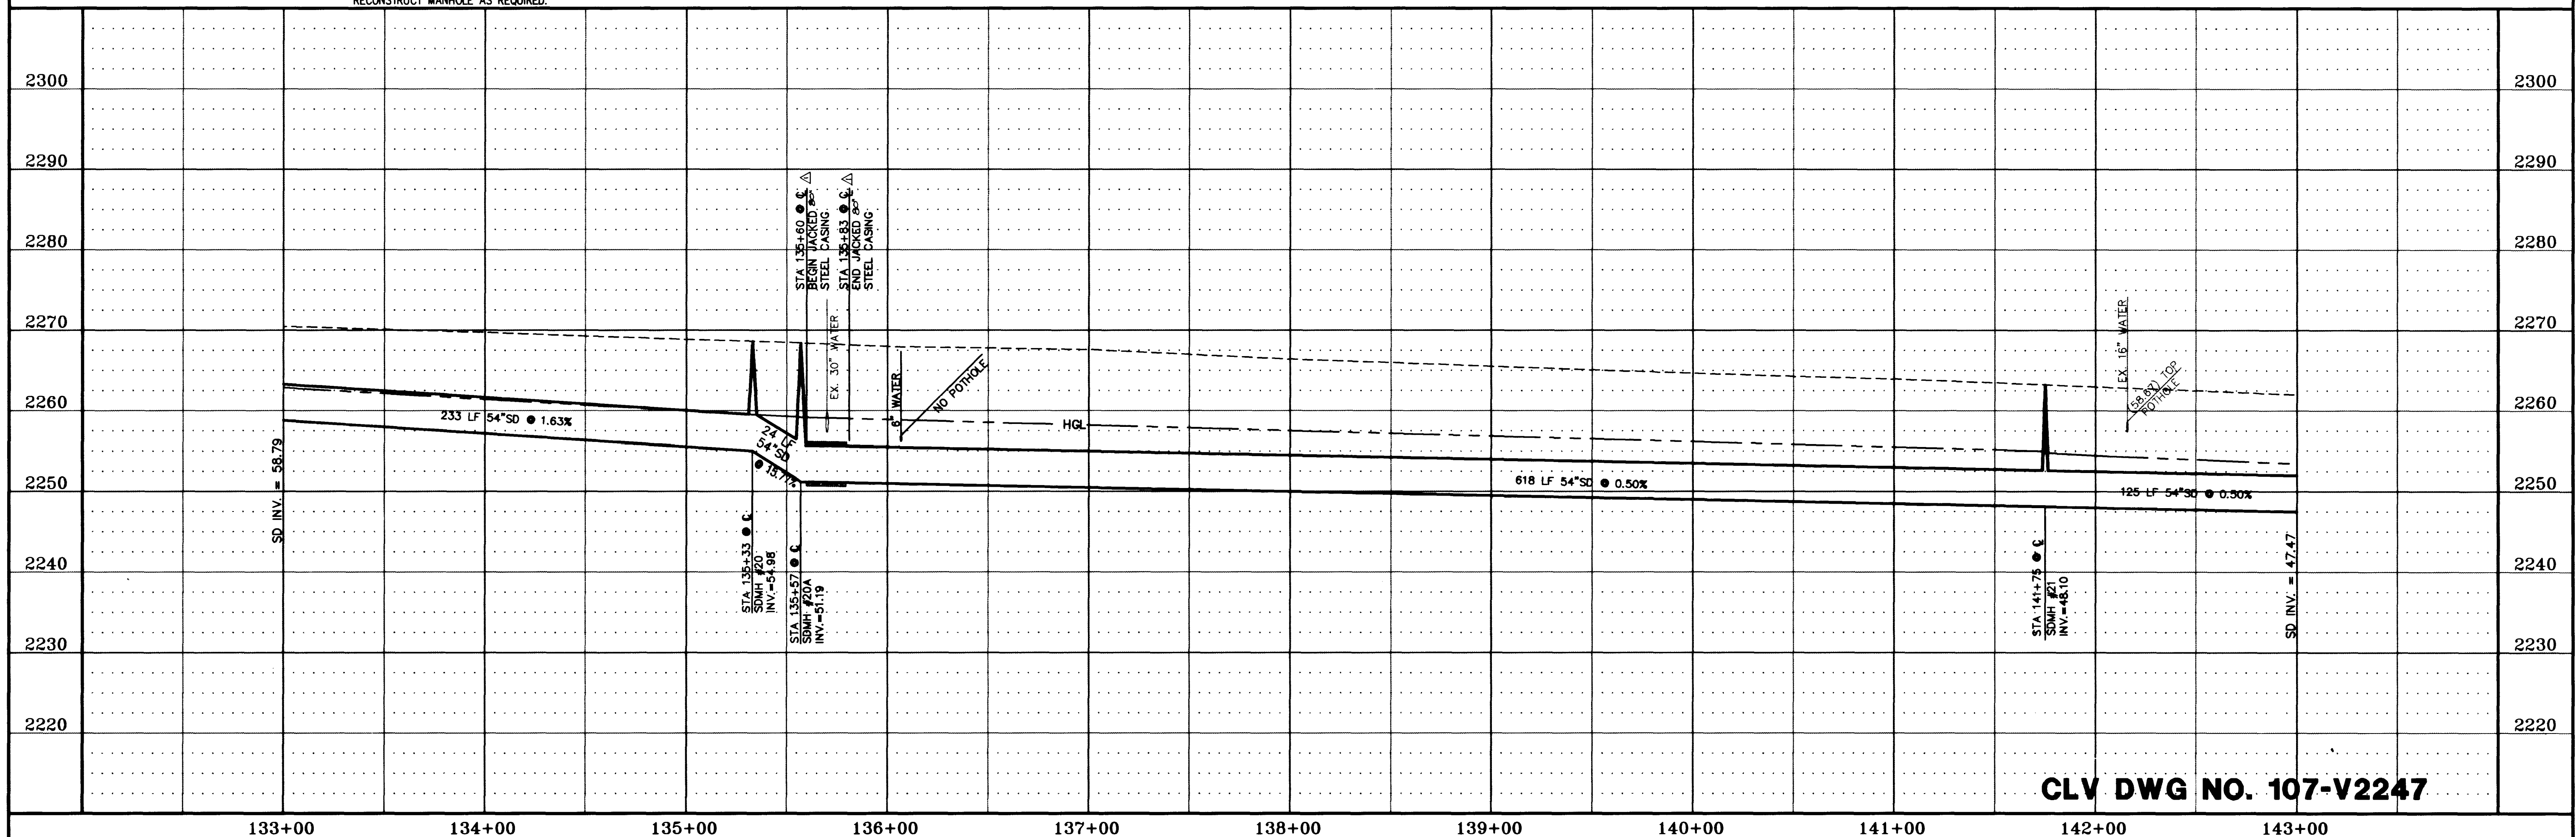

CLV DWG NO. 107-V2247

AS BUILT

REVISIONS
NO. DESCRIPTION/DATE BY
1. 06/15/95
2. 06/15/95
754. 06/15



CONSTITUTION SYSTEM

- 1) THE CONSTITUTION STATES THAT INDIVIDUALS ENJOY CERTAIN RIGHTS.
- 2) CONSTITUTIONAL AND SOCIAL CHARTER
- 3) RIGHTS TO LIFE, LIBERTY, AND PROPERTY, RIGHT TO EQUALITY, RIGHT TO FREEDOM OF SPEECH, AND OTHERS.
- 4) THE CONSTITUTION STATES THAT INDIVIDUALS HAVE CERTAIN RIGHTS AND DUTIES.
- 5) RIGHTS AND FREEDOMS HAVE LIMITS.
- 6) IF YOU WANT TO ENJOY THEM YOU MUST FOLLOW CERTAIN LAWS.
- 7) RIGHTS ARE NOT ABSOLUTE, BUT SUBJECT TO THE LAWS OF THE LAND.
- 8) RIGHTS ARE NOT SUBJECT TO THE LAWS OF THE LAND.
- 9) RIGHTS ARE NOT SUBJECT TO THE LAWS OF THE LAND.

[illegible]

SPERMATOPHYTES	GLASS	72-60
SPERMATOPHYTES	GLASS	72-60

**Call
1-800-445-2439**

[illegible]

STORM DRAIN PLAN AND PROFILE
FROM STA. 280+00 TO STA. 284+00
SHEET 02 OF 10
BAMBOO BLVD. TO DECATUR BLVD.

SDG

AS BUILT

12-5 July 1964