


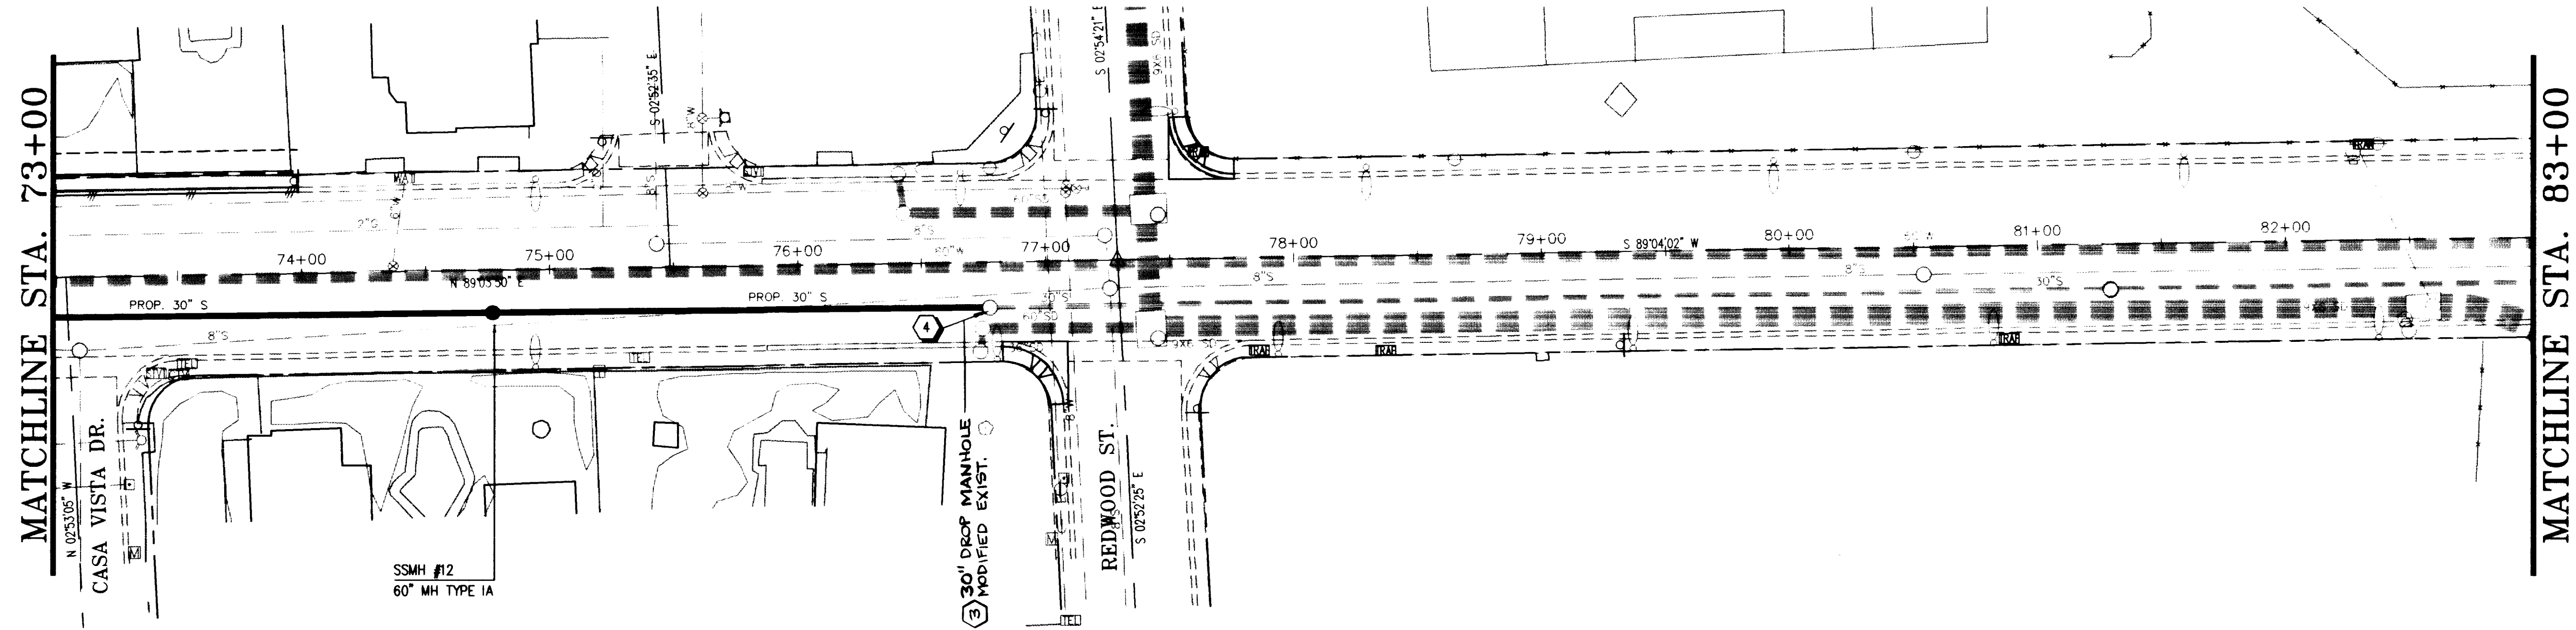

NOTE:
1. REFERENCE POTHOLE TABLE ON SHEET 2.


OAKLEY BOULEVARD

HORIZONTAL SCALE 1"=40'
VERTICAL SCALE 1"=10'

CONSTRUCTION NOTES


- ① RELOCATE WATER SERVICE LATERAL:
A. IF POLYETHYLENE, REMOVE AND REPLACE PER SPEC'S
B. IF COPPER, REPAIR AND ADJUST
- ② ENCASE SANITARY SEWER WITH 4" MIN. CONC. ENCASEMENT TO 10 FT. MIN. EACH SIDE FROM WATERLINE. SEE SHEET D2.
- ③ DEPRESS WATERLINE. SEE DETAIL SHEET D2
- ④ CONNECT TO EXISTING MANHOLE (NO EXISTING STUBOUT) RECONSTRUCT MANHOLE AS REQUIRED.
- ⑤ ABANDON WATERLINE AND APPURTENANCES
- ⑥ RELOCATE 8" WATERLINE TO 30' RT. STA. 90+63 TO STA 94+90
- ⑦ ATTACH EXISTING FIRE HYDRANT TO NEW VALVE
- ⑧ NEW VALVE
- ⑨ CONNECT TO EXISTING WATERLINE
- ⑩ RELOCATE 10" WATERLINE TO 10' RT. STA 116+10 TO STA 122+95
- ⑪ CONNECT EXISTING SERVICE LATERALS TO NEW WATERLINE
- ⑫ GAS RELOCATION BY SW GAS APPROX. STA 116+80 TO STA 161+70 AND STA 164+60 TO STA 167+80
- ⑬ RELOCATE 8" WATERLINE TO 1' LT. STA 161+40 TO STA 167+60
- ⑭ CONNECT EXISTING 6" FIRE HYDRANT LINE TO NEW WATERLINE
- ⑮ CAP AND PLUG
- ⑯ CONCRETE ENCASE ELEC, TELE, OR CATV CONDUITS PER UTILITY CO. STANDARD IF LESS THAN 18" CLEARANCE
- ⑰ CAUTION: THESE ARE ENERGIZED CABLES. A NPC QUALIFIED REPRESENTATIVE MUST BE PRESENT DURING CONSTRUCTION IN OR AROUND THIS EQUIPMENT. CALL 657-4117 FOR AN APPOINTMENT 48 HOURS PRIOR.

Call
before you
Dig.
1-800-227-2600
UNDERGROUND SERVICE ALERT (USA)

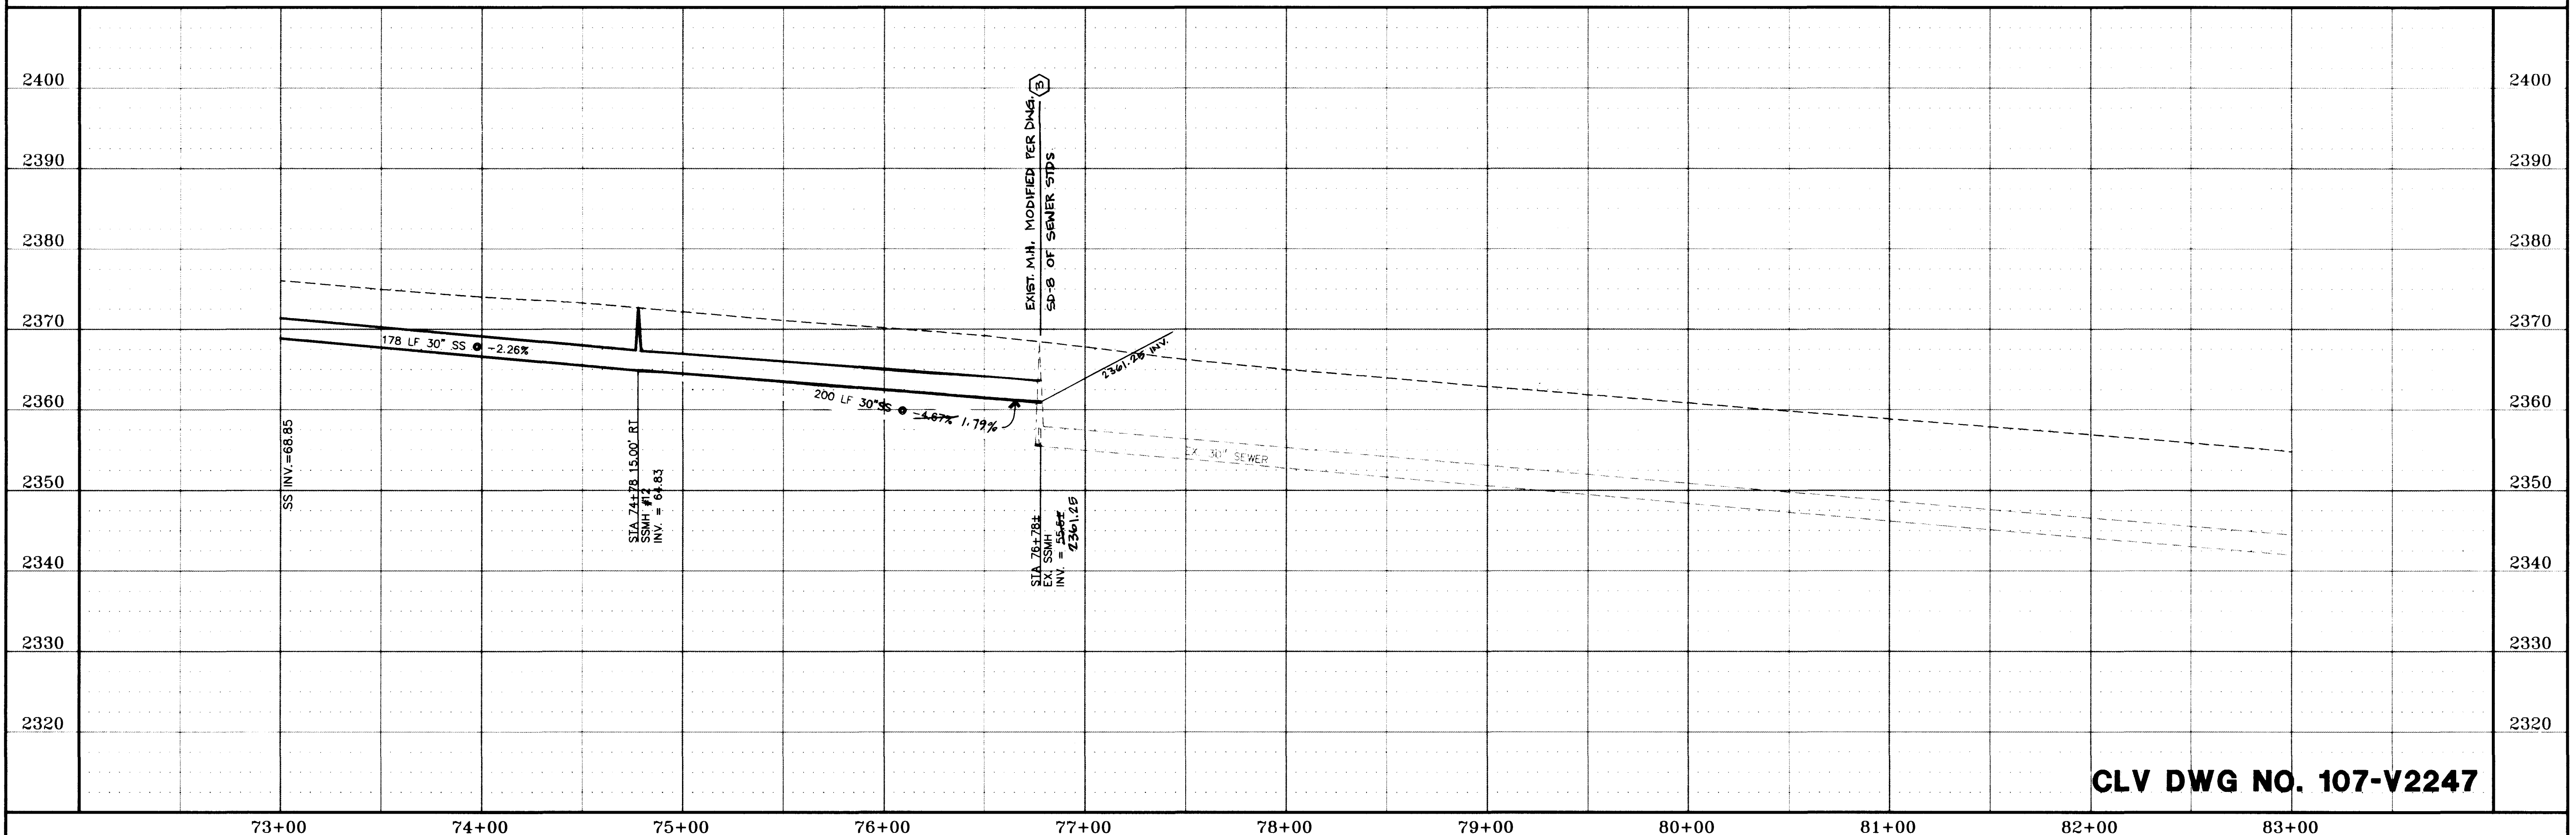

CLV DWG NO. 107-V2247

REVISIONS		
NO	DESCRIPTION/DATE	BY
1	REVISED BY CLV 11-01-96	AS-BUILT

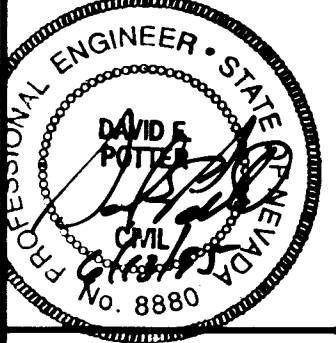


1100 GRIER DRIVE
LAS VEGAS, NEVADA 89119
PHONE (702) 361-9050
FAX (702) 361-0669



SEWER PLAN AND PROFILE
FROM STA. 73+00 TO STA. 83+00
OAKLEY BOULEVARD
RAINBOW BLVD. TO DECATUR BLVD.

JOB NO.	2-241-073
ACAD FILE	OAKESS02
DESIGNED	DP
DRAWN	TL
CHECKED	TL
DATE	JUNE 1995

SS2

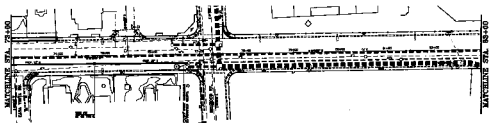


OAKLEY BOULEVARD THIRD EDITION

SEE REVISIONS ATTACHED TO THIS SHEET

CONSTRUCTION NOTES

1. ALL CONSTRUCTION SHALL BE IN ACCORD WITH THE LATEST EDITIONS OF THE CALIFORNIA STANDARD SPECIFICATIONS FOR HIGHWAY CONSTRUCTION, LATEST EDITION, AND THE LATEST EDITIONS OF THE CALIFORNIA STANDARD SPECIFICATIONS FOR BRIDGE CONSTRUCTION, LATEST EDITION.
2. ALL CONSTRUCTION SHALL BE IN ACCORD WITH THE LATEST EDITIONS OF THE CALIFORNIA STANDARD SPECIFICATIONS FOR HIGHWAY CONSTRUCTION, LATEST EDITION, AND THE LATEST EDITIONS OF THE CALIFORNIA STANDARD SPECIFICATIONS FOR BRIDGE CONSTRUCTION, LATEST EDITION.
3. ALL CONSTRUCTION SHALL BE IN ACCORD WITH THE LATEST EDITIONS OF THE CALIFORNIA STANDARD SPECIFICATIONS FOR HIGHWAY CONSTRUCTION, LATEST EDITION, AND THE LATEST EDITIONS OF THE CALIFORNIA STANDARD SPECIFICATIONS FOR BRIDGE CONSTRUCTION, LATEST EDITION.
Call before you Dig
800-485-5747

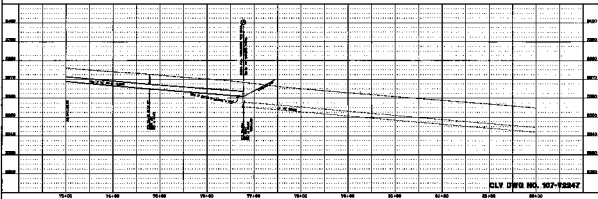

SEWER PLAN AND PROFILE
FROM CHARTERED SURVEY
PLANNING MAP, TO SANITARY MAP.

CLV DRG NO. 107-72247

892

AS BUILT 10-2-88