


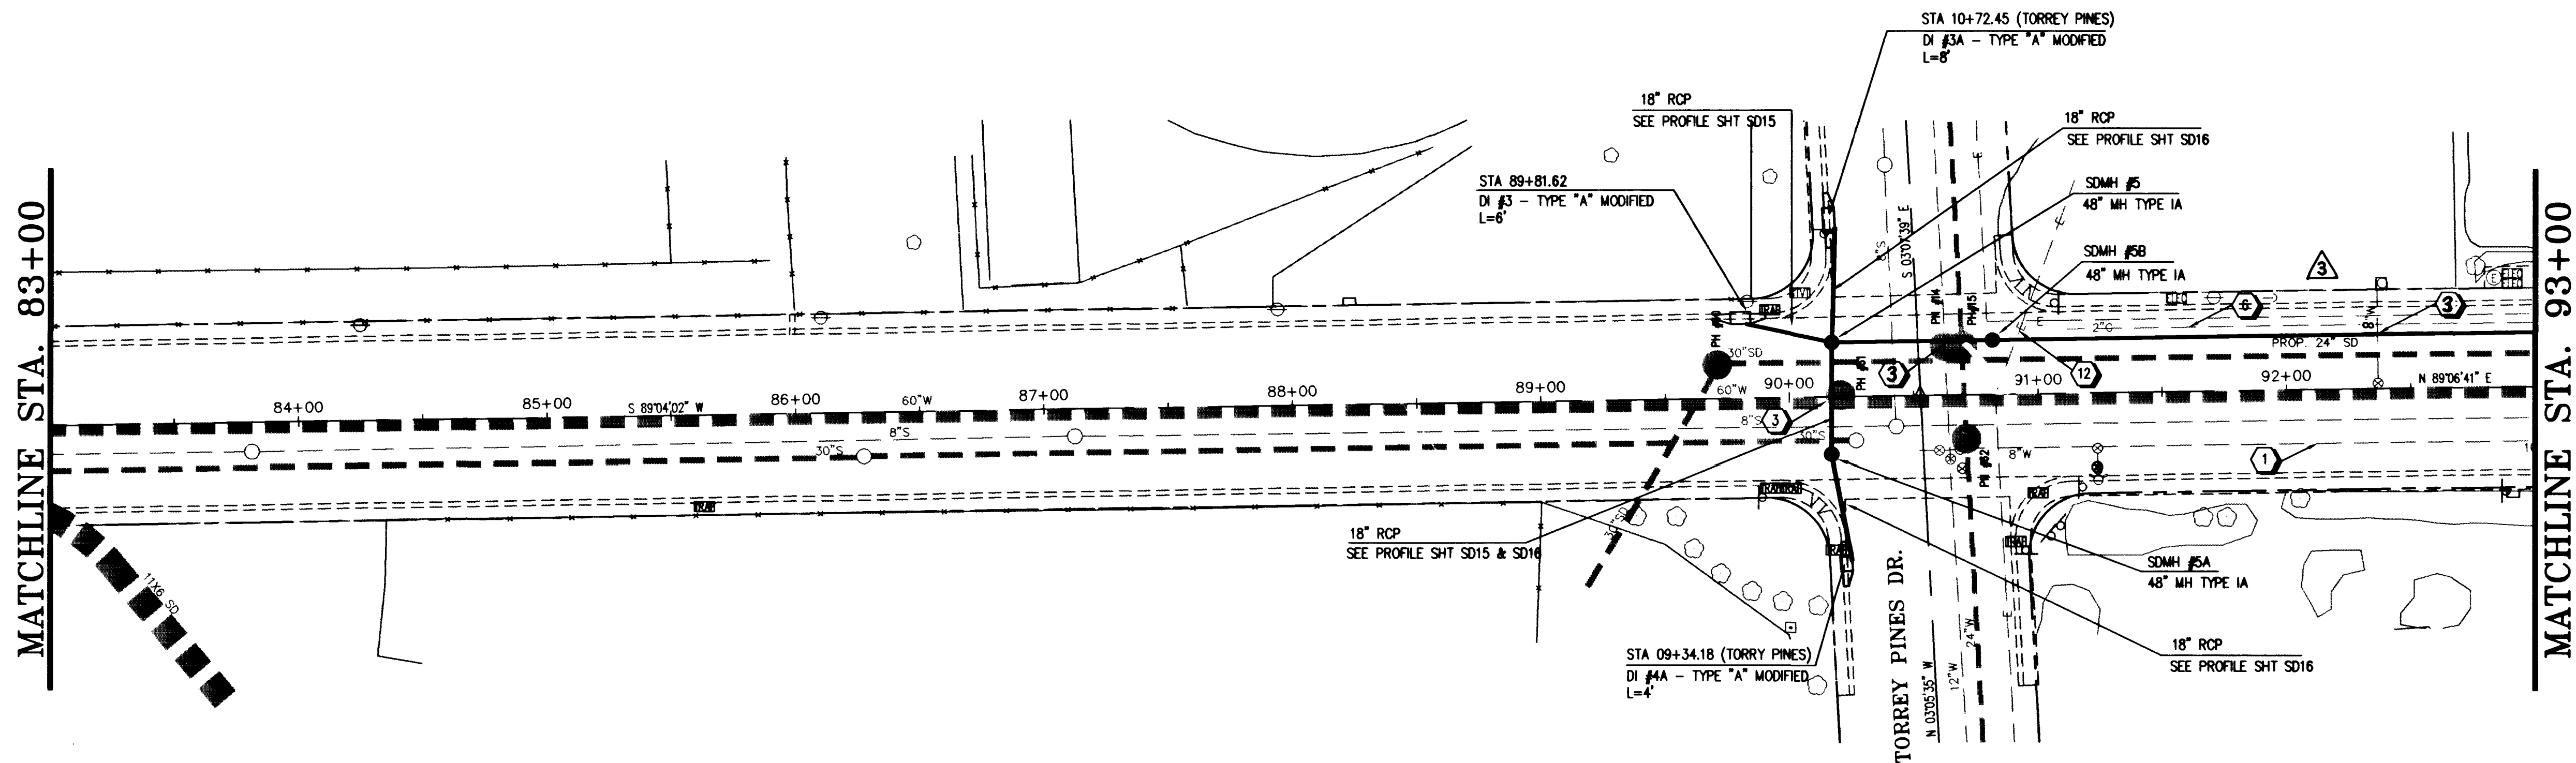

HORIZONTAL SCALE 1"=40'
VERTICAL SCALE 1"=10'

- ② DEPRESS WATERLINE. SEE DETAIL SHEET D2.
- ③ ENCASE SD WITH 4" MIN. CONCRETE ENCASEMENT TO 10' MIN. EACH SIDE OF WATERLINE. -SEE SHEET B2-
- ④ SEE SANITARY SEWER (SS) SHEETS FOR GAS RELOCATION BY SW. GAS.
- ⑤ PLUG AND ABANDON STORM SEWER.
- ⑥ 2" GAS LINE TO BE RELOCATED BY S/W GAS CORP. FROM APPROXIMATELY STA 66+45 TO 76+25, STA 101+00 TO STA 101+60, STA 109+70 TO STA 110+30 AND STA 115+30 TO STA 115+90.
- ⑦ CONNECT TO EXISTING MANHOLE (NO EXISTING STUBOUT) RECONSTRUCT MANHOLE AS REQUIRED.
- ⑧ REMOVE EXISTING INLET.
- ⑨ PLUG AND CAP EXISTING CULVERT.
- ⑩ RELOCATE WATER SERVICE LATERAL:
 - A. IF POLYETHYLENE, REMOVE AND REPLACE PER SPEC'S
 - B. IF COPPER, REPAIR AND ADJUST
- ⑪ REMOVE & REPLACE L-TYPE CURB & GUTTER (STD. DWG. NO.216)
- ⑫ CAUTION: THESE ARE ENERGIZED CABLES. A NPC QUALIFIED REPRESENTATIVE MUST BE PRESENT DURING CONSTRUCTION IN OR AROUND THIS EQUIPMENT. CALL 657-4117 FOR AN APPOINTMENT 48 HOURS PRIOR.

REVISIONS			
NO.	DESCRIPTION/DATE	BY	
1	REVISED BY CLW 11-1-75	CLW	45
2	DRAINAGE REVISED 1-2-76	D.P.	



PROFESSIONAL ENGINEER-STATE OF NEW MEXICO
 ROBERT A. SCOTT
 CIVIL
 No. 10122

SEA
Incorporated
CONSULTING ENGINEERS

1100 GRIER DRIVE
LAS VEGAS, NEVADA 89119
PHONE (702) 361-9050
FAX (702) 361-0659

STORM DRAIN PLAN AND PROFILE
FROM STA. 83+00 TO STA. 93+00
OAKLEY BOULEVARD
RAINBOW BLVD. TO DECATUR BLVD.

CITY OF LAS VEGAS	
JOB NO.:	2-241-073
ACAD FILE:	OAKESD03
DESIGNED:	RHS
DRAWN:	TL
CHECKED:	DP
DATE:	JUNE 1995

SD3

49 OF 61 SHEETS


[illegible]

CLV DWG NO. 107-V2247

I:\ENG\DWGS\241073\ROAD
12484

AS BUILT

18-2-106

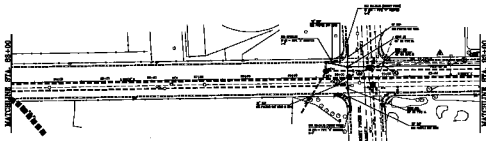

72 5

ENVIRONMENTAL MONITORING

- 1) An investor who purchases an equity security
- 2) immediately after the stock has been
- 3) **issued** is called a(n) **initial public offering**.
- 4) An investor who purchases an equity security
- 5) after the stock has been issued is called a(n) **secondary market**.
- 6) If an investor purchases an equity security
- 7) after the stock has been issued, the investor is called a(n) **secondary market**.
- 8) An investor who purchases an equity security
- 9) after the stock has been issued is called a(n) **secondary market**.

- ① **WASH STATE B&E**
- ② **WASH STATE B&E**
- ③ **WASH STATE B&E**
- ④ **WASH STATE B&E**
- ⑤ **WASH STATE B&E**
- ⑥ **WASH STATE B&E**
- ⑦ **WASH STATE B&E**
- ⑧ **WASH STATE B&E**
- ⑨ **WASH STATE B&E**
- ⑩ **WASH STATE B&E**
- ⑪ **WASH STATE B&E**
- ⑫ **WASH STATE B&E**
- ⑬ **WASH STATE B&E**
- ⑭ **WASH STATE B&E**
- ⑮ **WASH STATE B&E**
- ⑯ **WASH STATE B&E**
- ⑰ **WASH STATE B&E**
- ⑱ **WASH STATE B&E**
- ⑲ **WASH STATE B&E**
- ⑳ **WASH STATE B&E**
- ㉑ **WASH STATE B&E**
- ㉒ **WASH STATE B&E**
- ㉓ **WASH STATE B&E**
- ㉔ **WASH STATE B&E**
- ㉕ **WASH STATE B&E**
- ㉖ **WASH STATE B&E**
- ㉗ **WASH STATE B&E**
- ㉘ **WASH STATE B&E**
- ㉙ **WASH STATE B&E**
- ㉚ **WASH STATE B&E**
- ㉛ **WASH STATE B&E**
- ㉜ **WASH STATE B&E**
- ㉝ **WASH STATE B&E**
- ㉞ **WASH STATE B&E**
- ㉟ **WASH STATE B&E**
- ㊱ **WASH STATE B&E**
- ㊲ **WASH STATE B&E**
- ㊳ **WASH STATE B&E**
- ㊴ **WASH STATE B&E**
- ㊵ **WASH STATE B&E**
- ㊶ **WASH STATE B&E**
- ㊷ **WASH STATE B&E**
- ㊸ **WASH STATE B&E**
- ㊹ **WASH STATE B&E**
- ㊺ **WASH STATE B&E**
- ㊻ **WASH STATE B&E**
- ㊼ **WASH STATE B&E**
- ㊽ **WASH STATE B&E**
- ㊾ **WASH STATE B&E**
- ㊿ **WASH STATE B&E**

Call before you dig

[illegible]

STORM DRAIN PLAN AND PROFILE
FROM STA. 0+00 TO STA. 0+40
CROSS STREET BRIDGE
BANKVIEW TOWN TO BRIDGE BLVD.

SDS

AS BUILT

12-121-