


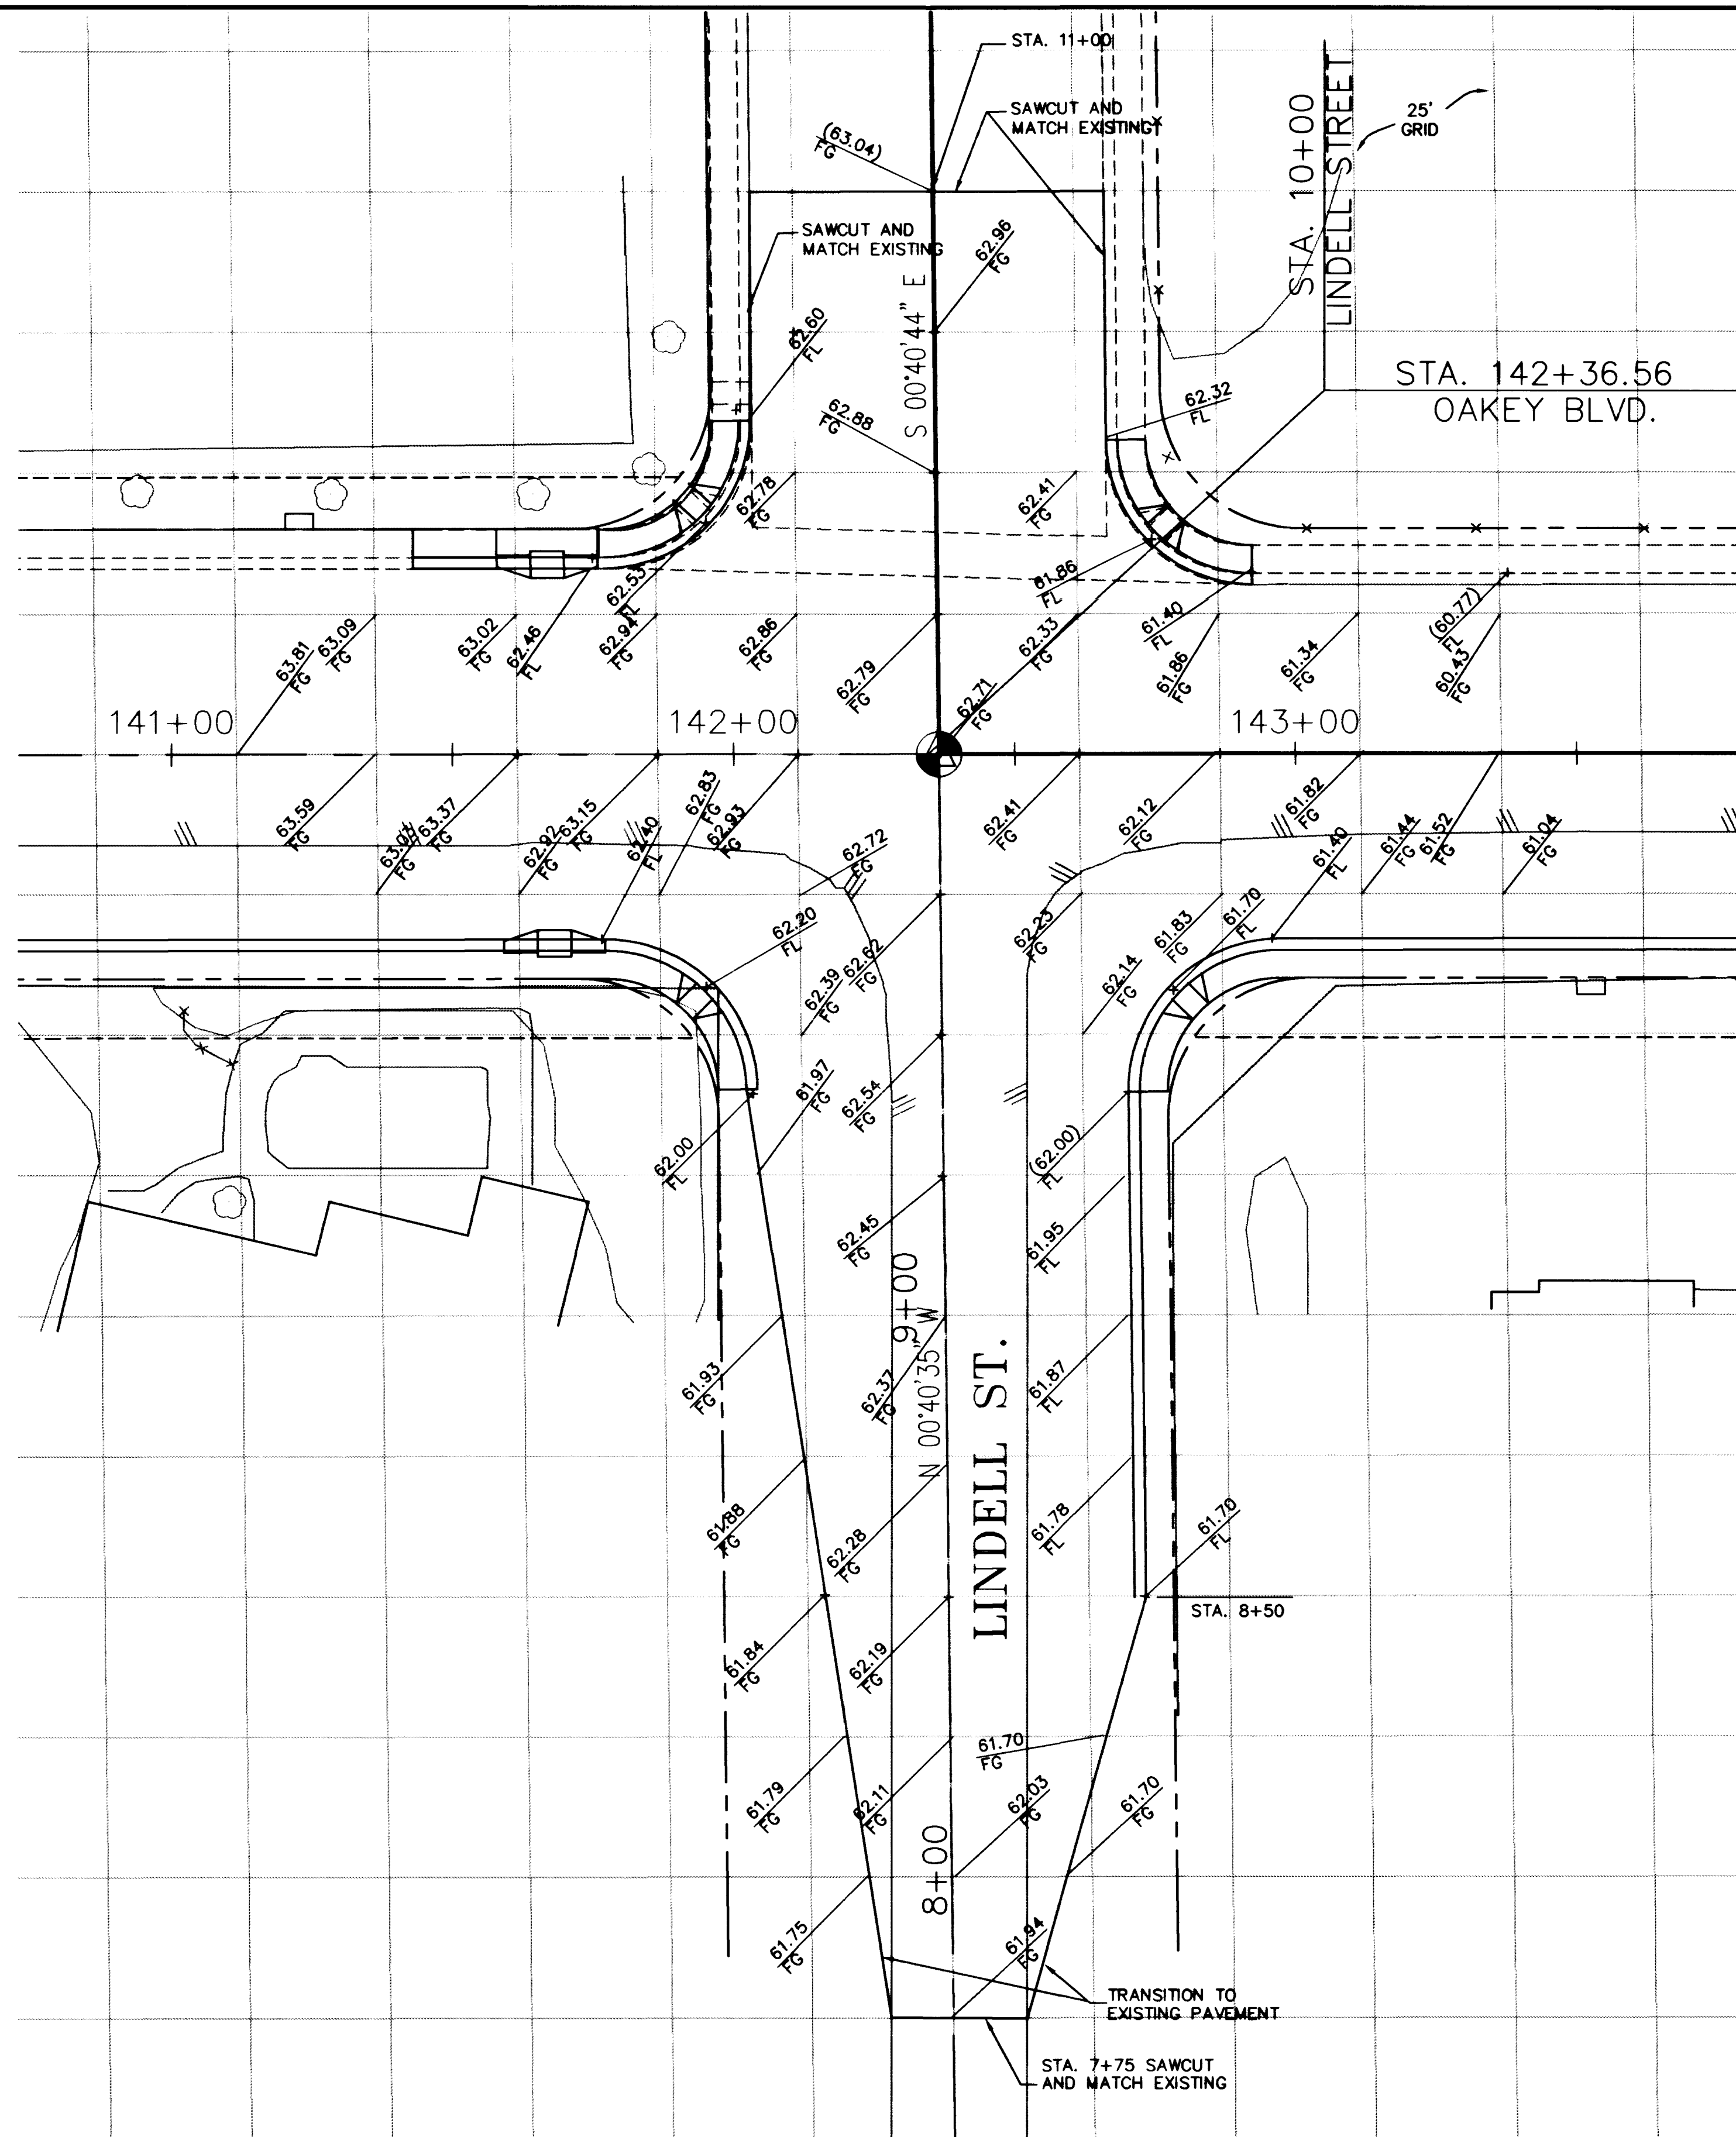

LINDELL STREET

HORIZONTAL SCALE 1"=20'

NOTE


1. SEE SHEET C8 FOR CURB RETURNS, RAMP, SIDEWALK AND BLOCKWALL
2. SEE SHEET T4 FOR STRIPING AND LIGHTING.
3. SEE SHEET SS8 FOR SANITARY SEWER
4. SEE SHEET SD8 FOR PLACEMENT OF DROP INLETS
5. SEE SHEET TS4 FOR SIGNAL CONSTRUCTION

Call
before you
Dig.
1-800-227-2800

CLV DWG NO. 107-V2247

AS BUILT

REVISIONS		
NO.	DESCRIPTION/DATE	BY

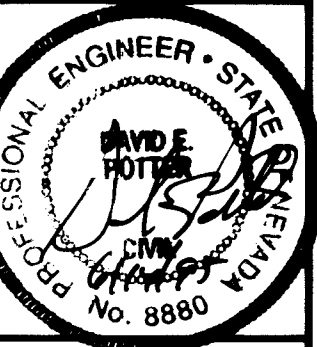

1100 GRIER DRIVE
LAS VEGAS, NEVADA 89119
PHONE (702) 361-9050
FAX (702) 361-0659



INTERSECTION GRADING PLAN
LINDELL ST.
OAKLEY BLVD
RAINBOW BLVD. TO DECATUR BLVD.

NEVADA


CLARK COUNTY

CITY OF LAS VEGAS

JOB NO.:	2-241-073
ACAD FILE:	INTRSC7M
DESIGNED:	JB
DRAWN:	TH
CHECKED:	DP
DATE:	JUNE 1995

C14

22 OF 62 SHEETS

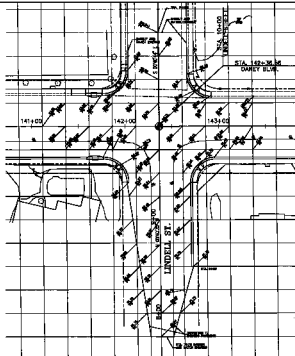

LINDELL STREET

HORIZONTAL SCALE 1"=200'

CLV DWB NO. 107-V#247

INTERSECTION CHANGING PLAN

WING FLA

CLUBBY BLVD
NARROW BLVD. TO DECATUR BLVD.

1000

C14

AS WHEEL

10-27