



NO.	REVISIONS DESCRIPTION/DATE	BY
1	REVISED BY CLV 11-01-95	

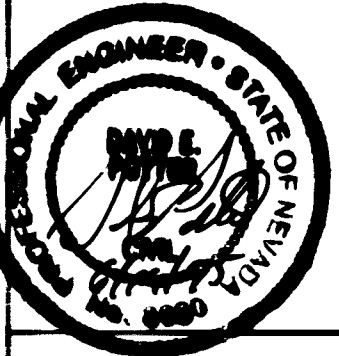

1100 GRIER DRIVE
LAS VEGAS, NEVADA 89119
PHONE (702) 361-9050
FAX (702) 361-0659

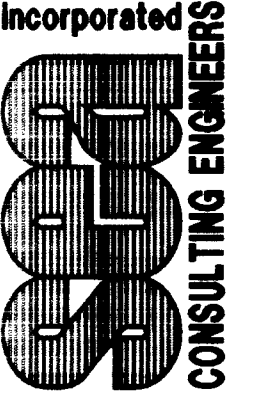

NEVADA

INTERSECTION GRADING PLAN
TORREY PINES DR.
OAKLEY BLVD
RAINBOW BLVD. TO DECATUR BLVD.



CLARK COUNTY

CITY OF LAS VEGAS

JOB NO.	2-241-073
ACAD FILE	INTRSC02
DESIGNED	JB
DRAWN	TH
CHECKED	DP
DATE	JUNE 1995

C12

20 OF 62 SHEETS

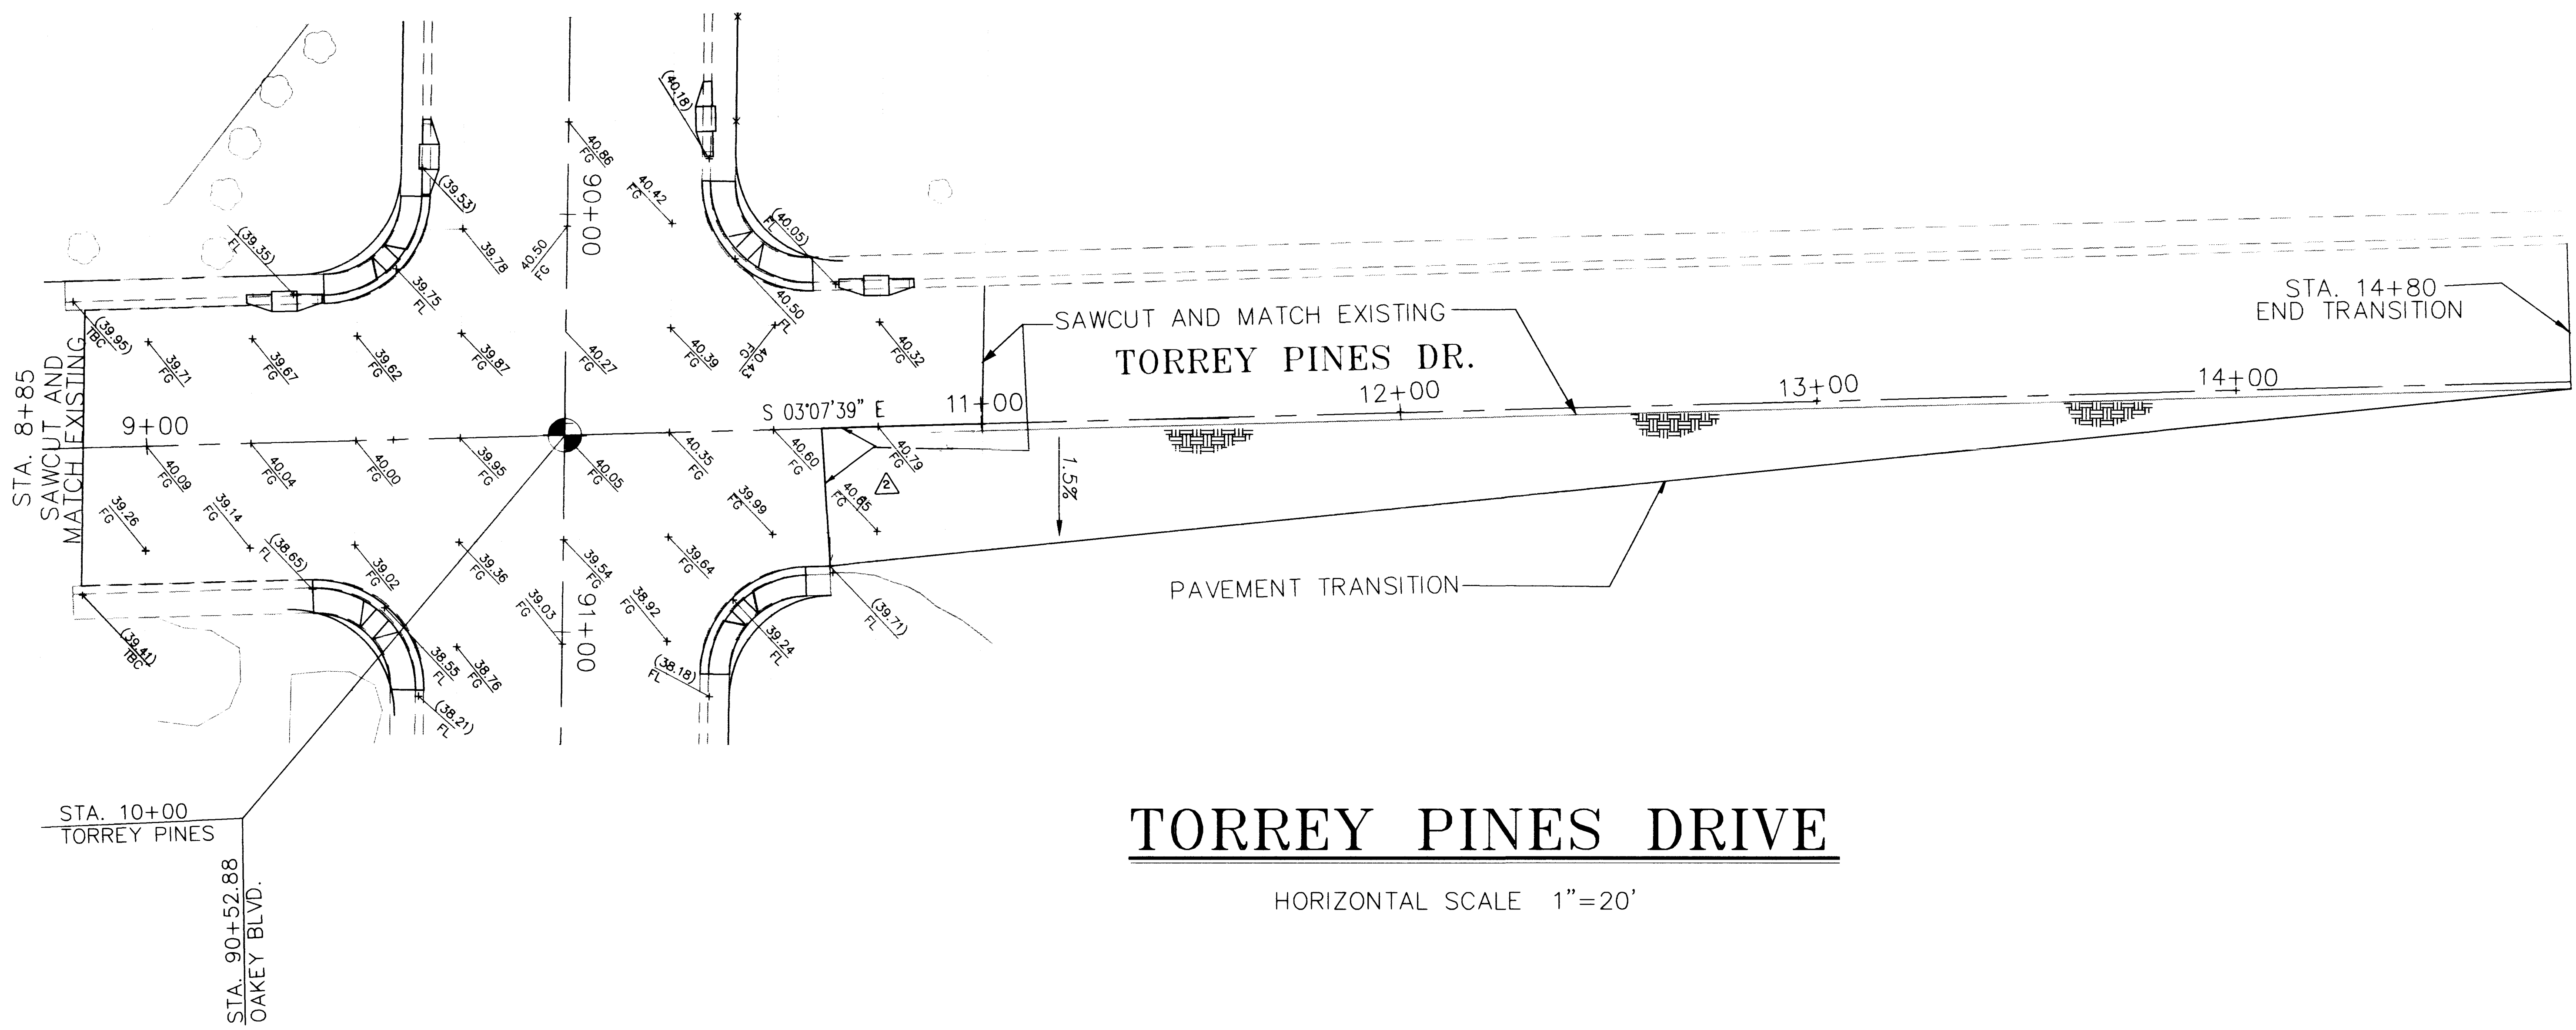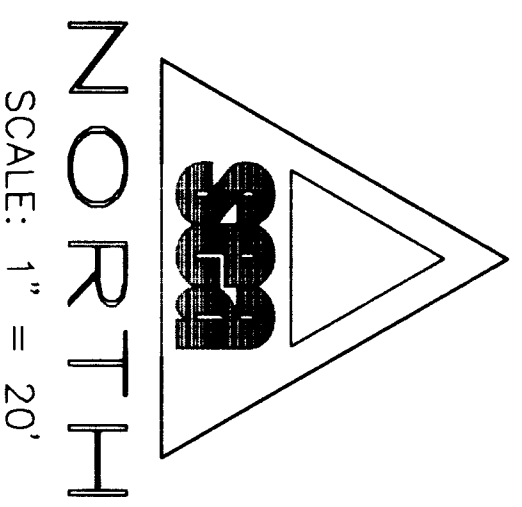


TORREY PINES DRIVE

HORIZONTAL SCALE 1"=20'

NOTE:

1. SEE SHEET C3 FOR CURB RETURN, RAMP SIDEWALK, AND BLOCK WALL
2. SEE SHEET TS2 FOR STRIPING AND LIGHTING
3. SEE SHEET TS2 FOR TRAFFIC SIGNAL CONSTRUCTION
4. SEE SHEET SS3 FOR SANITARY SEWER
5. SEE SHEET SD3 FOR STORM DRAIN



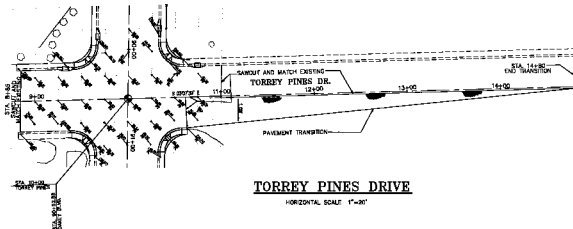

TORREY PINES DRIVE

HORIZONTAL SCALE 1"=20'

NOTE

1. SEE SHEET 102 FOR CURB RETURN, RAMP, SIDEWALK, AND BLOCK WALL
2. SEE SHEET 102 FOR STRIPING AND LIGHTING
3. SEE SHEET 102 FOR TRAFFIC SIGNAL CONSTRUCTION
4. SEE SHEET 103 FOR SANITARY SEWER
5. SEE SHEET 103 FOR STORM DRAIN



CLV DWG NO. 107-V2247

C12

AS BUILT

10-2-68

NO NEW WORK
ON THIS ROAD
OR ADJACENT
ROADS TO BE
CONSTRUCTED
FOR THE FUTURE



INTERSECTION GRADING PLAN
TORREY PINES DRIVE
MAYBERRY BLVD. TO DUNSTON BLVD.
CLV DWG NO. 107-V2247

DATE	10-2-68
BY	CLV
CHECKED BY	CLV
APPROVED BY	CLV

10-2-68