


SEE "PROPERTY LINE BLOCKWALL DETAIL" SHEET D2

Call before you Dig.

1-800-227-2600

CURVE TABLE - BACK OF CURB					SIDEWALK RAMP DIMENSIONS	
NUMBER	RADIUS	DELTA	TANGENT	LENGTH	'A'	'B'
1	25.00'	91°19'33"	25.59'	39.85'	8.0'	8.0'
2	25.00'	88°40'27"	24.43'	38.69'	9.5'	4.5'
3	25.00'	88°39'41"	24.43'	38.69'	8.0'	8.0'
4	25.00'	91°20'19"	25.59'	39.85'	4.5'	9.5'
6	15.00'	88°26'39"	14.60'	23.15'	8.0'	8.0'
7	15.00'	91°33'21"	15.41'	23.97'	9.5'	4.5'

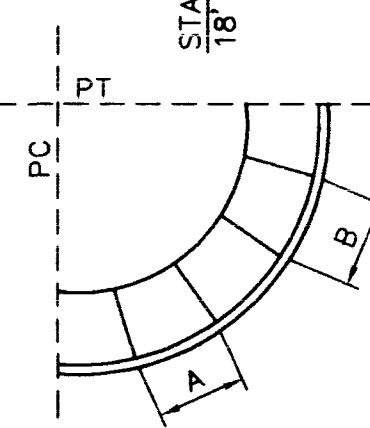

SIDEWALK RAMP
SEE TABLE FOR
TRANSITION LENGTHS


Oakey Boulevard

HORIZONTAL SCALE 1"=40'
VERTICAL SCALE 1"=10'

REMOVE A.C. PAVEMENT


CONSTRUCTION NOTES

- CONSTRUCT ASPHALT CONCRETE PAVEMENT (SEE TYP. SECTION SHT. 4)
- CONSTRUCT TACK ON ISLAND (STD DWG NO. 220)
- CONSTRUCT CONCRETE SIDEWALK (STD DWG NO. 234)
- CONSTRUCT L-TYPE CURB AND GUTTER (STD DWG NO. 216)
- CONSTRUCT SIDEWALK RAMP (STD DWG NO. 235)
- CONSTRUCT CROSS GUTTER (STD DWG NO. 228)
- CONSTRUCT RESIDENTIAL DRIVEWAY (STD DWG NO. 223)
- CONSTRUCT COMMERCIAL DRIVEWAY
- CONSTRUCT 8' DRIVEWAY TRANSITION (MATCH EXISTING SURFACE)
- CONSTRUCT TRANSITION PAVEMENT 2" AC OVER 6" TYPE II AGG. BASE
- CONSTRUCT RETAINING WALL
- SAW CUT AND MATCH EXISTING
- SET NEW SURVEY MONUMENT, TYPE I (STD DWG NO. 239)
- SET NEW SURVEY MONUMENT, TYPE III (STD DWG NO. 241)
- ADJUST EXISTING MANHOLE (STD DWG NO. 403) 408
- ADJUST EXISTING WATER VALVE (STD DWG NO. 517)
- ADJUST UTILITY VAULT OR PULL BOX
- REMOVE ASPHALT CONCRETE PAVEMENT
- REMOVE L-TYPE CURB AND GUTTER
- REMOVE CONCRETE SIDEWALK PC TO PT
- REMOVE BLOCKWALL
- REMOVE FENCE
- REMOVE CROSS GUTTER
- RELOCATE FIRE HYDRANT (MIN. 20' FROM CURB RETURN)
- RELOCATE MAIL BOX
- REMOVE TREE
- NO CONSTRUCTION EASEMENT
- RELOCATE WATER METER
- RELOCATE STREET LIGHT (SEE TRAFFIC SHTS)
- RELOCATE TRAFFIC SIGN (SEE TRAFFIC SHTS)
- REMOVE & REPLACE CROSS GUTTER SPANDREL TO ACCOMMODATE NEW WHEELCHAIR RAMP SAWCUT
- SET NEW SURVEY MONUMENT TYPE IIB (STD DWG NO. 240)
- ADJUST WATER METER
- CONSTRUCT TRANSITION PAVEMENT 4" AC OVER 6" TYPE II AGG. BASE FROM END OF RETURN
- TEMPORARY CONSTRUCTION EASEMENT
- NEW INLET - SEE STORM DRAIN SHEET
- RELOCATE FENCE TO NEW R/W
- REMOVE PLANTER WALL
- RECONSTRUCT BLOCK WALL
- CONSTRUCT 3'x5' BUS STOP PAD (STD DWG #234)
- EXIST. POWER POLE TO BE RELOCATED BY NEVADA POWER
- REMOVE/RECONSTRUCT BLOCK WALL
- W/ WROUGHT-IRON ORNAMENT
- INSTALL 6" WATER LINE INCLUDING 8" x 6" TAPPING TEE AND 6" VALVE
- INSTALL 4" SEWER SERVICE WITH INVERT AT 4' BELOW GRADE AT PROPERTY LINE.
- FOOTING CAP CONSTRUCTED

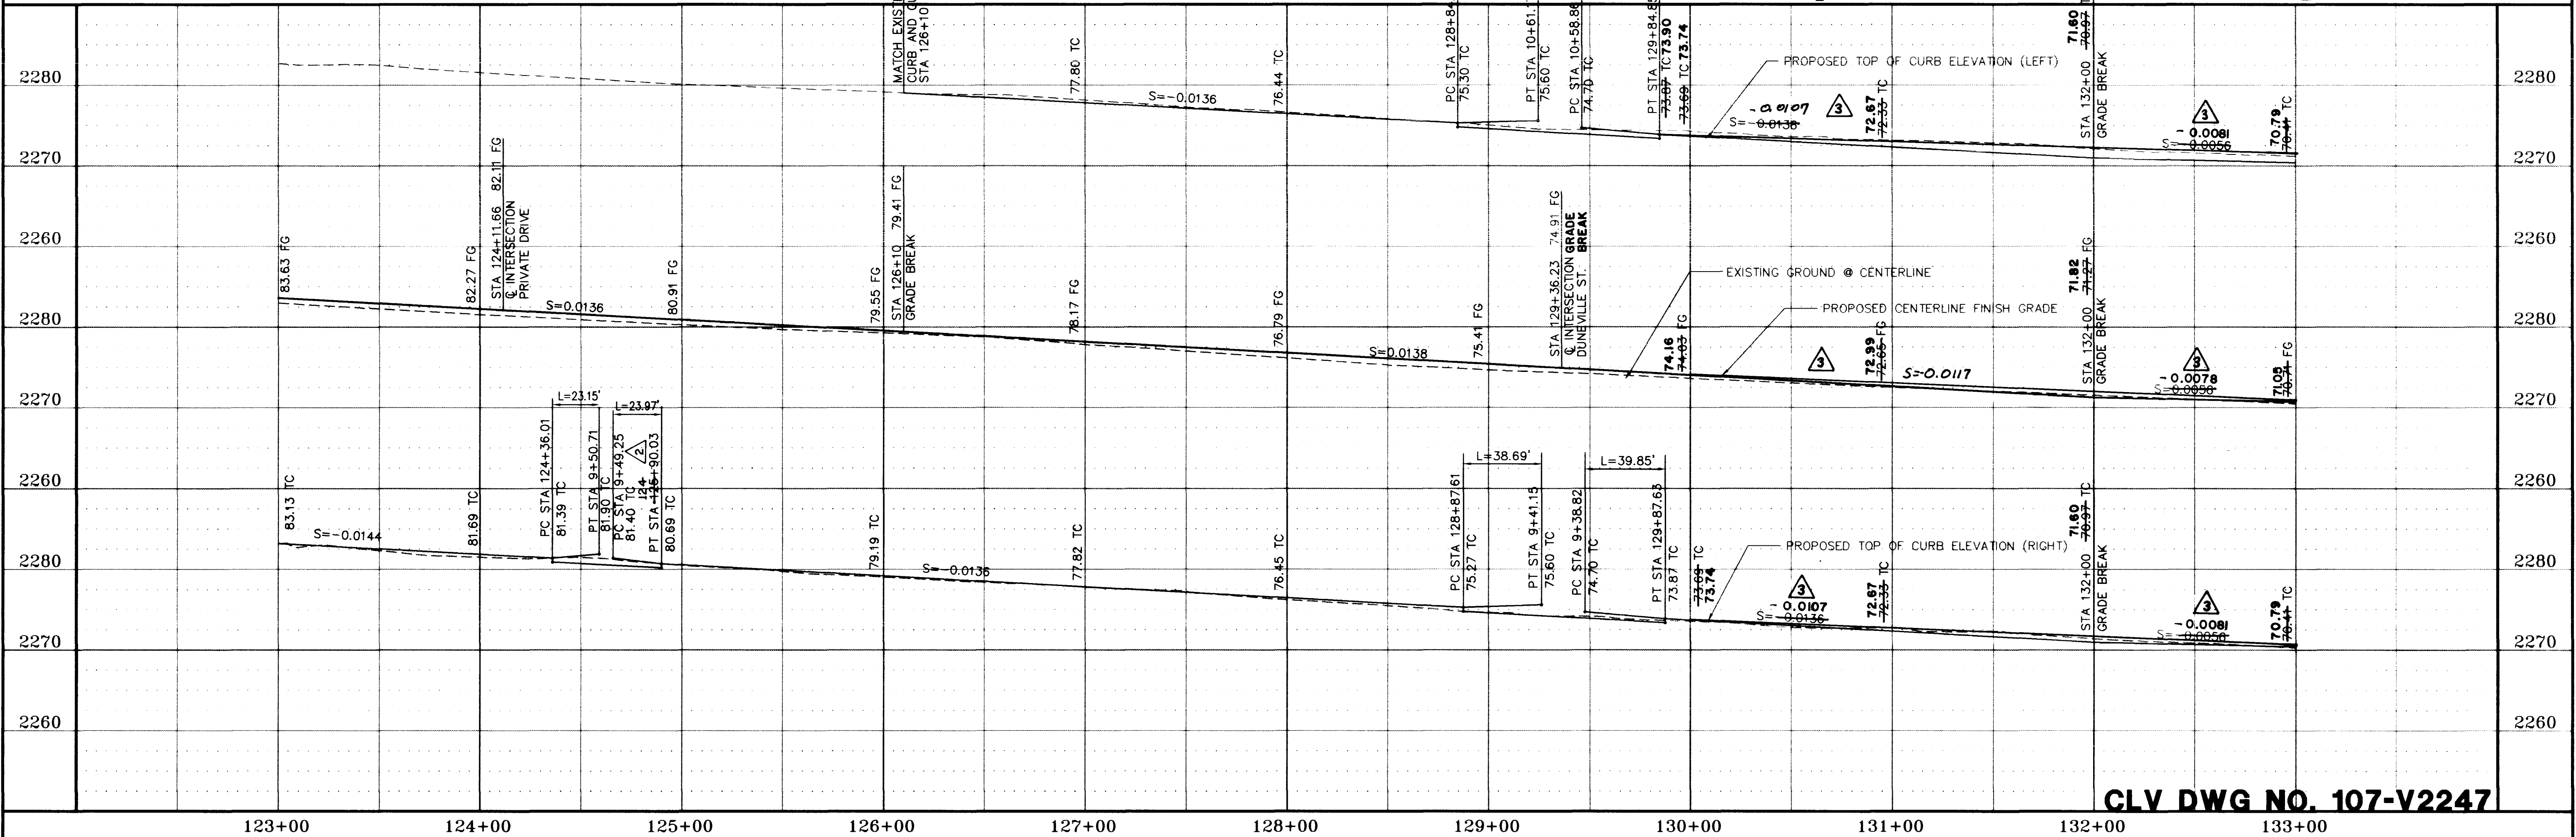


CLV DWG NO. 107-V2247

NO.	DESCRIPTION/DATE	BY
1	REVISED BY CLV 11-01-95	CLV
2	PROFILE REV. 4-1-96	CLV
3	AS BUILT 9-14-97	CLV

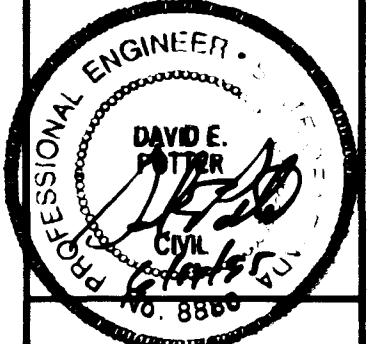

1100 ORIER DRIVE
LAS VEGAS, NEVADA 89119
PHONE (702) 361-9050
FAX (702) 361-0669

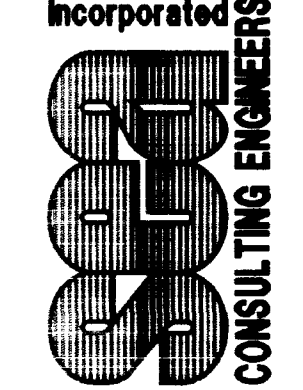

NEVADA

CLARK COUNTY

CITY OF LAS VEGAS

ROADWAY PLAN AND PROFILE
FROM STA. 123+00 TO STA. 133+00
Oakey Boulevard
RAINBOW BLVD. TO DECATUR BLVD.

JOB NO.	2-241-073
ACAD FILE	OAKEPP07
DESIGNED	DP
DRAWN	TL
CHECKED	DP
DATE	JUNE 1995

C7



MATCHLINE STA. 129+00

MATCHLINE STA. 131+00

GRADE TABLE BY BLOCK OF ROAD									
STATION	129+00	129+25	129+50	129+75	130+00	130+25	130+50	130+75	131+00
129+00	129+00	129+25	129+50	129+75	130+00	130+25	130+50	130+75	131+00
129+25	129+25	129+25	129+50	129+75	130+00	130+25	130+50	130+75	131+00
129+50	129+50	129+50	129+50	129+75	130+00	130+25	130+50	130+75	131+00
129+75	129+75	129+75	129+75	129+75	130+00	130+25	130+50	130+75	131+00
130+00	130+00	130+00	130+00	130+00	130+00	130+25	130+50	130+75	131+00
130+25	130+25	130+25	130+25	130+25	130+25	130+25	130+50	130+75	131+00
130+50	130+50	130+50	130+50	130+50	130+50	130+50	130+50	130+75	131+00
130+75	130+75	130+75	130+75	130+75	130+75	130+75	130+75	130+75	131+00
131+00	131+00	131+00	131+00	131+00	131+00	131+00	131+00	131+00	131+00

OAKLEY BOULEVARD

SECTION 129+00 TO 131+00

REMARKS: SEE PLAN

SEE PLAN FOR

ON THE MAP
OF THE CITY OF LOS ANGELES
AND THE COUNTY OF SOUTHERN CALIFORNIA
THE CITY OF LOS ANGELES
AND THE COUNTY OF SOUTHERN CALIFORNIACITY OF LOS ANGELES
COUNTY OF SOUTHERN CALIFORNIAROADWAY PLAN AND PROFILE
FROM STA. 129+00 TO STA. 131+00
HARDING BLVD. TO MILLER BLVD.CITY OF LOS ANGELES
COUNTY OF SOUTHERN CALIFORNIA

C7

AS BUILT

16-2-48

CLV RWR NO. 107-22247