



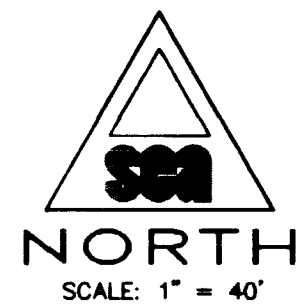


MATCHLINE STA. 93+00

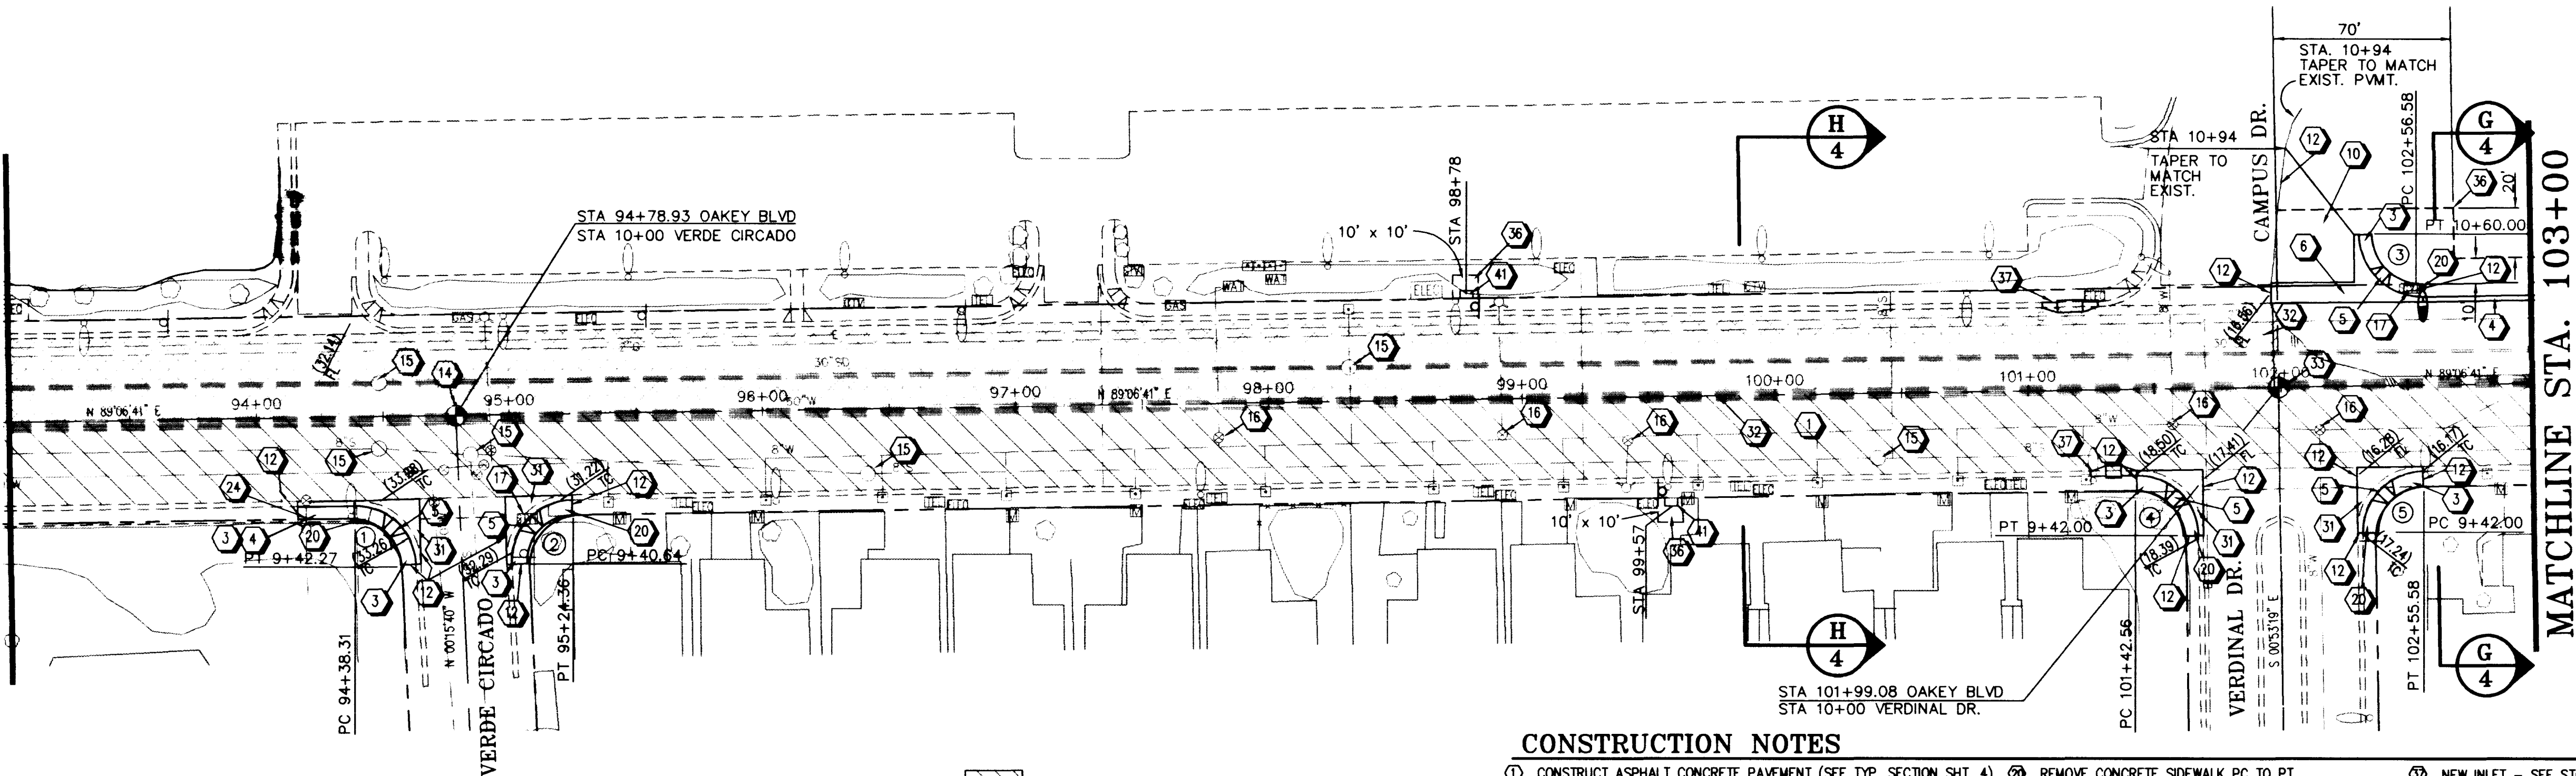

MATCHLINE STA. 103+00

CURVE TABLE • BACK OF CURB					SIDEWALK RAMP DIMENSIONS	
NUMBER	RADIUS	DELTA	TANGENT	LENGTH	'A'	'B'
1	24'	88°15'11"	23.27'	36.96'	8.0'	8.0'
2	24'	91°44'49"	24.74'	38.43'	4.5'	9.5'
3	25'	90°00'00"	25.00'	39.27'	8.0'	8.0'
4	24'	90°00'00"	24.00'	37.69'	8'	8'
5	24'	90°00'00"	24.00'	37.69'	4.5'	9.5'

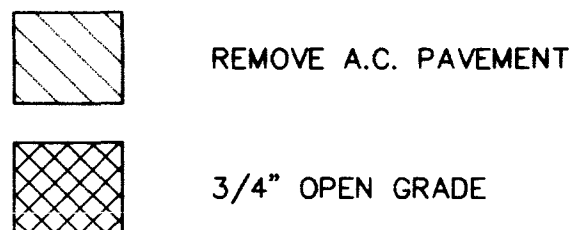


OAKLEY BOULEVARD

HORIZONTAL SCALE 1"=40'
VERTICAL SCALE 1"=10'

CONSTRUCTION NOTES

- 1) CONSTRUCT ASPHALT CONCRETE PAVEMENT (SEE TYP. SECTION SHT. 4)
- 2) CONSTRUCT TACK ON ISLAND (STD DWG NO. 220)
- 3) CONSTRUCT CONCRETE SIDEWALK (STD DWG NO. 234)
- 4) CONSTRUCT L-TYPE CURB AND GUTTER (STD DWG NO. 216)
- 5) CONSTRUCT SIDEWALK RAMP (STD DWG NO. 235)
- 6) CONSTRUCT CROSS GUTTER (STD DWG NO. 228)
- 7) CONSTRUCT RESIDENTIAL DRIVEWAY (STD DWG NO. 223)
- 8) CONSTRUCT COMMERCIAL DRIVEWAY
- 9) CONSTRUCT 8" DRIVEWAY TRANSITION (MATCH EXISTING SURFACE)
- 10) CONSTRUCT TRANSITION PAVEMENT 2" AC OVER 6" TYPE II AGG. BASE
- 11) CONSTRUCT RETAINING WALL
- 12) SAWCUT AND MATCH EXISTING
- 13) SET NEW SURVEY MONUMENT, TYPE I (STD DWG NO. 239)
- 14) SET NEW SURVEY MONUMENT, TYPE III (STD DWG NO. 241)
- 15) ADJUST EXISTING MANHOLE (STD DWG NO. 403) 408
- 16) ADJUST EXISTING WATER VALVE (STD DWG NO. 517)
- 17) ADJUST UTILITY VAULT OR PULL BOX
- 18) REMOVE ASPHALT CONCRETE PAVEMENT
- 19) REMOVE L-TYPE CURB AND GUTTER
- 20) REMOVE CONCRETE SIDEWALK PC TO PT
- 21) REMOVE BLOCKWALL
- 22) REMOVE FENCE
- 23) REMOVE CROSS GUTTER
- 24) RELOCATE FIRE HYDRANT (MIN. 20' FROM CURB RETURN)
- 25) RELOCATE MAIL BOX
- 26) REMOVE TREE
- 27) NO CONSTRUCTION EASEMENT
- 28) RELOCATE WATER METER
- 29) RELOCATE STREET LIGHT (SEE TRAFFIC SHTS)
- 30) RELOCATE TRAFFIC SIGN (SEE TRAFFIC SHTS)
- 31) REMOVE & REPLACE CROSS GUTTER SPANDREL TO ACCOMMODATE NEW WHEELCHAIR RAMP
- 32) SAWCUT
- 33) SET NEW SURVEY MONUMENT TYPE IIB (STD DWG NO. 240)
- 34) ADJUST WATER METER
- 35) CONSTRUCT TRANSITION PAVEMENT 4" AC OVER 6" TYPE II AGG. BASE FROM END OF RETURN
- 36) TEMPORARY CONSTRUCTION EASEMENT
- 37) NEW INLET - SEE STORM DRAIN SHEET
- 38) RELOCATE FENCE TO NEW R/W
- 39) REMOVE PLANTER WALL
- 40) RECONSTRUCT BLOCK WALL
- 41) CONSTRUCT 3'X5' BUS STOP PAD (ST DWG #234)
- 42) EXIST POWER POLE TO BE RELOCATED BY NEVADA POWER
- 43) REMOVE/RECONSTRUCT BLOCK WALL - W/ WROUGHT IRON ORNAMENT
- 44) INSTALL 6" WATER LINE INCLUDING 8" X 6" TAPPING TEE AND 6" VALVE
- 45) INSTALL 4" SEWER SERVICE WITH INVERT AT 4" BELOW GRADE AT PROPERTY LINE.

Call
before you
Dig.
1-800-227-2600
NEVADA STATE BOARD OF PUBLIC WORKS

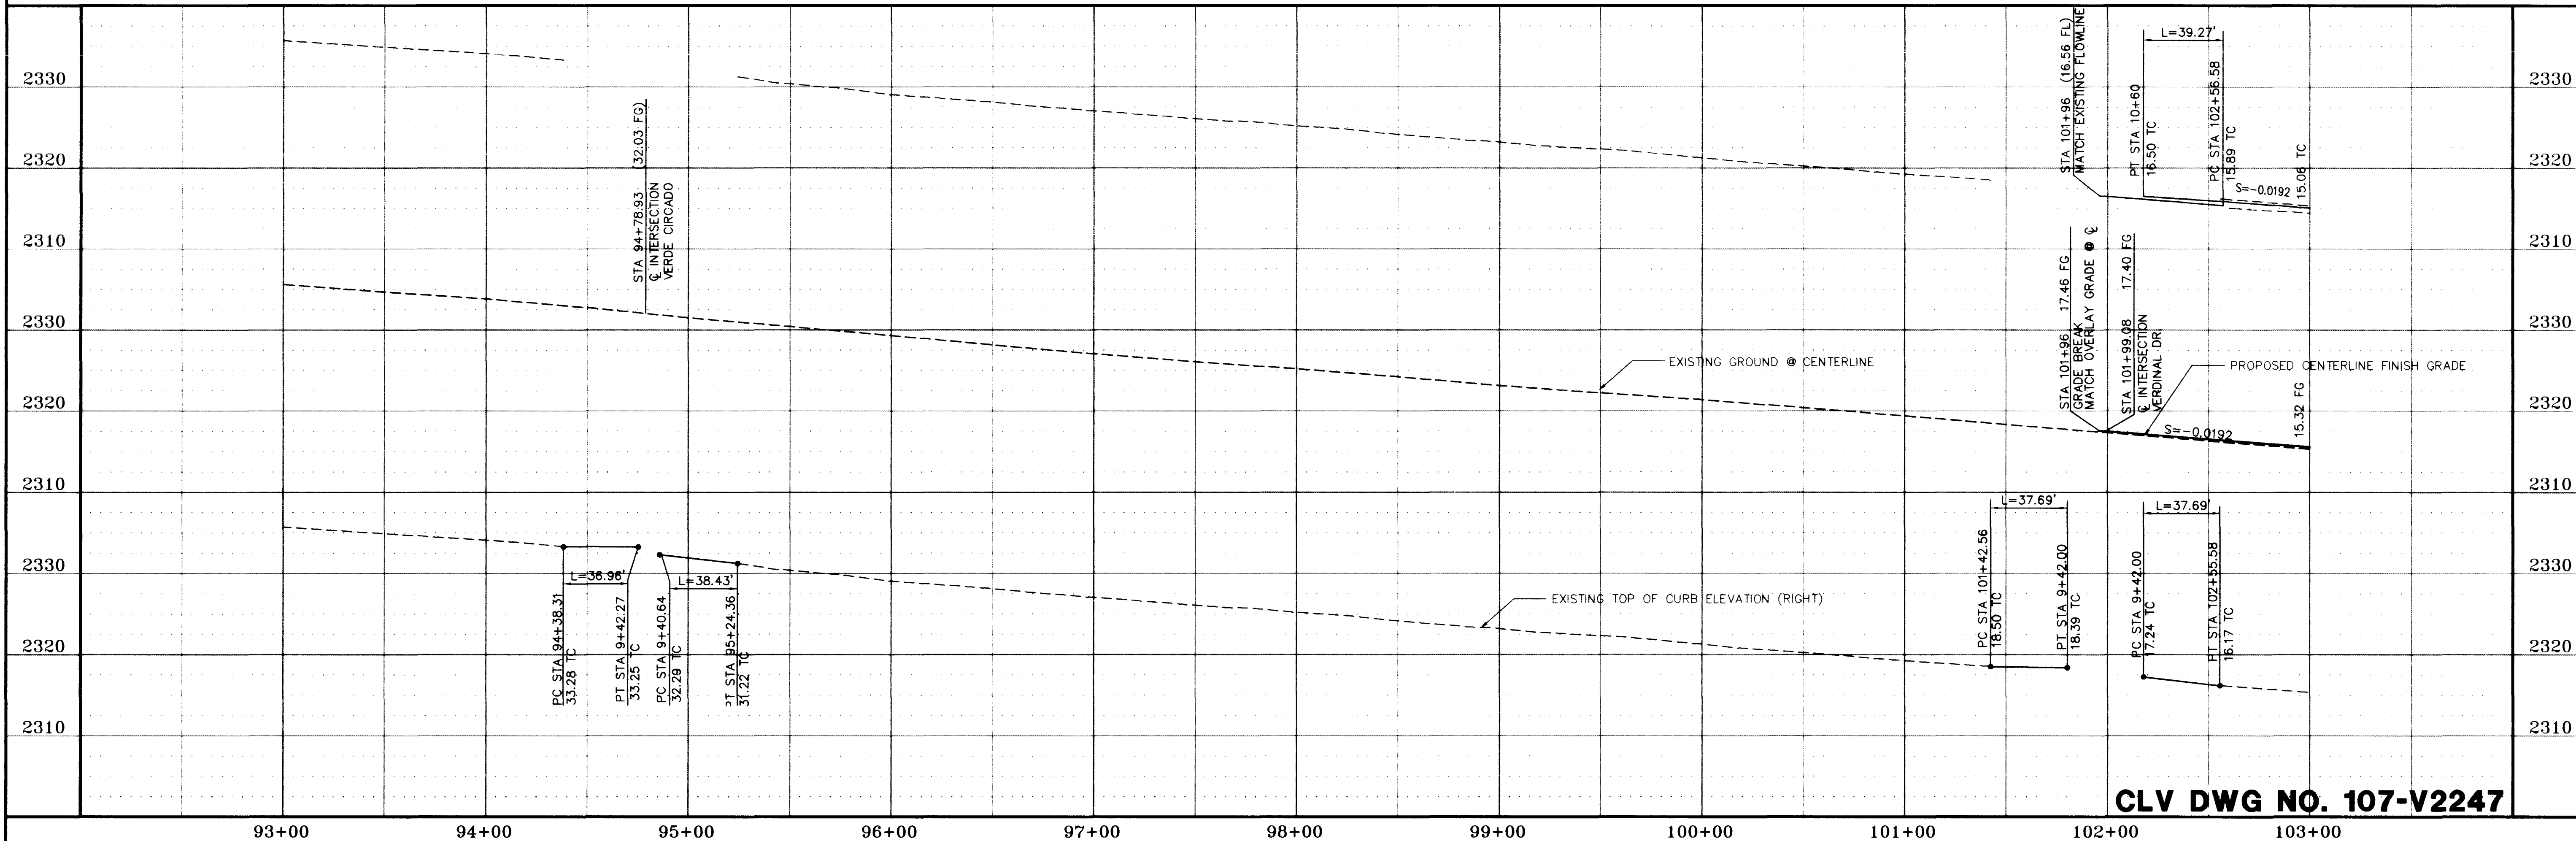

CLV DWG NO. 107-V2247

REVISIONS
NO. DESCRIPTION/DATE BY
1. CHANGED BY GUY 11-01-95

1100 GRIER DRIVE
LAS VEGAS, NEVADA 89119
PHONE (702) 361-9050
FAX (702) 361-0659

Incorporated
CONSULTING ENGINEERS

NEVADA
CLARK COUNTY
CITY OF LAS VEGAS


JOB NO. 2-241-073
ACAD FILE OAKEPP04
DESIGNED: DP
DRAWN: TL
CHECKED: DP
DATE: JUNE 1995

C4

12 OF 62 SHEETS

ROADWAY PLAN AND PROFILE
FROM STA. 93+00 TO STA. 103+00
OAKLEY BOULEVARD
RAINBOW BLVD. TO DECATUR BLVD.

18-5-61

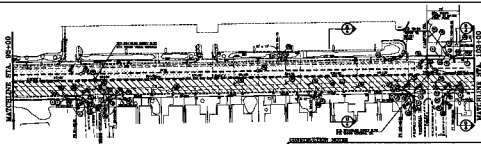

Station	Width	Depth	Area	Volume
95+00	10.0	1.0	10.0	10.0
96+00	10.0	1.0	10.0	10.0
97+00	10.0	1.0	10.0	10.0
98+00	10.0	1.0	10.0	10.0
99+00	10.0	1.0	10.0	10.0
100+00	10.0	1.0	10.0	10.0
101+00	10.0	1.0	10.0	10.0
102+00	10.0	1.0	10.0	10.0
103+00	10.0	1.0	10.0	10.0




DAVEY BOULEVARD

SECTION 107-V247

CONSTRUCTION NOTES

1. ALL CONSTRUCTION SHALL BE IN ACCORDANCE WITH THE LATEST EDITIONS OF THE CALIFORNIA STANDARD SPECIFICATIONS FOR HIGHWAY CONSTRUCTION.
2. THE CONTRACTOR SHALL BE RESPONSIBLE FOR OBTAINING ALL NECESSARY PERMITS AND APPROVALS FROM THE APPROPRIATE AGENCIES.
3. THE CONTRACTOR SHALL MAINTAIN ACCESS TO ALL ADJACENT PROPERTIES AND PUBLIC UTILITIES AT ALL TIMES.
4. THE CONTRACTOR SHALL BE RESPONSIBLE FOR THE PROTECTION OF ALL EXISTING UTILITIES AND STRUCTURES.
5. THE CONTRACTOR SHALL MAINTAIN ADEQUATE DRAINAGE AND EROSION CONTROL MEASURES THROUGHOUT THE PROJECT.
6. THE CONTRACTOR SHALL BE RESPONSIBLE FOR THE REMOVAL AND DISPOSAL OF ALL EXCESS MATERIAL AND DEBRIS.
7. THE CONTRACTOR SHALL MAINTAIN ADEQUATE SAFETY MEASURES AND TRAFFIC CONTROL DURING CONSTRUCTION.
8. THE CONTRACTOR SHALL BE RESPONSIBLE FOR THE PROTECTION OF ALL ADJACENT PROPERTIES AND PUBLIC UTILITIES.
9. THE CONTRACTOR SHALL MAINTAIN ADEQUATE DRAINAGE AND EROSION CONTROL MEASURES THROUGHOUT THE PROJECT.
10. THE CONTRACTOR SHALL BE RESPONSIBLE FOR THE REMOVAL AND DISPOSAL OF ALL EXCESS MATERIAL AND DEBRIS.

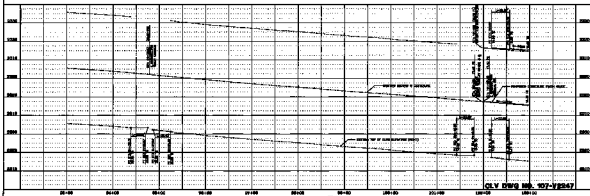

CLV DRG NO. 107-V247

AS BUILT



ROADWAY PLAN AND PROFILE
FROM STATION 95+00 TO 103+00
SECTION 107-V247



C4

16-2-61