



2 1


MATCH LINE - SEE SHEET 4

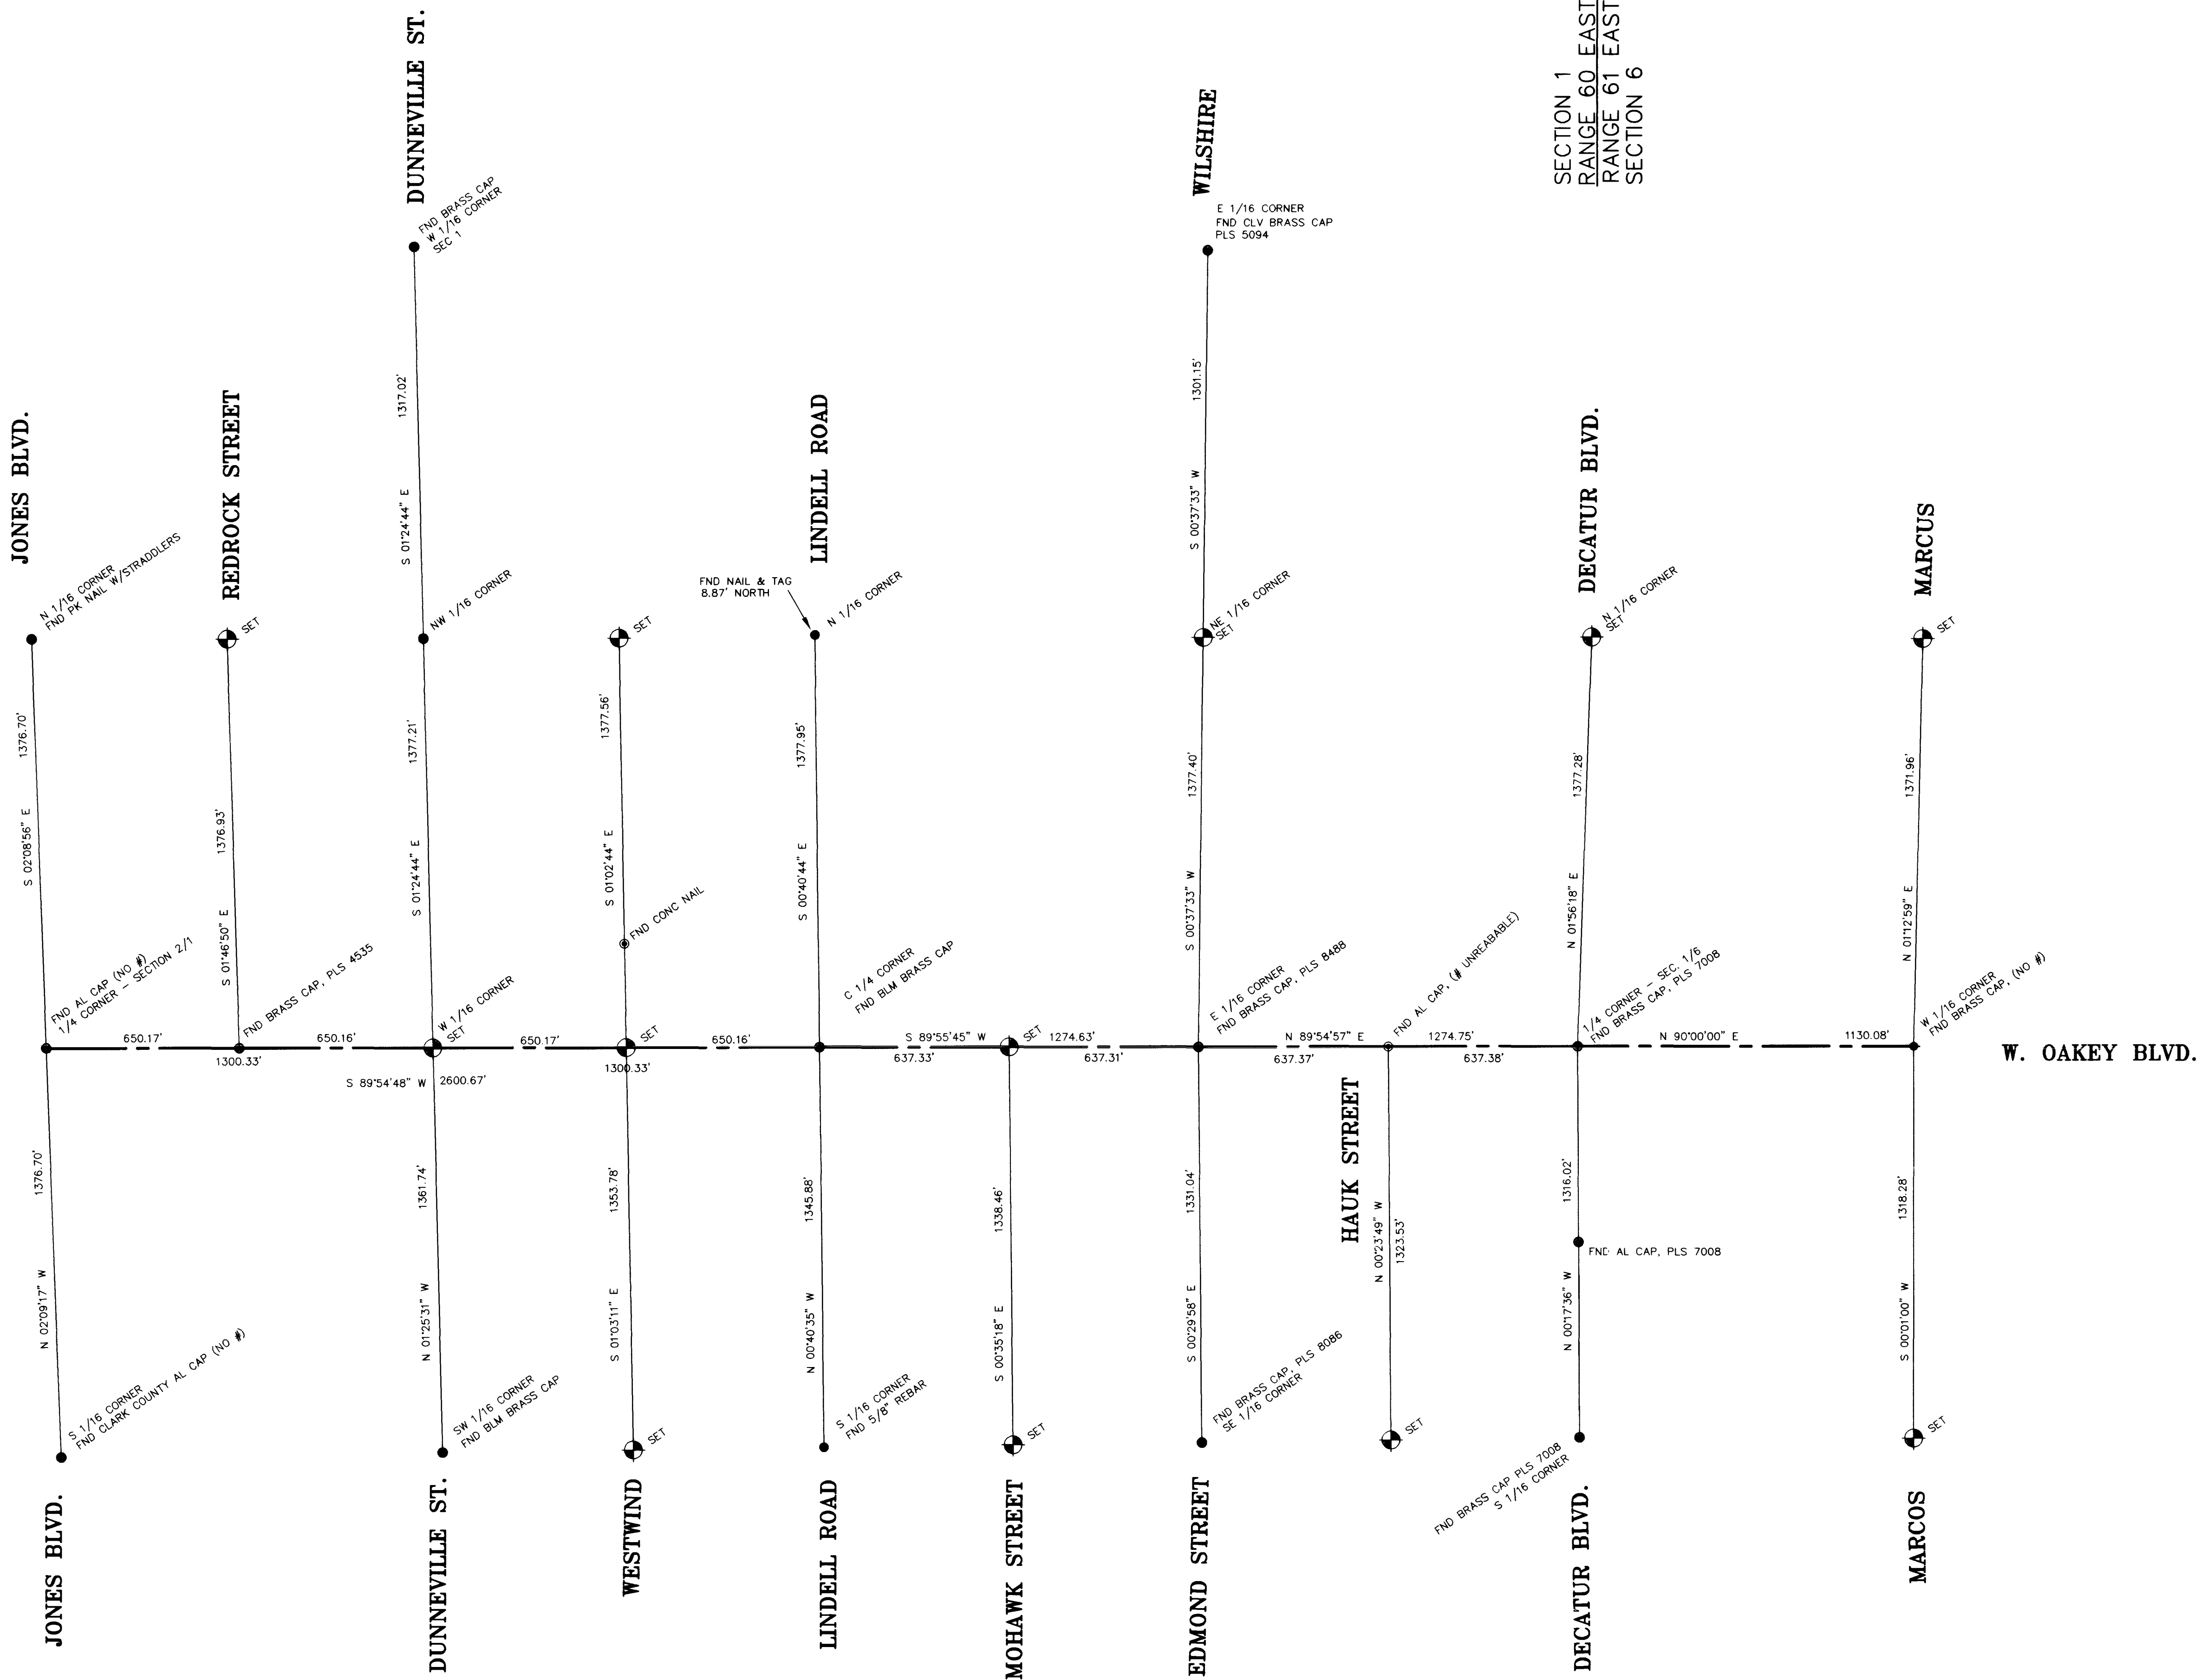

SECTION 1
RANGE 60 EAST
SECTION 6
RANGE 61 EAST

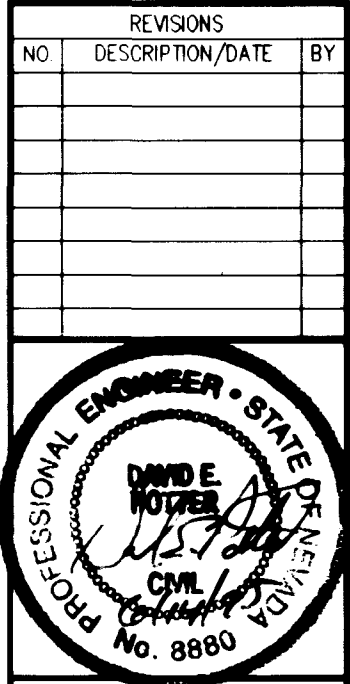

1100 GRIER DRIVE
LAS VEGAS, NEVADA 89119
PHONE (702) 361-9050
FAX (702) 361-0659

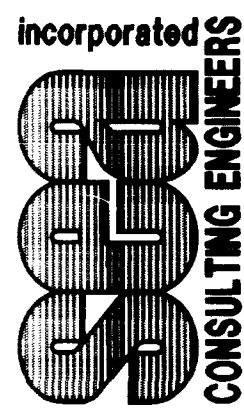

HORIZONTAL SURVEY CONTROL
OAKLEY BLVD
RAINBOW BLVD TO DECATUR BLVD

NEVADA

CLARK COUNTY

CITY OF LAS VEGAS

JOB NO.:	2-241-073
ACAD FILE:	071ECL2
DESIGNED:	MC
DRAWN:	MC
CHECKED:	DP
DATE:	JUNE 1995

6


6 OF 62 SHEETS

CLV DWG NO. 107-V2247

AS BUILT

MATCH LINE - SEE SHEET 4

21

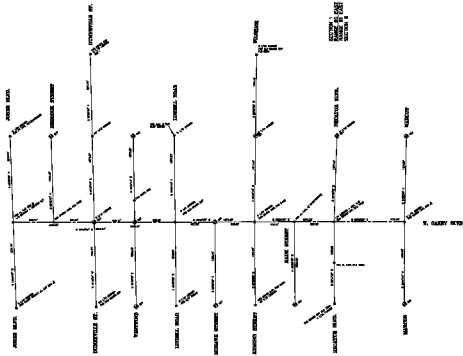

SECTION 1
SECTION 2
SECTION 3
SECTION 4
SECTION 5
SECTION 6
SECTION 7
SECTION 8



CLV DWG NO. 107-V2247

THIS DRAWING IS THE PROPERTY OF THE
CLV ENGINEERING FIRM, INC.
IT IS TO BE USED ONLY FOR THE PROJECT
FOR WHICH IT WAS PREPARED.
IT IS NOT TO BE REPRODUCED OR
TRANSMITTED IN ANY FORM OR BY ANY
MEANS, ELECTRONIC OR MECHANICAL,
INCLUDING PHOTOCOPYING, RECORDING,
OR BY ANY INFORMATION STORAGE AND
RETRIEVAL SYSTEM, WITHOUT THE
WRITTEN PERMISSION OF CLV ENGINEERING
FIRM, INC.

HORIZONTAL SURVEY CONTROL
KENTON BLVD TO KENTON RD

DATE	10/1/88
BY	J. M. JONES
CHECKED BY	J. M. JONES
APPROVED BY	J. M. JONES

6