


6-6-164

PAINTED DESERT


A PLANNED RESIDENTIAL DEVELOPMENT

A PORTION OF THE N1/2 AND THE SE1/4 OF SECTION 34 AND A PORTION OF THE N1/2 OF SECTION 33, T 19 S, R 60 E, M.D.M., CITY OF LAS VEGAS, CLARK COUNTY, NEVADA.

- LEGEND**
- ◆ SET BRASS CAP & CONC. IN WELL (TYPE I)
 - ▲ SET BRASS CAP & CONC. (TYPE II)
 - SET REBAR & AL. CAP
 - SET BRASS CAP IN TOP OF CURB (TYPE III A)

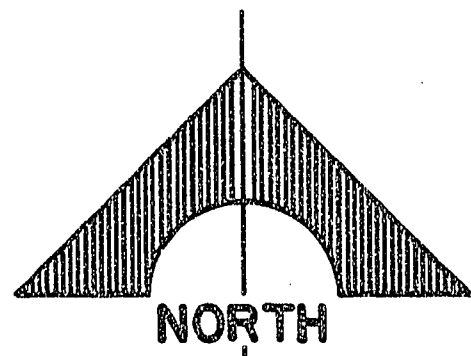

SCALE: 1" = 100'

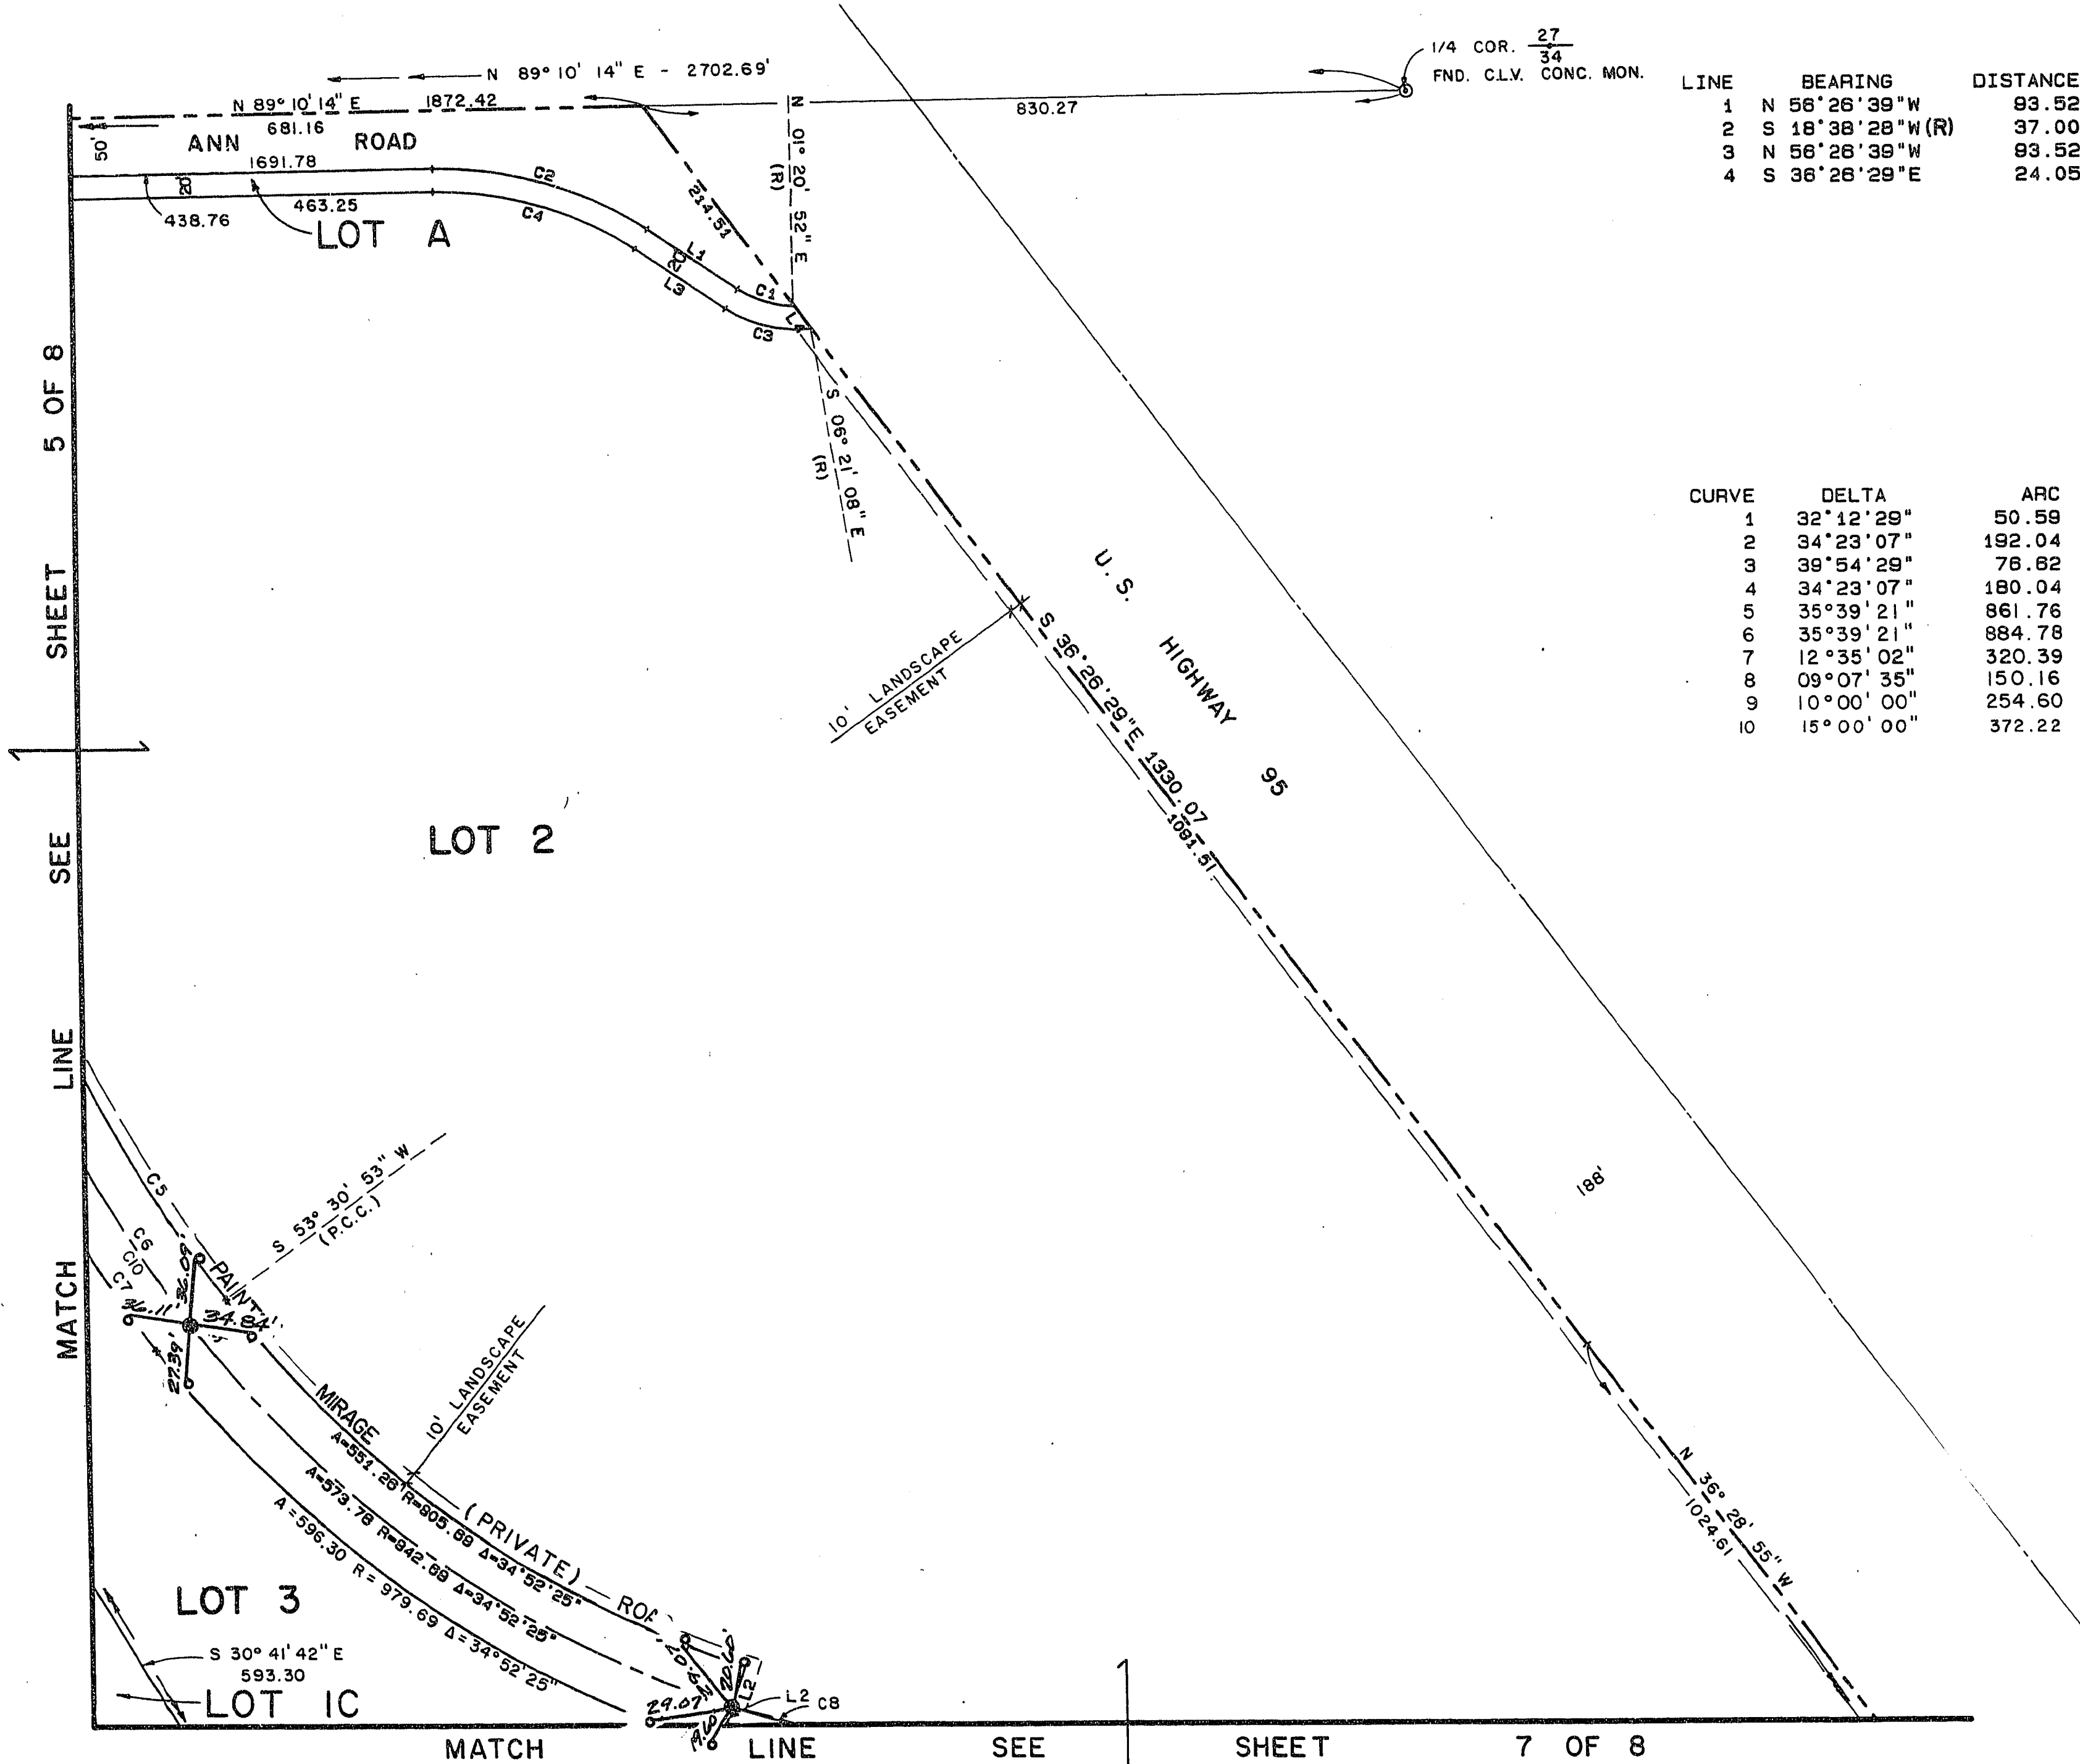

LINE	BEARING	DISTANCE
1	N 58°26'38"W	83.52
2	S 18°38'28"W (R)	37.00
3	N 58°26'38"W	83.52
4	S 38°26'28"E	24.05

CURVE	DELTA	ARC	RADIUS	TANGENT
1	32°12'29"	50.59	80.00	25.98
2	34°23'07"	192.04	320.00	98.01
3	38°54'29"	78.82	110.00	38.94
4	34°23'07"	180.04	300.00	92.62
5	35°39'21"	861.76	1384.77	445.35
6	35°39'21"	884.78	1421.77	457.24
7	12°35'02"	320.39	1458.77	160.84
8	09°07'35"	150.16	942.69	75.24
9	10°00'00"	254.60	1458.77	127.63
10	15°00'00"	372.22	1421.77	187.18