

NOTICE!

EXISTING UTILITIES ARE SHOWN ON PLANS FOR THE CONVENIENCE OF THE CONTRACTOR ONLY. THE CONTRACTOR IS RESPONSIBLE FOR THE PROTECTION OF ALL UTILITIES. THE ENGINEER BEARS NO RESPONSIBILITY FOR UTILITIES NOT SHOWN OR SHOWN INCORRECTLY.



Call Before You Dig

1-800-227-2600

UNDERGROUND SERVICE COMPANY

UTILITY AS-BUILT MAP HIGHPOINTE AT SUMMERLIN UNIT 2

NOTE:
WATER METER AND SEWER SERVICE LOCATIONS AS SHOWN ON THIS MAP WERE PROVIDED BY THE CONTRACTOR, ALPHA ENGINEERING ASSUMES NO LIABILITY FOR MISPLACED SERVICES REPRESENTED ON THIS MAP.

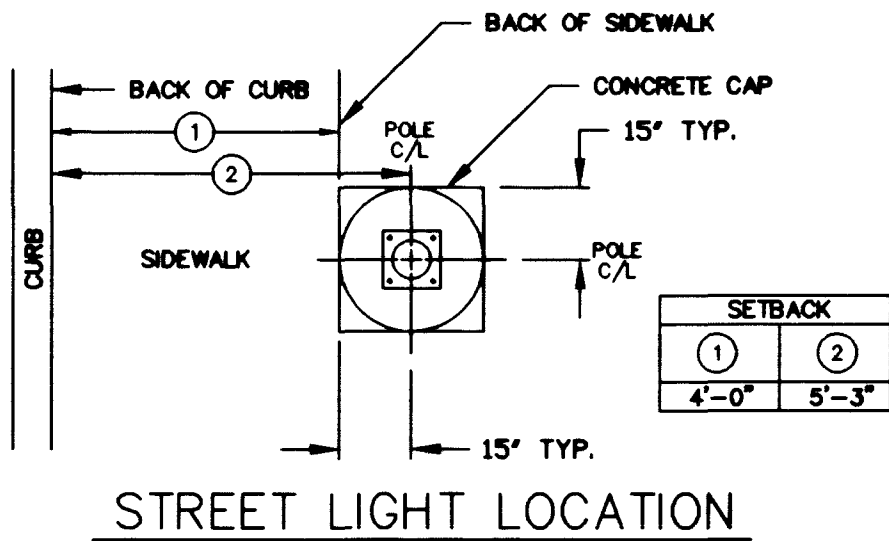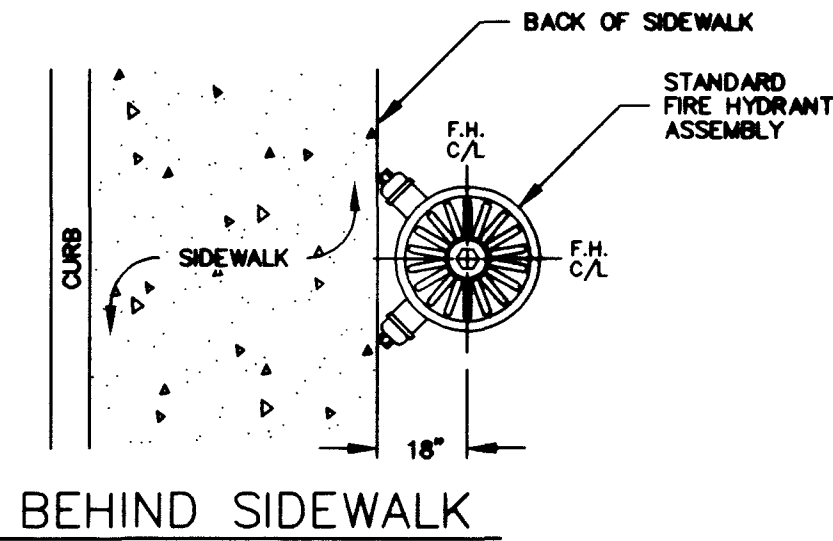

UNIT 2 QUANTITIES

WATER QUANTITIES

8" WATER	1620 L.F.
1 8" GATE VALVE	3 EA.
2 8" CROSS	1 EA.
STANDARD FIRE HYDRANT ASSEMBLY	4 EA.
3/4" WATER METER W/1" SERVICE	38 EA.
2" BLOWOFF	3 EA.

A 1" x 3/4" ANGLE METER STOP AND 3/4" METER BOX WILL BE REQUIRED WITH 1" SERVICE LATERALS FOR ALL SERVICES WITH 5/8" OR 3/4" SERVICES. DETAILS OF THE ABOVE INSTALLATION ARE AVAILABLE FROM THE ENGINEERING SERVICES DIVISION AND FROM THE DISTRICT'S INSPECTORS.

SERVICE LATERALS FOR LOT(S) 33 WILL BE TAPPED ON EXISTING MAIN BY OWNER'S CONTRACTOR UNDER DIRECTION OF THE LVVMD.

STREET LIGHT QUANTITIES

100 W TYPE 3 ST. LIGHT W/ POLE	10 EA.
1 1/4" CONDUIT W/ CABLE	1578 L.F.

SEWER QUANTITIES

8" SEWER	1595 L.F.
48" MANHOLE	7 EA.
SEWER SERVICE	35 EA.

STORM SEWER QUANTITIES

24" R.C.P.	159 L.F.
48" STORM MANHOLE	1 EA.
7.5' TYPE "C" DROP INLET	2 EA.

STREET SIGN QUANTITIES

STREET SIGN W/ POLE	3 EA.
---------------------	-------

ALPHA
ENGINEERING
COMPANY

UTILITY AS-BUILT MAP
HIGHPOINTE AT SUMMERLIN
UNIT 2

JOB # N4-78-15

NAME SMD

DATE 6 - 2 - 98

SCALE 1" = 40'

PAGE

1

7818UT2.DWG OF 1



UTILITY AS-BUILT MAP HIGHPOINT AT SUMMERLIN UNIT 2

THIS MAP IS A REPRODUCTION OF THE ORIGINAL MAP.
IT IS NOT TO BE USED FOR ANY OTHER PURPOSE.



UNIT 2 QUANTITIES

STREET LIGHT QUANTITIES

1" DIA. STREET LIGHT	100.00
2" DIA. STREET LIGHT	100.00
3" DIA. STREET LIGHT	100.00
4" DIA. STREET LIGHT	100.00
5" DIA. STREET LIGHT	100.00
6" DIA. STREET LIGHT	100.00
7" DIA. STREET LIGHT	100.00
8" DIA. STREET LIGHT	100.00
9" DIA. STREET LIGHT	100.00
10" DIA. STREET LIGHT	100.00

STREET LIGHT QUANTITIES

1" DIA. STREET LIGHT	100.00
2" DIA. STREET LIGHT	100.00

SEWER QUANTITIES

1" DIA. SEWER	100.00
2" DIA. SEWER	100.00
3" DIA. SEWER	100.00
4" DIA. SEWER	100.00
5" DIA. SEWER	100.00
6" DIA. SEWER	100.00
7" DIA. SEWER	100.00
8" DIA. SEWER	100.00
9" DIA. SEWER	100.00
10" DIA. SEWER	100.00

STORM SEWER QUANTITIES

1" DIA. STORM SEWER	100.00
2" DIA. STORM SEWER	100.00
3" DIA. STORM SEWER	100.00
4" DIA. STORM SEWER	100.00
5" DIA. STORM SEWER	100.00
6" DIA. STORM SEWER	100.00
7" DIA. STORM SEWER	100.00
8" DIA. STORM SEWER	100.00
9" DIA. STORM SEWER	100.00
10" DIA. STORM SEWER	100.00

STREET SIGN QUANTITIES

1" DIA. STREET SIGN	100.00
---------------------	--------

UNIT 2 PROJECT SEWER FLOW CONTRIBUTIONS

ADJUSTED FLOW	100.00
PROJECT FLOW	100.00

ALPHA
X

UTILITY AS-BUILT MAP
HIGHPOINT AT SUMMERLIN
UNIT 2

1