



RECORD OF SURVEY  
 MONUMENT TIE MAP  
 LOS LOMAS AT THE PASEOS PARCEL "F" @ VILLAGE 23A  
 A COMMON INTEREST COMMUNITY

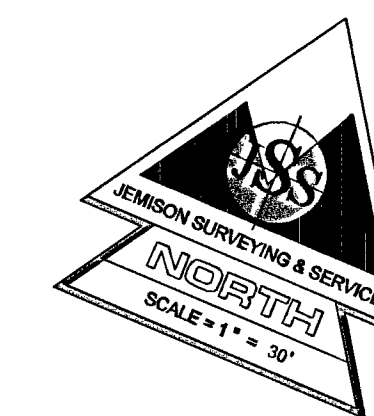

**LEGEND**

- ( NOTE: SOME SYMBOLS HAVE BEEN EXAGGERATED IN SCALE FOR CLARITY )
- FOUND MONUMENT PLS 8352 UNLESS NOTED OTHERWISE
  - SET TYPE IV REFERENCE MONUMENT PLS 10598
  - STREET CENTERLINE
  - - - RIGHT-OF-WAY/LOT LINE

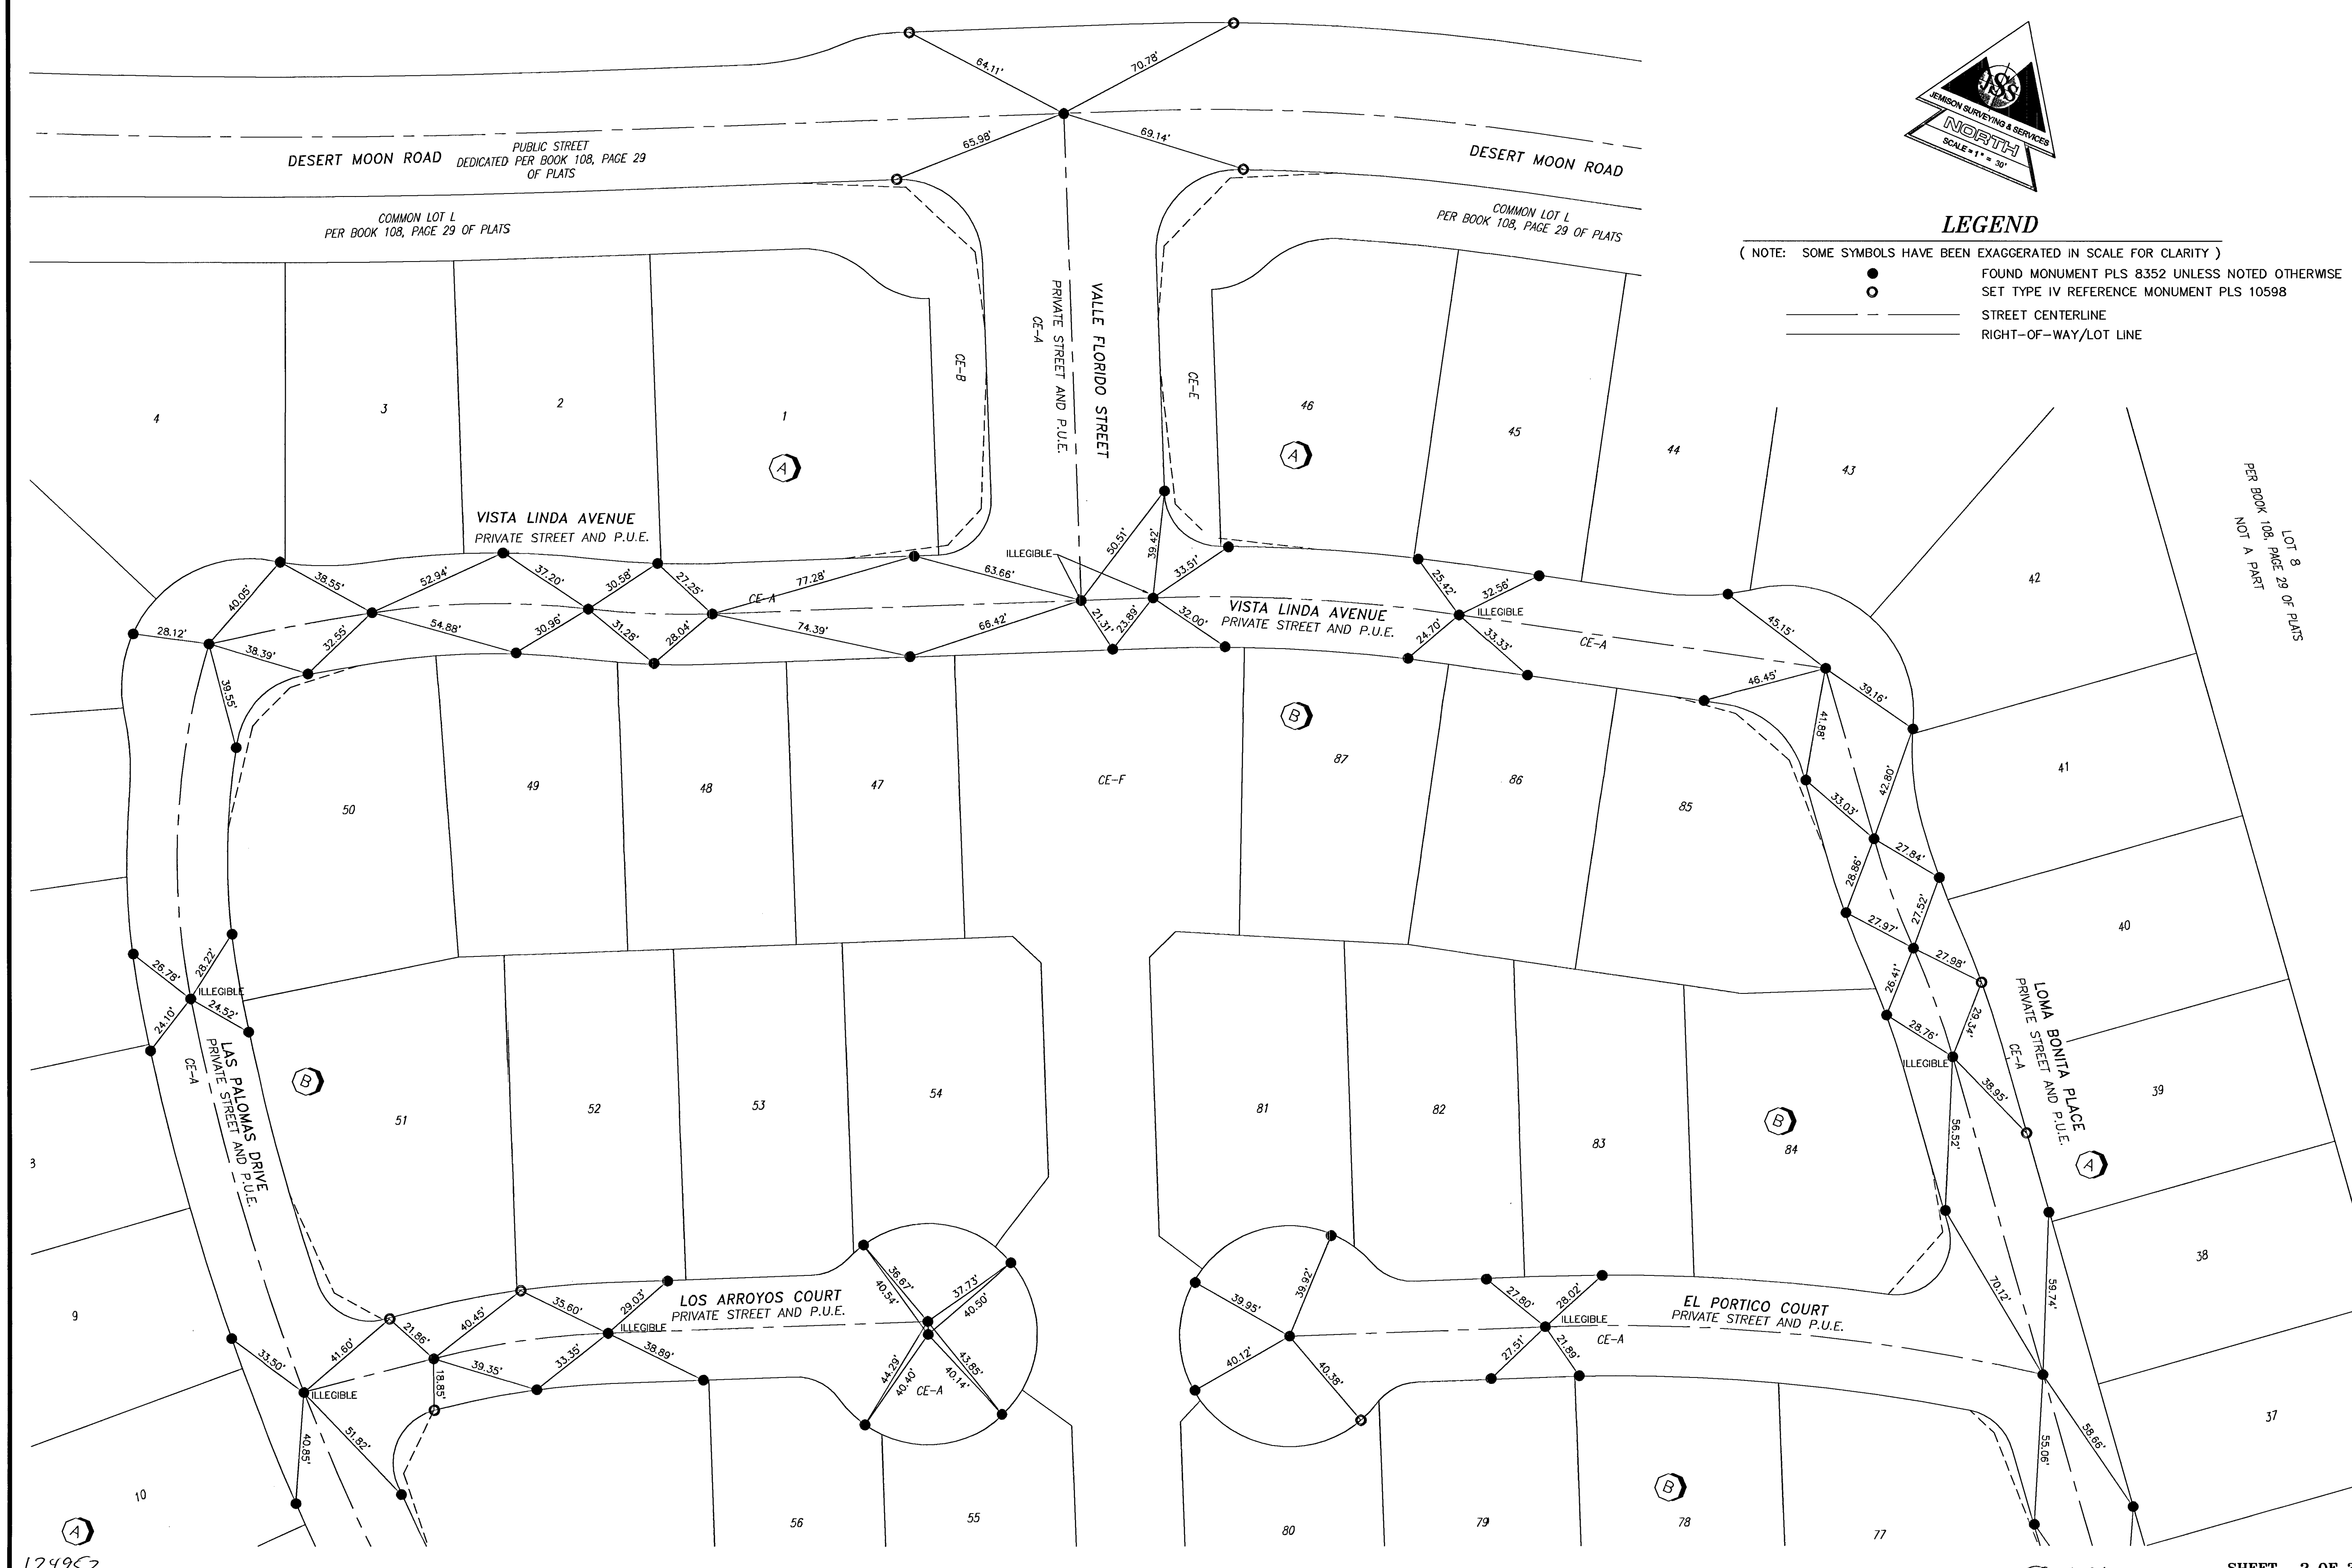

124952

058-4791