

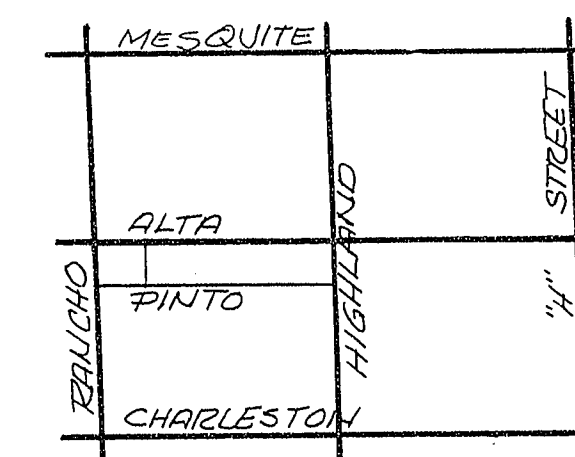


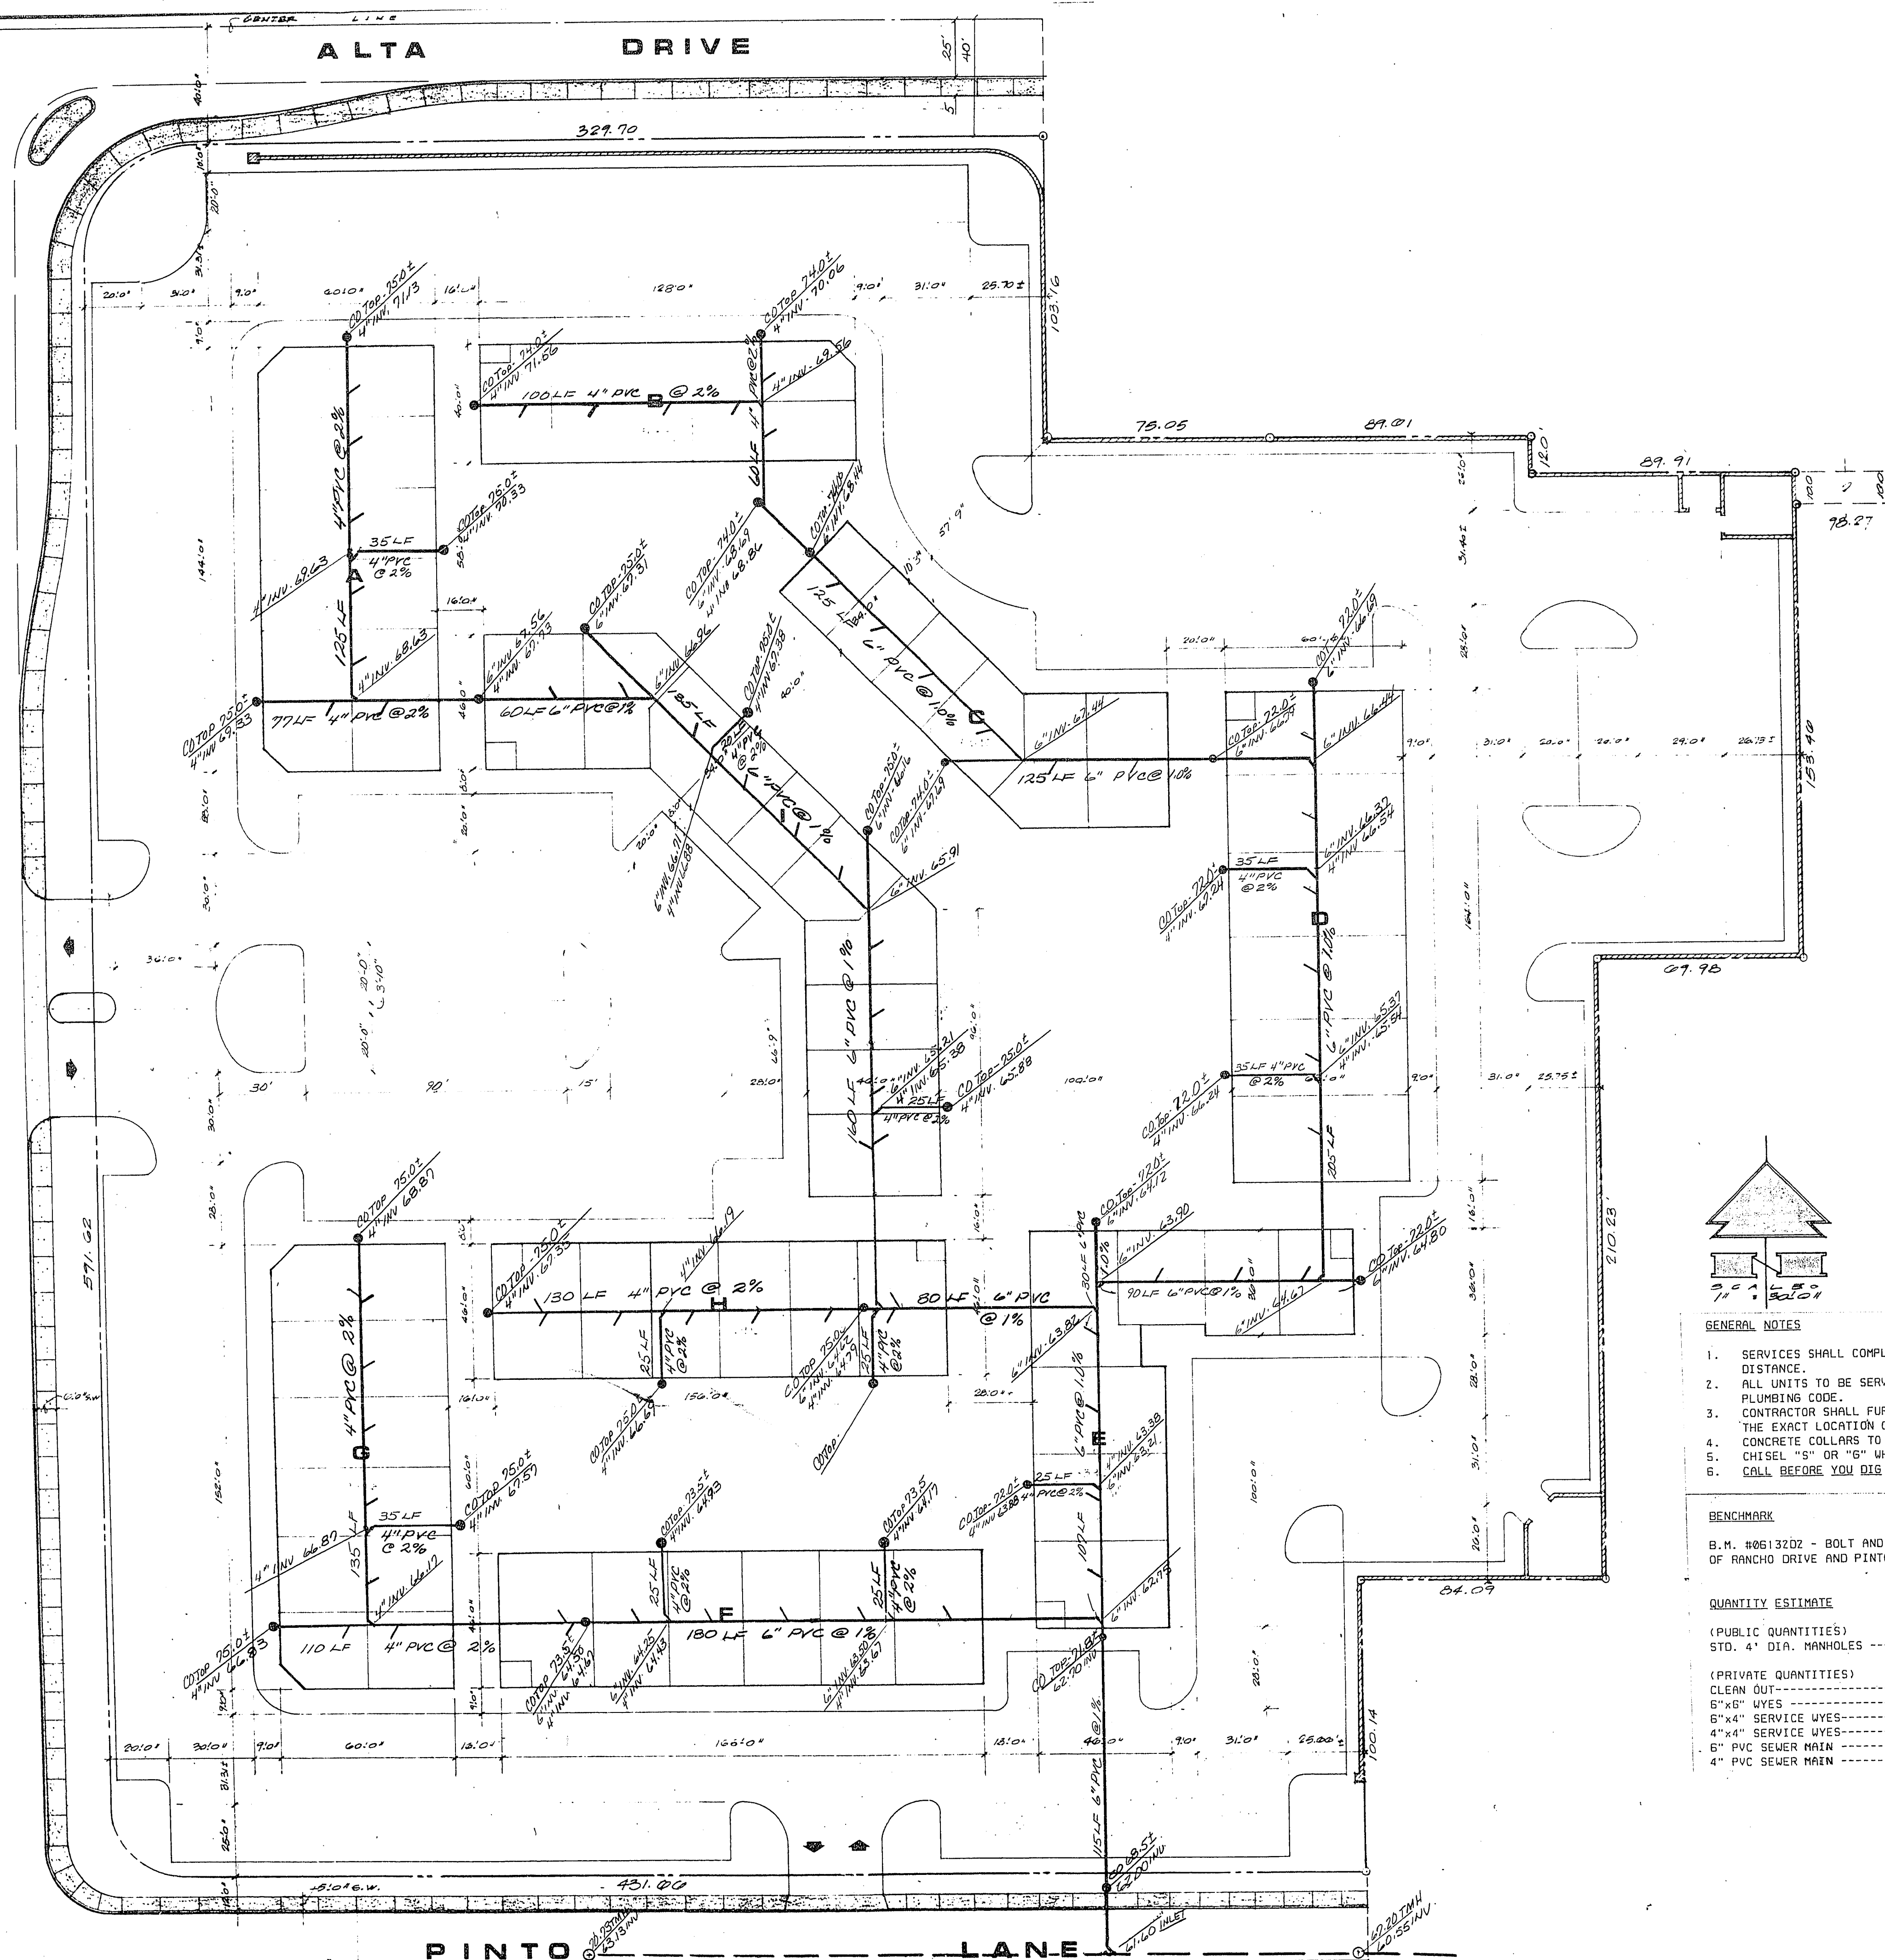

VICINITY MAP

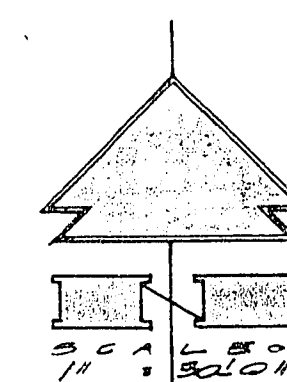

GENERAL NOTES

1. SERVICES SHALL COMPLY WITH WESTERN PLUMBING CODE AS TO SEPARATION DISTANCE.
2. ALL UNITS TO BE SERVED INDIVIDUALLY AS PER SECTION 313 OF THE UNIFORM PLUMBING CODE.
3. CONTRACTOR SHALL FURNISH THE ENGINEER WITH AS-BUILT DRAWINGS SHOWING THE EXACT LOCATION OF ALL CONNECTIONS.
4. FIREPROOF COLLARS TO BE CONSTRUCTED AROUND ALL MANHOLES AND WATER VALVES.
5. CHISEL "S" OR "C" WHEREVER SEVER OF GAS LINES PASS UNDER THE CURB.
6. CALL BEFORE YOU DIG 1-800-272-2600

BENCHMARK

B.M. #0613202 - BOLT AND PLATE IN TOP OF CURB AT NORTHWEST CURB RETURN
OF RANCHO DRIVE AND PINTO LANE. ELEVATION = 2073.70 CLV DATUM

QUANTITY ESTIMATE

(PUBLIC QUANTITIES)
STD. 4' DIA. MANHOLES ----- O EA

(PRIVATE QUANTITIES)

CLEAN OUT-----	<u>32</u>	EA
6"x6" WYES-----	<u>9</u>	EA
6"x4" SERVICE WYES-----	<u>45</u>	EA
4"x4" SERVICE WYES-----	<u>34</u>	EA
6" PVC SEWER MAIN-----	<u>142</u>	LF
4" PVC SEWER MAIN-----	<u>287</u>	LF

APPROVALS

H. C. Antos 4-9-85
C.L.V. SANITATION ENGINEER Date

C.L.V. CITY ENGINEER Date

CITY'S ORIGINAL WAS SIGNED BY :
G.L.V. QUALITY CONTROL JIMMY SINGH. Date

Michael S. Kazumic

REVISED

Journal of

Discussion

Abstract

MASTER SEWER PLAN

QUAIL PARK III

CONSULTING ENGINEERS • PLANNERS
2300 PASEO DEL PRADO BUILDING A SUITE 100
LAS VEGAS, NEVADA 89102 PHONE (702) 873-7550

nevada
3-4-85

7

OF 7 SHEETS