

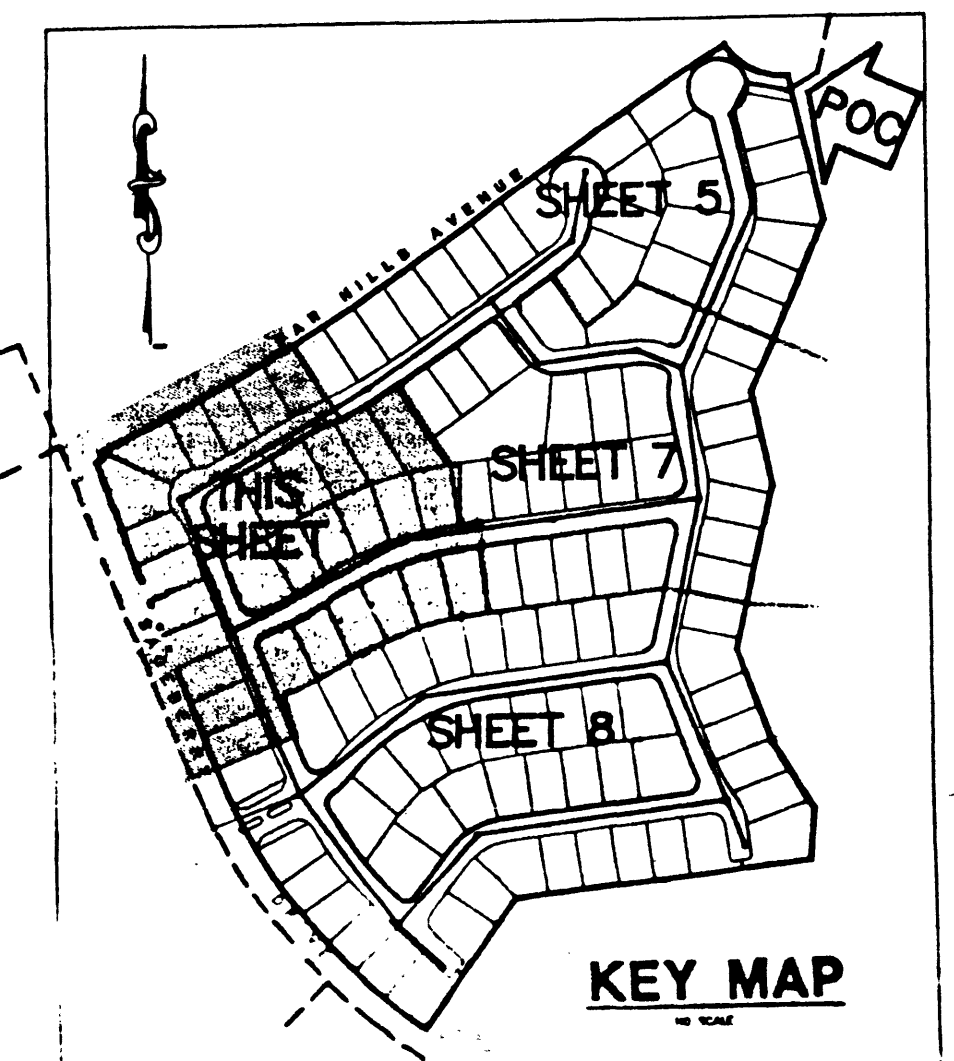
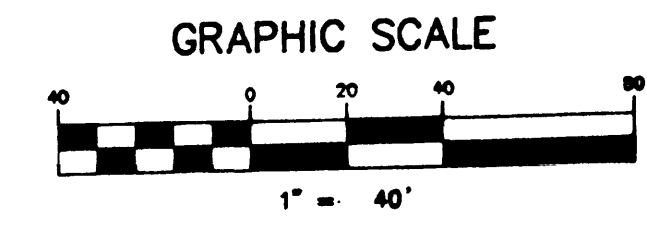


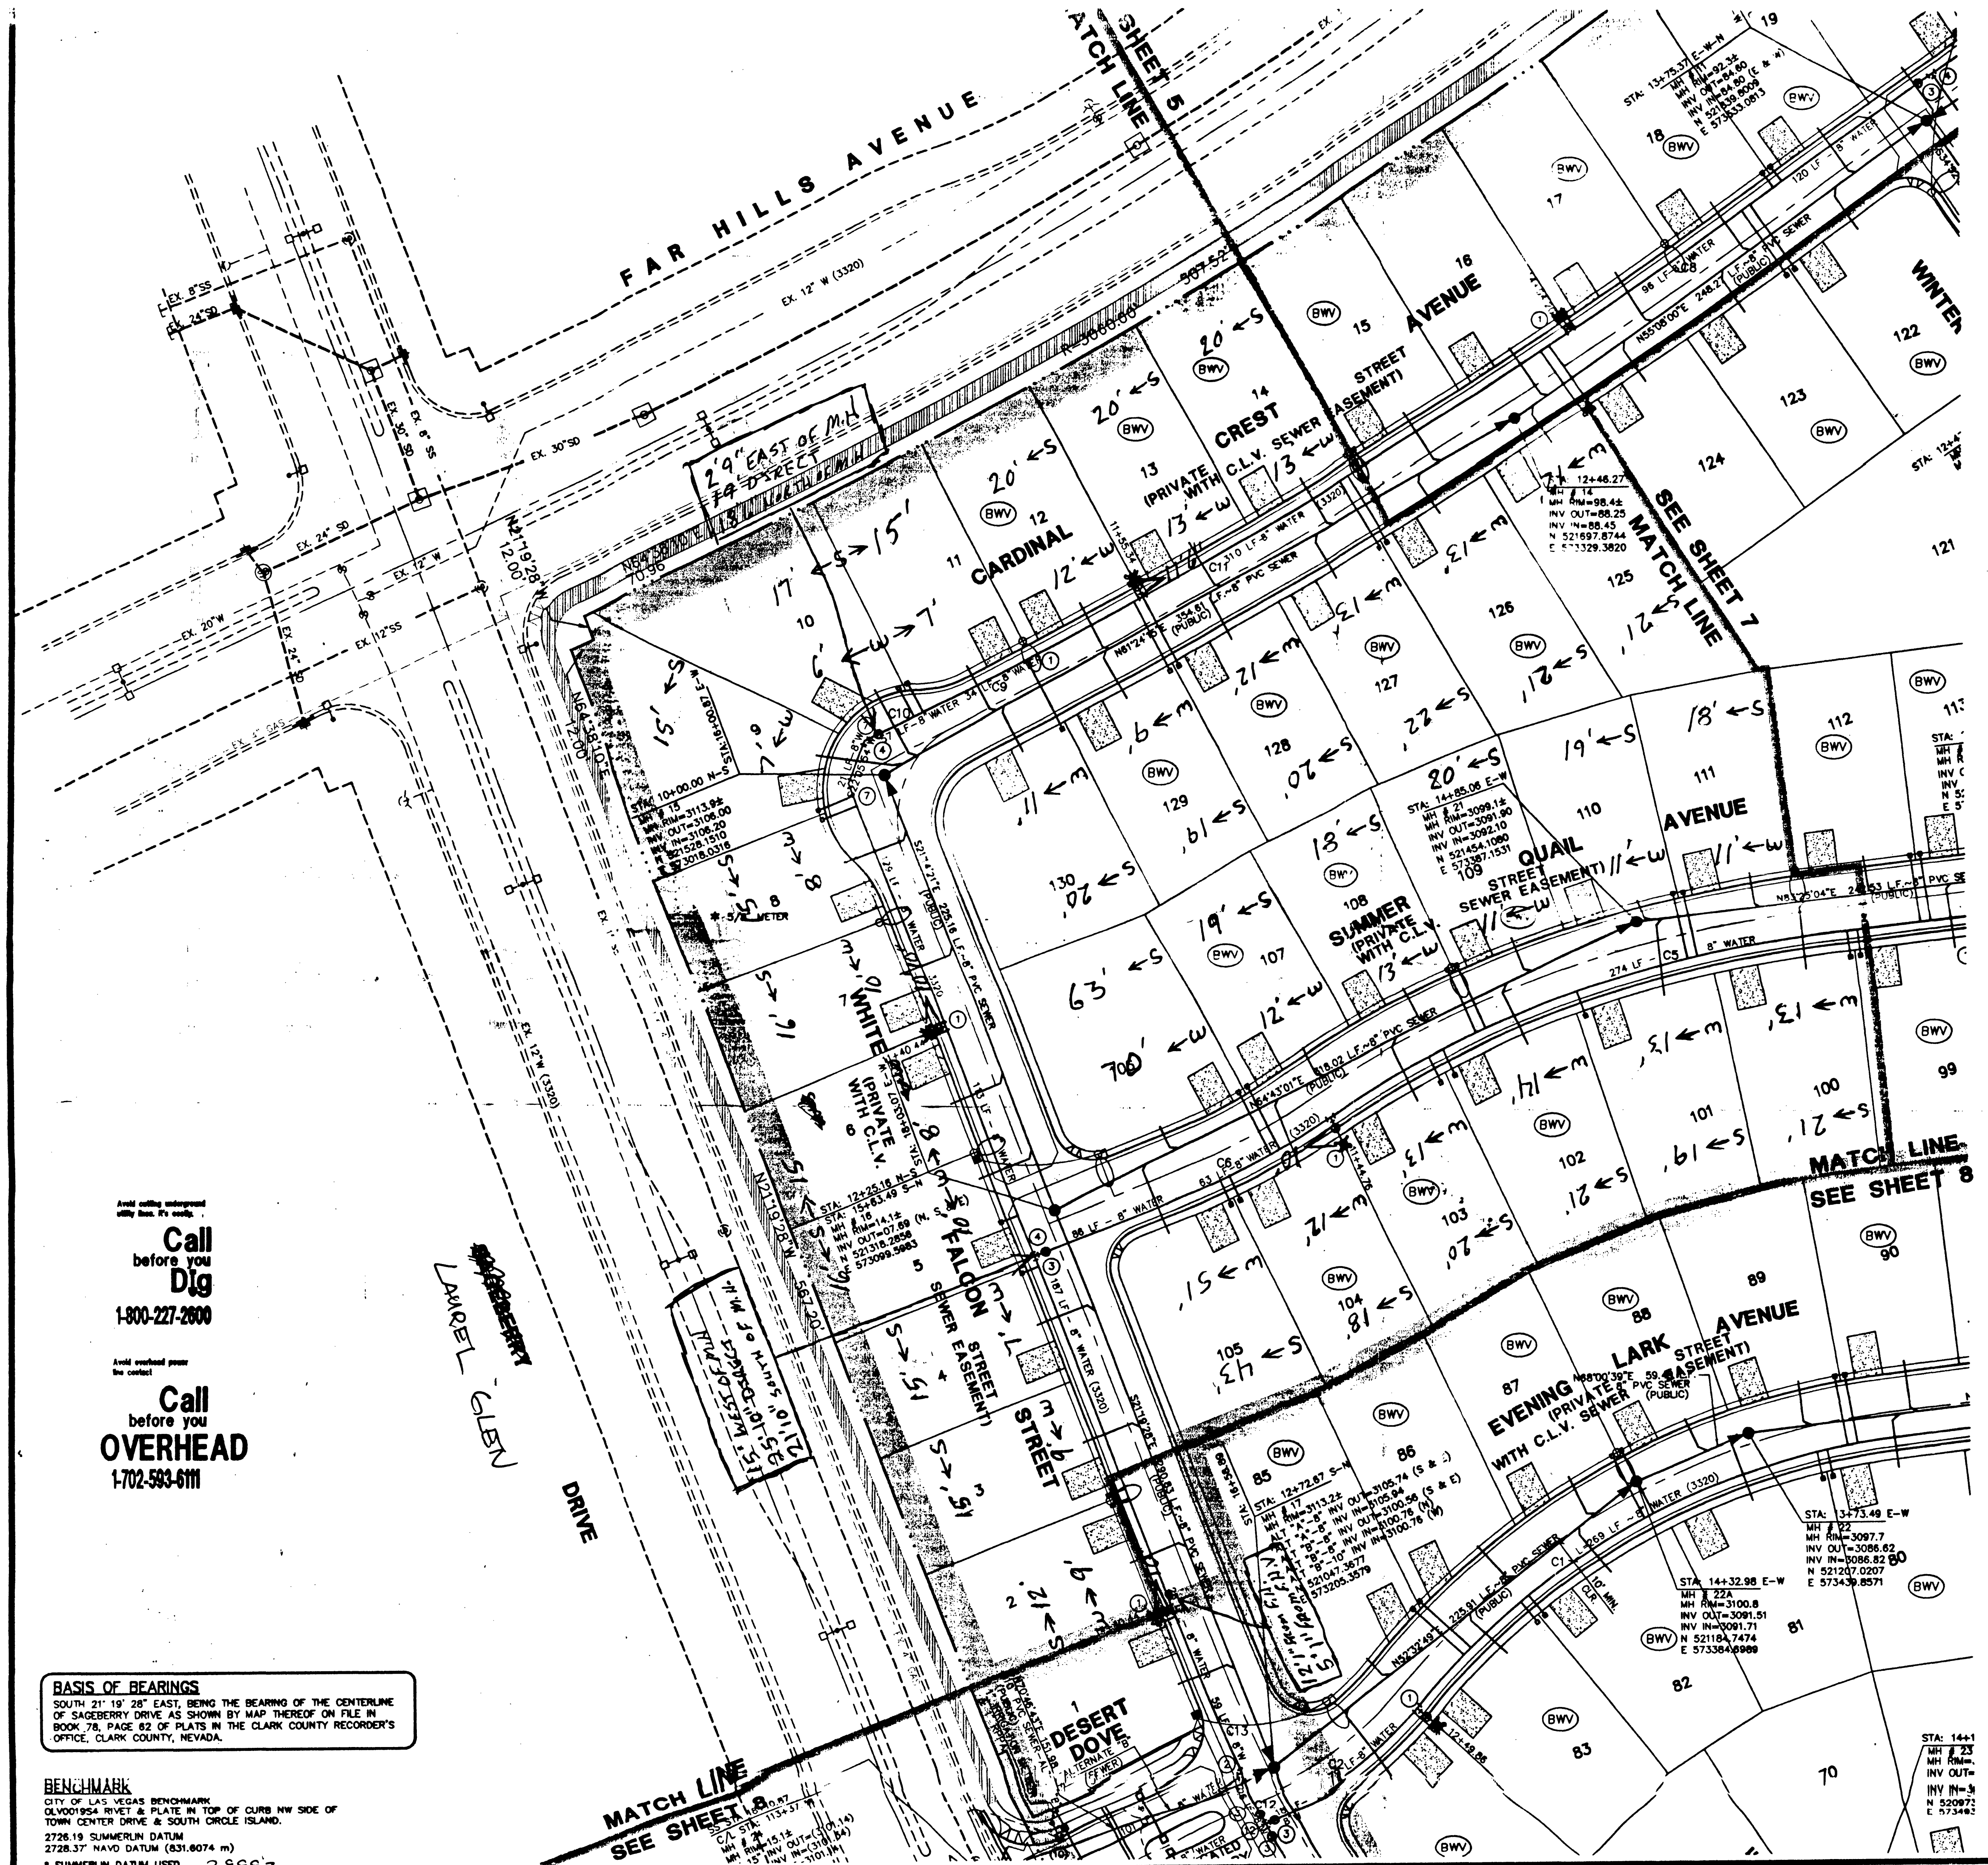

CURVE	LENGTH	RADIUS	TANGENT	DELTA
C2	79.33	187.50	40.27	241°43'4"
C5	273.83	598.00	139.38	28°19'29"
C6	63.17	312.50	31.69	11°34'52"
C8	98.09	3178.00	48.05	01°44'00"
C9	33.82	3178.00	18.91	00°38'38"
C10	56.88	3188.00	28.43	01°01'18"
C11	310.18	3178.00	155.22	05°35'48"
C12	25.65	838.00	12.82	01°45'13"
C13	58.38	838.00	29.20	03°58'28"

NOTE:
FOR LEGEND & ESTIMATE OF QUANTITIES,
SEE SHEET 5

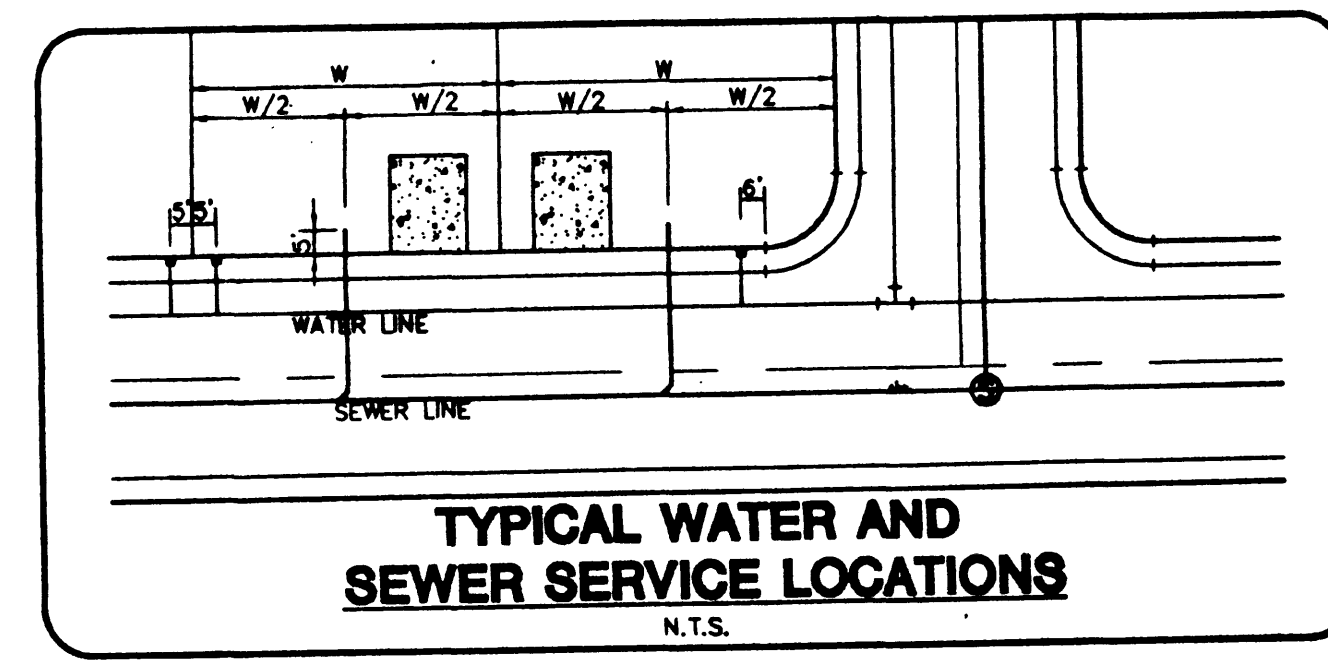

ASBUILT
WESTERN WATER CONTRACTING
LAS VEGAS, NV
DATE: 7-2-98

Call before you Dig
1-800-227-2600

Call before you OVERHEAD
1-702-593-6111

BASIS OF BEARINGS
SOUTH 21° 19' 28" EAST, BEING THE BEARING OF THE CENTERLINE OF SAGEBERRY DRIVE AS SHOWN BY MAP THEREOF ON FILE IN BOOK 78, PAGE 62 OF PLATS IN THE CLARK COUNTY RECORDER'S OFFICE, CLARK COUNTY, NEVADA.

BENCHMARK
CITY OF LAS VEGAS BENCHMARK
CLV001954 RIVET & PLATE IN TOP OF CURB NW SIDE OF TOWN CENTER DRIVE & SOUTH CIRCLE ISLAND.
2726.19 SUMMERLIN DATUM
2728.37 NAVD DATUM (831.6074 m)
* SUMMERLIN DATUM USED.

WOODSIDE HOMES

DESIGNED BY: MT/MLA

CHECKED BY: DLE

PROJECT NO: 3074-4552

MASTER UTILITY PLAN

QUAIL RIDGE

DATE: FEB. 1998

DATE: DECEMBER 1997

DATE: DECEMBER 1997

SCALE: 40' HORIZ.

SCALE: N.A. VERT.

SEAL

PROFESSIONAL ENGINEER

BARRY R. THOMPSON

CIVIL

NO. 12551

EXPIRATION DATE: 7/1/98

SHEET

C6

6 OF 35 SHEETS

DRAWING NO. 3074-4552

