
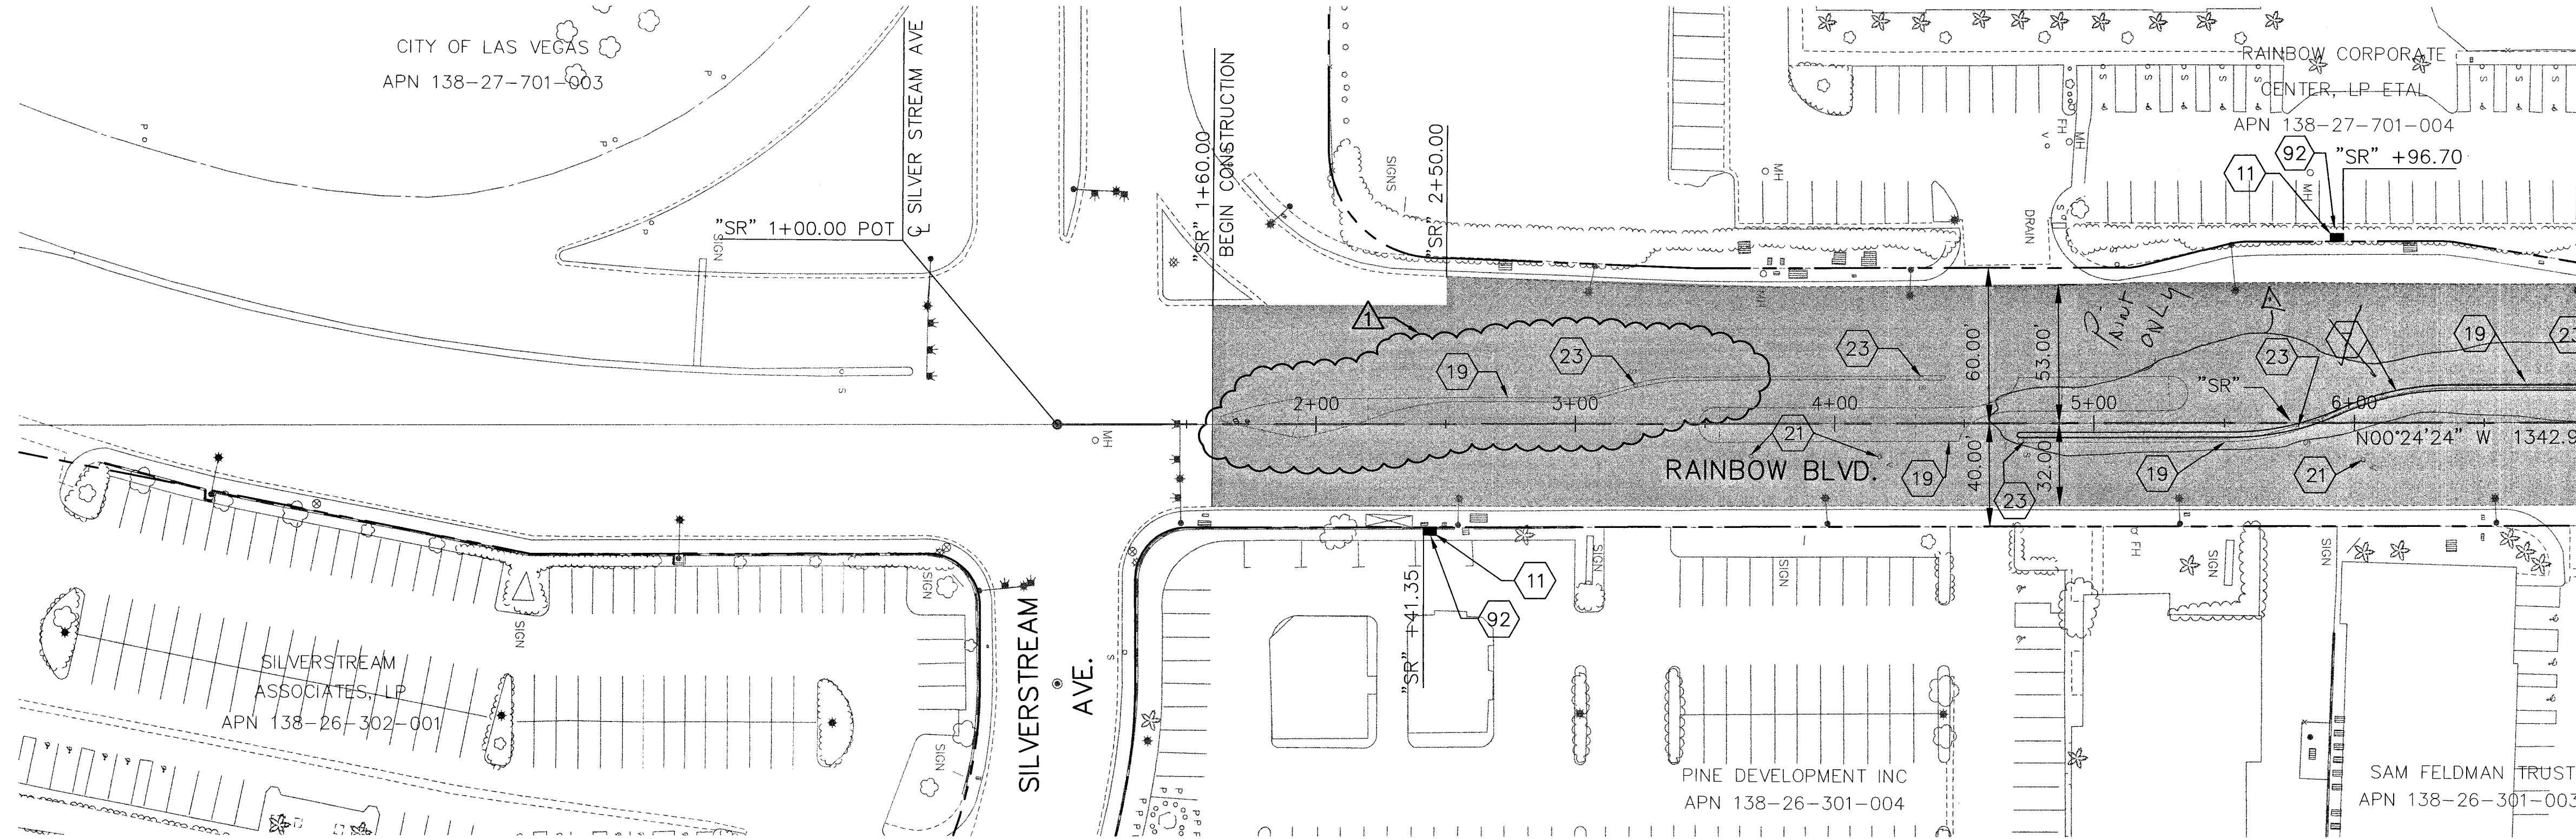


NAME: P:\W7X70800\700CADD\702CIVIL\702DWG\70800-rd01.DWG DATE: JAN 13, 2004 TIME: 11:49 AM

40' 20' 0 40' 80'
SCALE: 1" = 40'

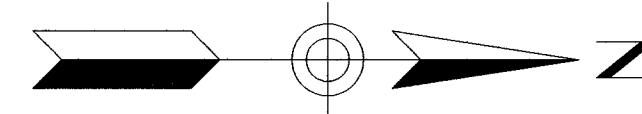


MATCH LINE "SR" 7+00 SEE SHEET S-2

- NOTES:
- 11 CONSTRUCT TACK-ON ISLAND (USD, DWG. NO. 221)
 - 19 CONSTRUCT BUS STOP LOADING PAD WITHIN EASEMENT (USD, DWG. NO. 234.2)
 - 21 REMOVE TACK-ON ISLAND
 - 23 ADJUST WATER VALVE BOX TO FINISHED GRADE PER UDACS PLATE NO. 8 (VALVE SHALL BE ACCESSIBLE AT ALL TIMES)
 - 23 REMOVE SIGN AND POST
 - 92 RESTORE LANDSCAPING AND IRRIGATION TO MATCH EXISTING (REPLACE IN KIND)

BASIS OF BEARINGS
NORTH 00°05'50" WEST, BEING THE BEARING OF THE WEST LINE OF THE SOUTHWEST QUARTER (SW 1/4) OF THE SOUTHWEST QUARTER (SW 1/4) OF SECTION 23, T. 20 S., R. 60 E., M.D.M., CLARK COUNTY, NEVADA, AS SHOWN ON FILE 80 OF PARCEL MAPS, AT PAGE 46.

BENCHMARK
CITY OF LAS VEGAS BENCHMARK: 1LV00 26W4 RIVET IN TOP OF CURB, NORTHEAST RETURN OF RAINBOW BLVD AND WASHINGTON AVE. ELEV. = 724.7549 METERS (PUBLISHED NAVD'88)
ELEV. = 2377.80 U.S. SURVEY FEET (CALCULATED NAVD'88)
CITY OF LAS VEGAS BENCHMARK: 0LV00 14WS RIVET AND PLATE IN TOP OF CURB, NORTHEAST RETURN OF SMOKE RANCH RD AND LORENZ BLVD. ELEV. = 708.7363 METERS (PUBLISHED NAVD'88)
ELEV. = 2325.25 U.S. SURVEY FEET (CALCULATED NAVD'88)

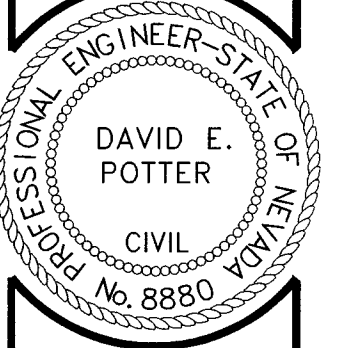

STAMP DATE:

SVERDRUP
CIVIL, INC.
5450 W. SUMMIT AVE. SUITE 150
LAS VEGAS, NV 89119
PHONE: (702) 670-1730
FAX: (702) 670-1731

RAINBOW BOULEVARD
SILVERSTREAM AVE. TO SMOKE RANCH ROAD
ROADWAY PLAN & PROFILE
"SR" 1+00 TO "SR" 7+00

SHEET
S-1
24 OF 110 SHEETS
DRAWING NO.
107-V3519

SEE SHEETS MD-1 THRU MD-9 FOR
MEDIAN ISLAND CONSTRUCTION
INFORMATION

LEGEND

MILL AND OVERLAY

LEFT SIDE TC PROFILE

CENTERLINE PROFILE

RIGHT SIDE TC PROFILE

EXISTING SURFACE


PROPOSED SURFACE

EXISTING SURFACE

EXISTING SURFACE

AS-BUILT

NOTE: NEW CENTERLINE PROFILE FOR
REFERENCE ONLY ON MILL AND OVERLAY
SECTIONS. USE TYPICAL SECTIONS FOR
NEW MILL/OVERLAY CONSTRUCTION.

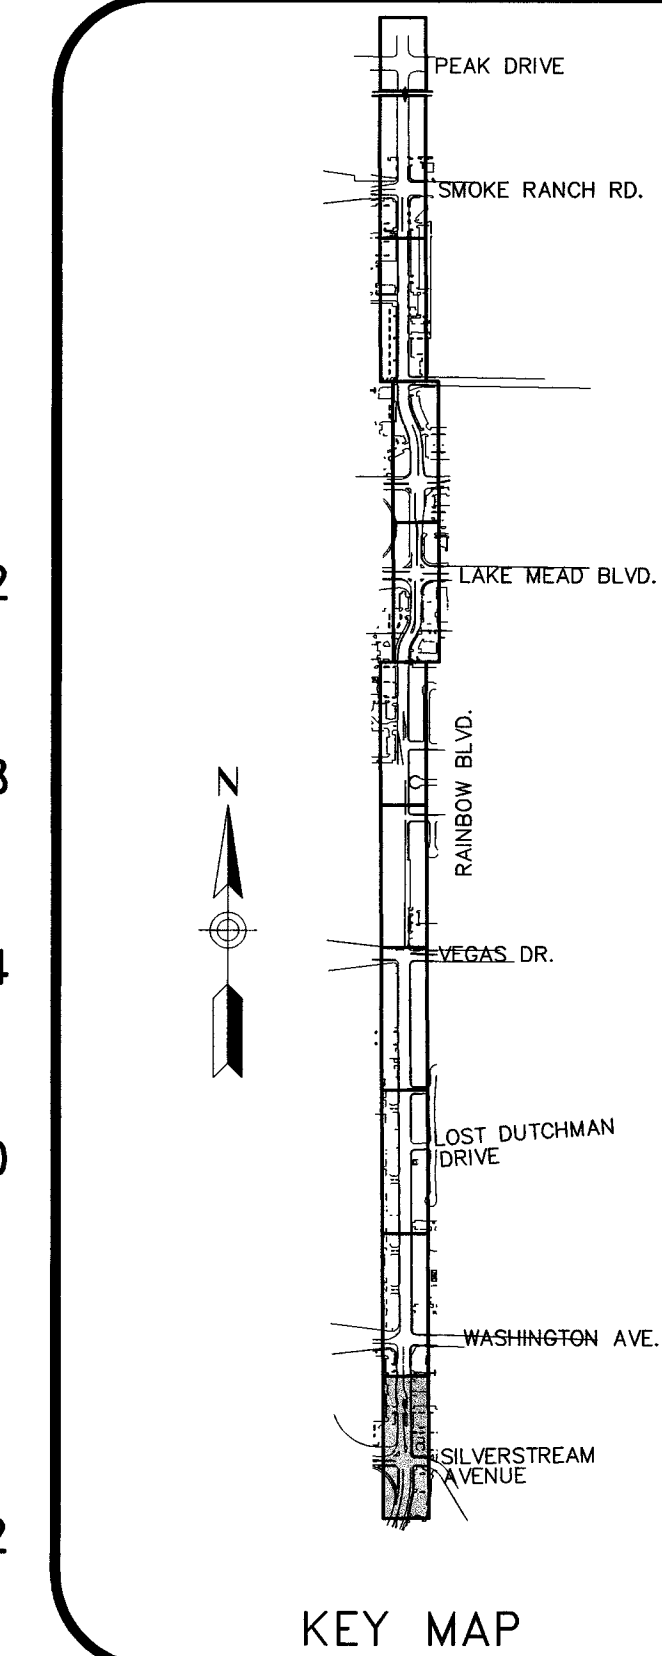

KEY MAP

Las Vegas Valley Water District Date

Call
before you
Dig.
1-800-227-2600

UNDERGROUND SERVICE (USA)
AND
CLARK COUNTY TRAFFIC MANAGEMENT
OPERATIONS UNIT (702) 455-7544

