
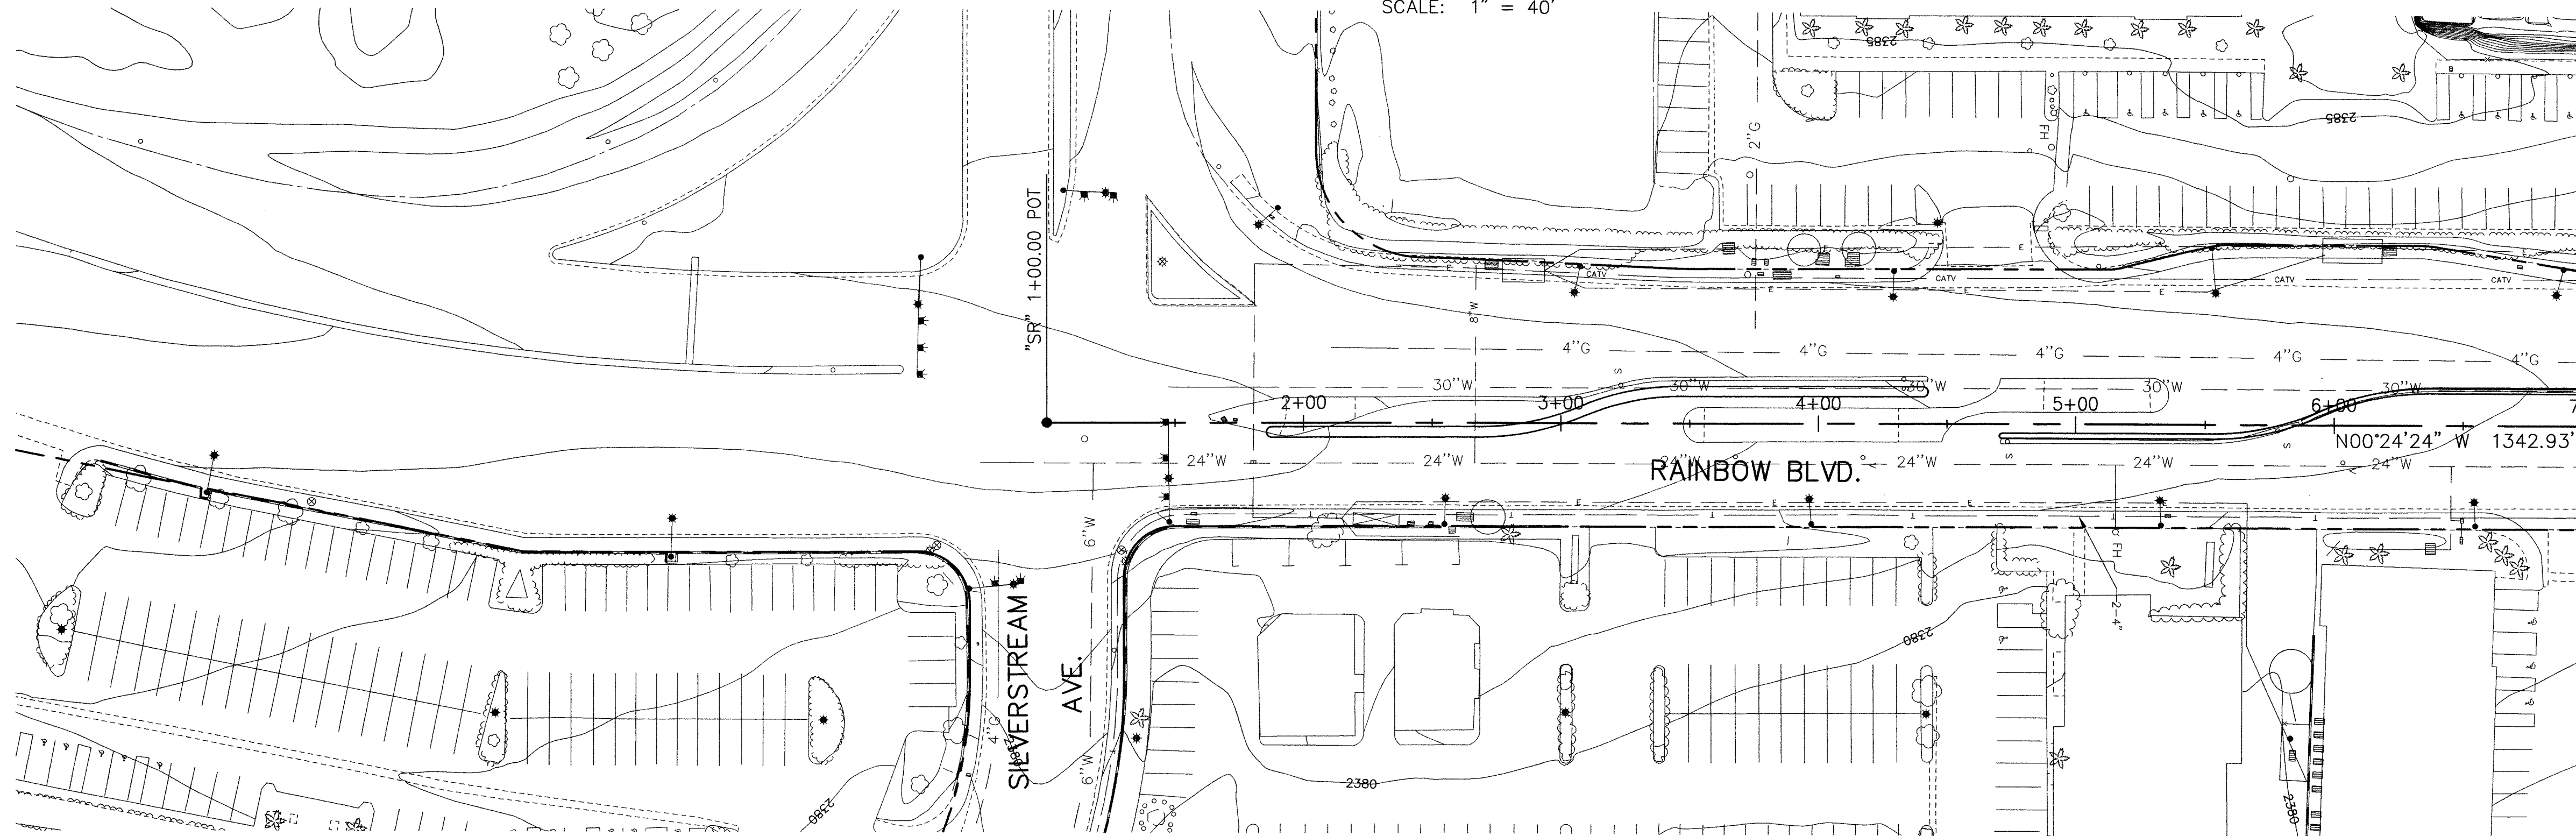


NAME: P:\W7X70800\700CADD\702CIVIL\702DWG\70800-sd01.dwg DATE: FEB 25, 2002 TIME: 10:23 AM


40' 20' 0 40' 80'
SCALE: 1" = 40'

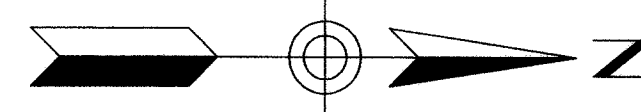

MATCH LINE "SR" 7+00 SEE SHEET SD-2

NOTES:

BASIS OF BEARINGS
NORTH 00°05'50" WEST, BEING THE BEARING OF
THE WEST LINE OF THE SOUTHWEST QUARTER
(SW 1/4) OF THE SOUTHWEST QUARTER (SW 1/4)
OF SECTION 23, T. 20 S., R. 60 E., M.D.M.,
CLARK COUNTY, NEVADA, AS SHOWN ON FILE 80
OF PARCEL MAPS, AT PAGE 46.
BENCHMARK
CITY OF LAS VEGAS BENCHMARK: 1LV00 26W4
RIVET AND PLATE IN TOP OF CURB, NORTHEAST
RETURN OF RAINBOW BLVD AND WASHINGTON AVE
ELEV. = 724.7549 METERS (PUBLISHED NAVD'88)
ELEV. = 2377.80 U.S. SURVEY FEET
(CALCULATED NAVD'88)
CITY OF LAS VEGAS BENCHMARK: 0LV00 14WS
RIVET AND PLATE IN TOP OF CURB, NORTHEAST
RETURN OF SMOKE RANCH RD AND LORENZI BLVD
ELEV. = 708.7363 METERS (PUBLISHED NAVD'88)
ELEV. = 2325.25 U.S. SURVEY FEET
(CALCULATED NAVD'88)

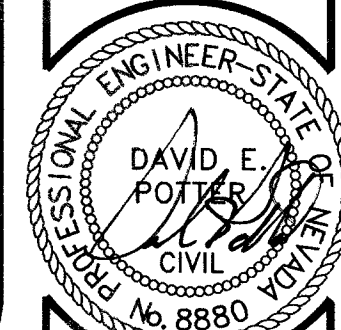


STAMP DATE: 2/25/02

Sverdrup
CIVIL, INC.
5450 W. SARAH AVE., SUITE 150
LAS VEGAS, NV 89119
PHONE (702) 870-7000
FAX (702) 870-1731


RAINBOW BOULEVARD
SILVERSTREAM AVE. TO SMOKE RANCH ROAD
STORM DRAIN PLAN & PROFILE
"SR" 1+00 TO "SR" 7+00

SHEET
SD-1
65 OF 110 SHEETS
DRAWING NO.
107-V3519

FOR INFORMATION ONLY

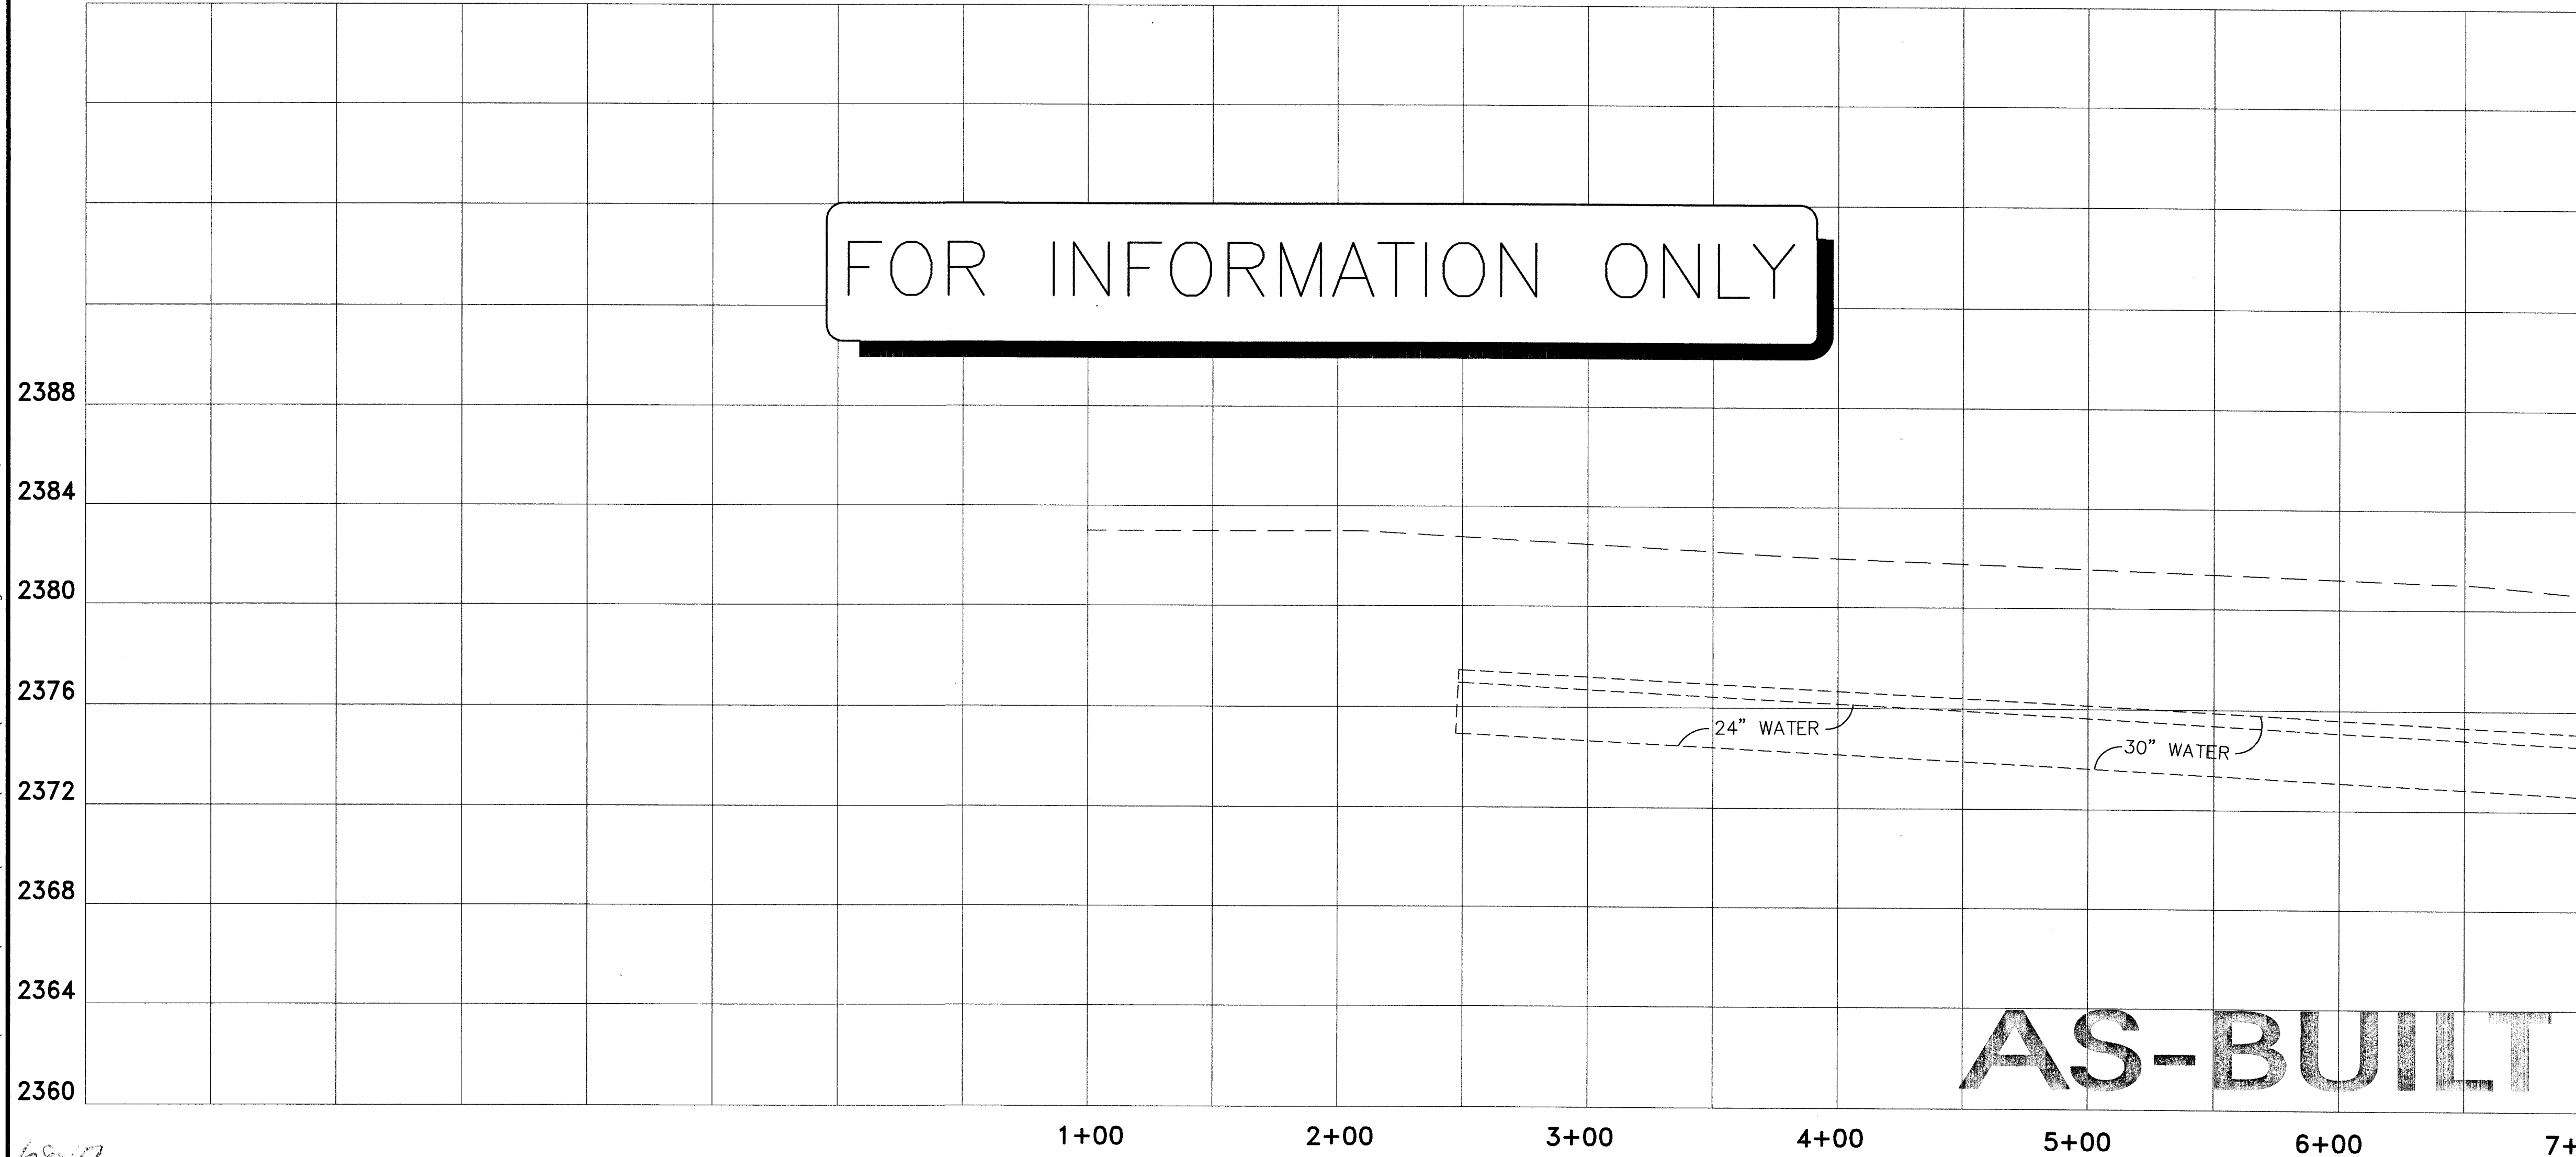

AS-BUILT

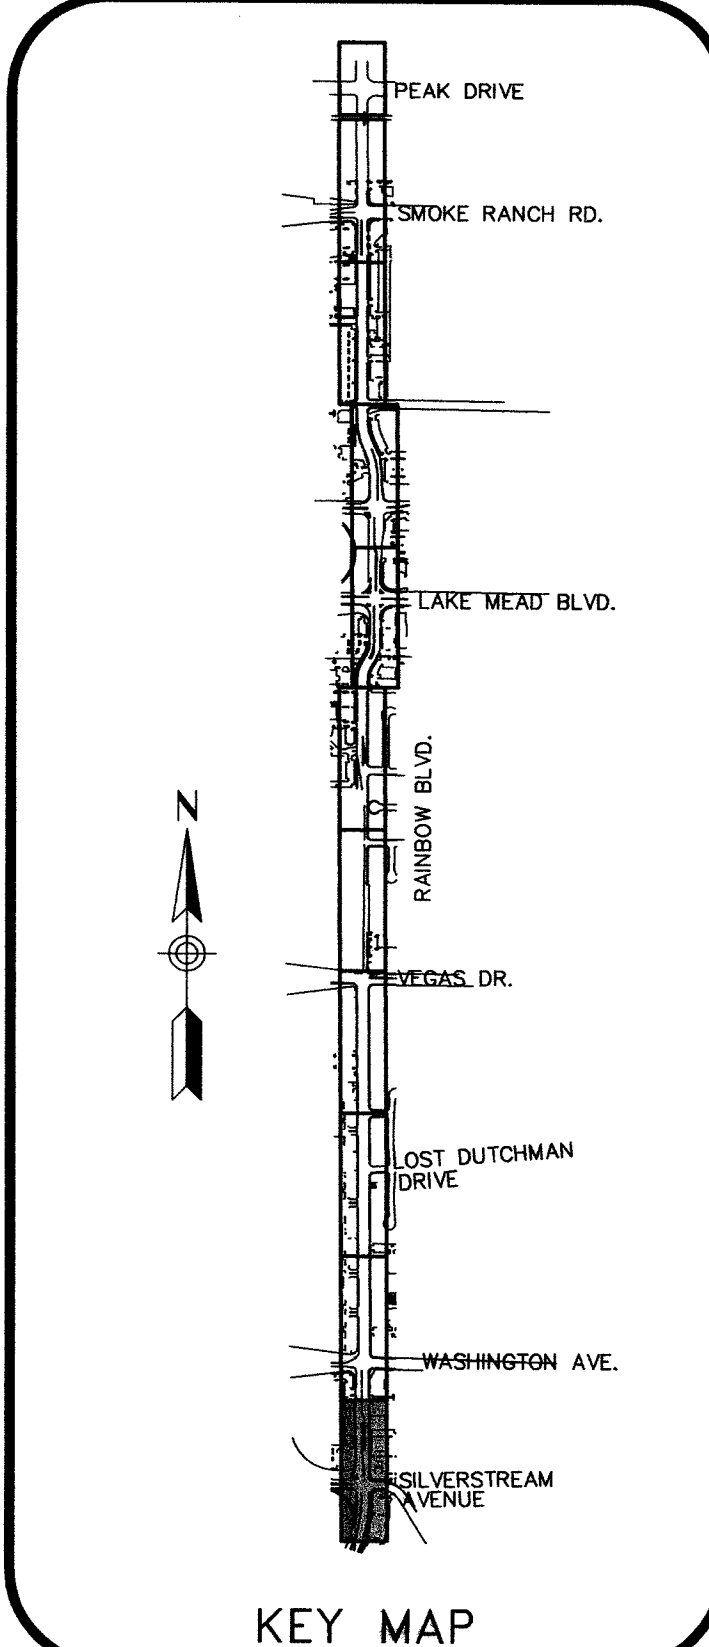

KEY MAP

Las Vegas Valley Water District Date: 2/28/02

Call
before you
Dig.
1-800-227-2600
UNDERGROUND SERVICE (USA)
AND
CLARK COUNTY TRAFFIC MANAGEMENT
OPERATIONS UNIT (702) 455-7544

