



NAME: P:\W7X70800\700CADD\702DWB\702DWB-1112.dwg DATE: FEB 25, 2002 TIME: 11:23 AM

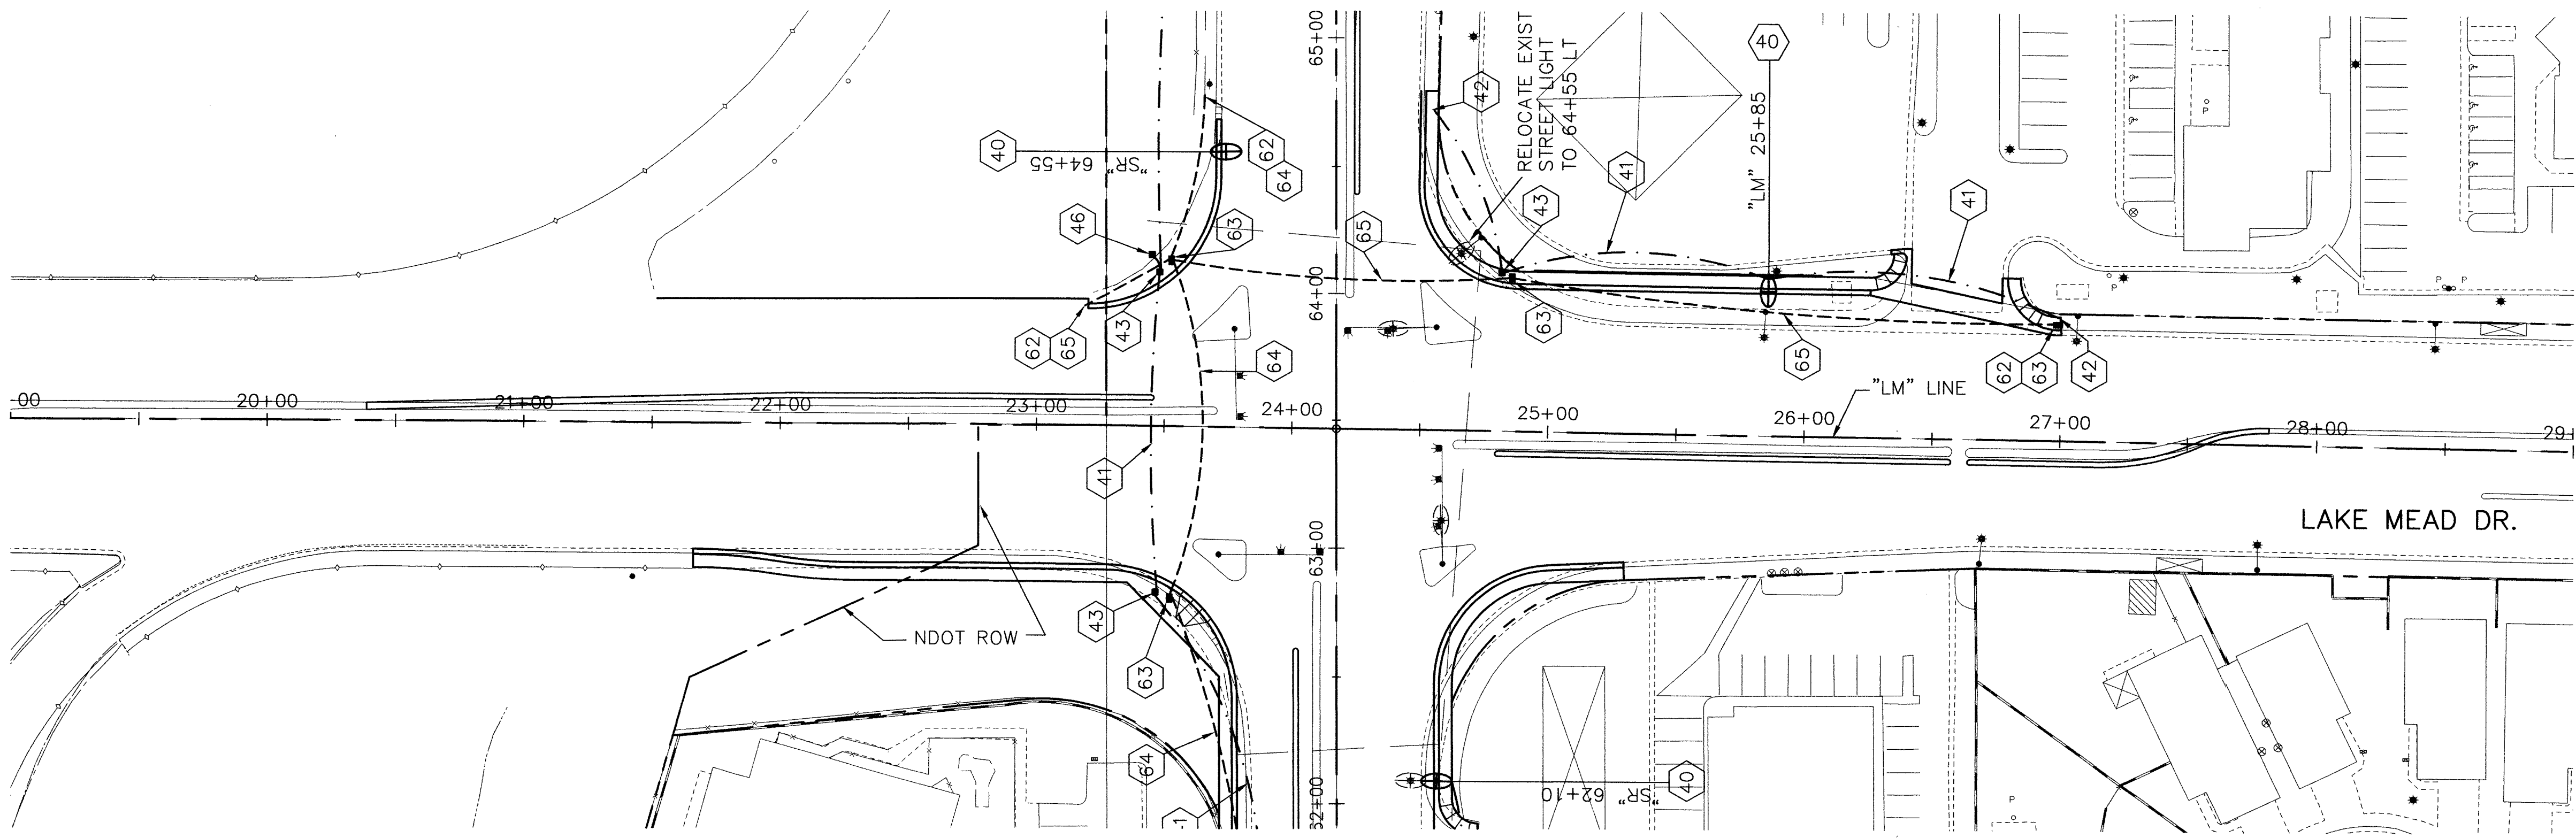


40' 20' 0 40' 80'
SCALE: 1" = 40'

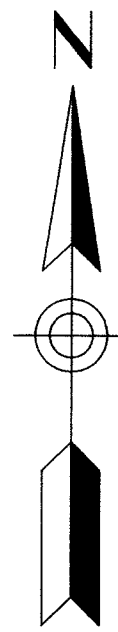

NOTES

- 40 RELOCATE EXISTING 250 WATT HPS STREET LIGHT ASSEMBLY AND FOUNDATION
- 41 1-1/4" STREET LIGHT CONDUIT WITH WIRE (C.L.V.)
- 42 CONNECT TO EXISTING STREET LIGHT CONDUIT
- 43 INSTALL NEW NO. 3 1/2 PULL BOX
- 44 CONSTRUCT 250 WATT HPS STREET LIGHT ASSEMBLY AND FOUNDATION
- 45 EXISTING NO. 7 PULL BOX
- 46 EXISTING 200 AMP SERVICE PEDESTAL
- 47 INSTALL NEW 200 AMP SERVICE PEDESTAL
- 48 COIL ADDITIONAL WIRE IN PULL BOX FOR FUTURE USE
- 61 INSTALL INTERCONNECT CABLE IN EXISTING CONDUIT
- 62 CONNECT TO EXISTING INTERCONNECT CONDUIT
- 63 INSTALL NEW DOUBLE STACKED NO. 7 PULL BOX
- 64 INSTALL NEW 3" INTERCONNECT CONDUIT WITH INTERCONNECT CABLE
- 65 INSTALL NEW 3" INTERCONNECT CONDUIT

PROJ NO: W7X70800
DESIGN: DEP
DATE: 2/14/2002
SCALE: 1:40
CADFILE: 7000-112

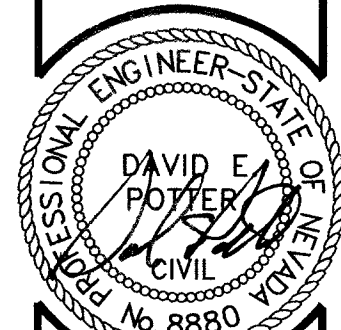

STAMP DATE: 2/14/02

5450 W. SAVANA AVE., SUITE 150
LAS VEGAS, NEVADA 89102-1846
TEL: (702) 800-1730
FAX: (702) 800-1731

Sverdrup
CIVIL, INC.

RAINBOW BOULEVARD
SILVERSTREAM AVE. TO SMOKE RANCH ROAD
STREET LIGHT & INTERCONNECT PLAN
LAKE MEAD DRIVE

SHEET
SL-7

102 OF 110 SHEETS

DRAWING NO.
107-V3519

Call
before you
Dig.
1-800-227-2600
UNDERGROUND SERVICE (USA)
AND
CLARK COUNTY TRAFFIC MANAGEMENT
OPERATIONS UNIT (702) 455-7544



AS-BUILT