


# RAINBOW WEST UNIT 3

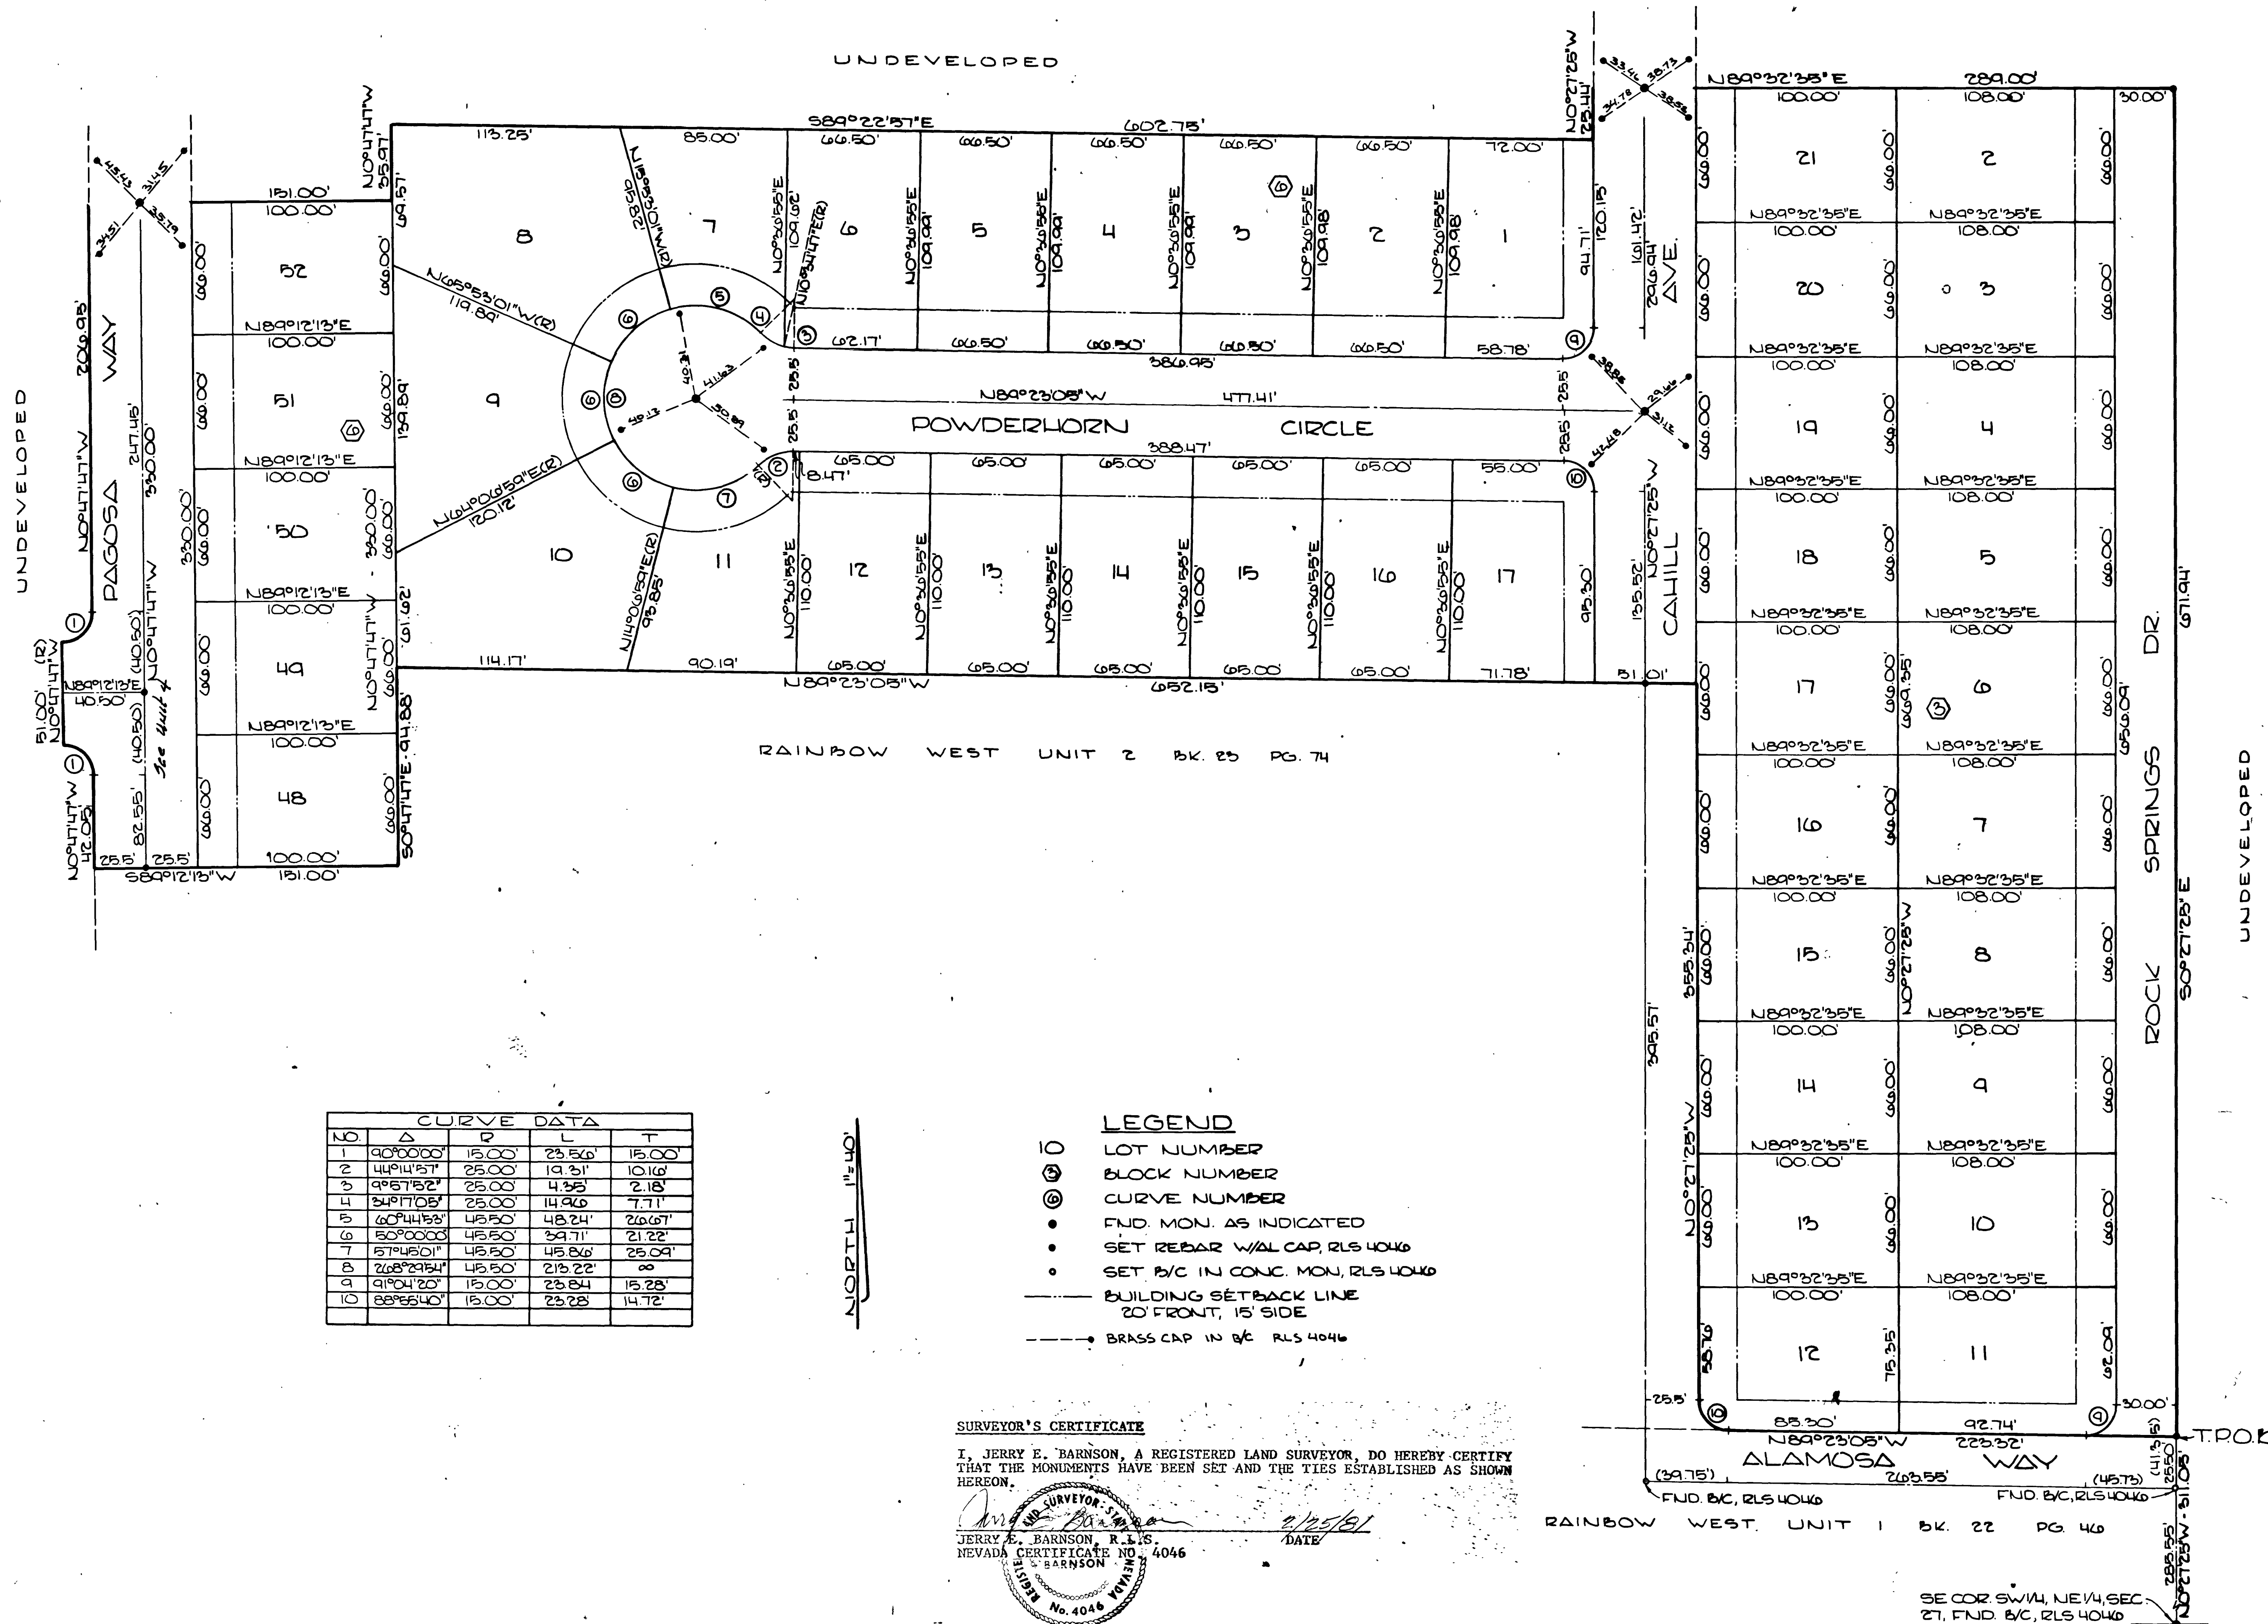

| NO. | Δ         | R      | L      | T      |
|-----|-----------|--------|--------|--------|
| 1   | 90°00'00" | 15.00' | 23.56' | 15.00' |
| 2   | 44°14'57" | 25.00' | 19.31' | 10.16' |
| 3   | 90°57'52" | 25.00' | 4.33'  | 2.18'  |
| 4   | 34°17'05" | 25.00' | 14.96' | 7.71'  |
| 5   | 60°44'53" | 45.50' | 48.24' | 26.67' |
| 6   | 80°00'00" | 45.50' | 59.71' | 21.22' |
| 7   | 57°45'01" | 45.50' | 45.86' | 25.09' |
| 8   | 26°53'54" | 45.50' | 21.52' | 00'    |
| 9   | 91°04'20" | 15.00' | 23.84' | 15.28' |
| 10  | 88°55'40" | 15.00' | 23.28' | 14.72' |

## LEGEND

- 10 LOT NUMBER
- ② BLOCK NUMBER
- ③ CURVE NUMBER
- FND. MON. AS INDICATED
- SET REBAR W/AL CAP, RLS 4046
- SET B/C IN CONC. MON, RLS 4046
- BUILDING SETBACK LINE 20' FRONT, 15' SIDE
- BRASS CAP IN B/C RLS 4046

## SURVEYOR'S CERTIFICATE

I, JERRY E. BARNSON, A REGISTERED LAND SURVEYOR, DO HEREBY CERTIFY THAT THE MONUMENTS HAVE BEEN SET AND THE TIES ESTABLISHED AS SHOWN HEREON.

JERRY E. BARNSON, R.L.S.  
NEVADA CERTIFICATE NO. 4046  
DATE 2/25/81

