


JOB NO. 620.914



CHEYENNE AVENUE

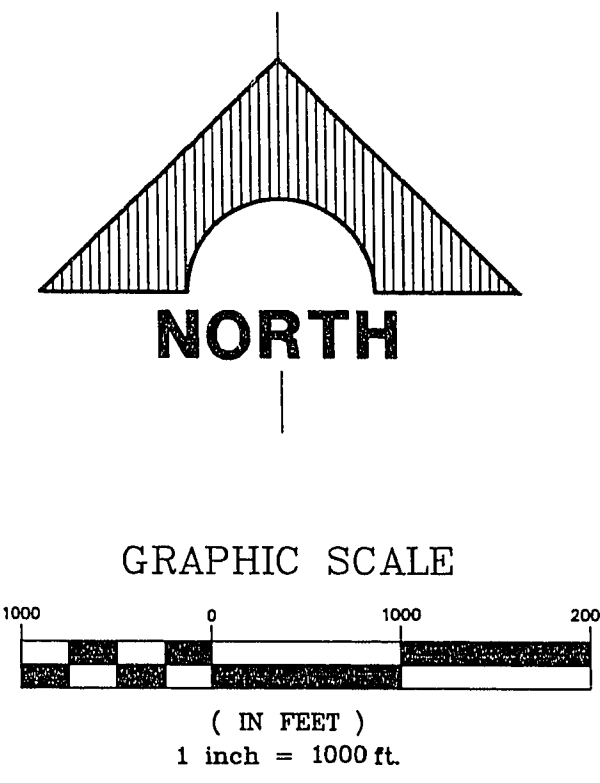

LIST OF DRAWINGS

- I-0 KEY MAP, VICINITY MAP & LIST OF DRAWINGS
- I-1 PLAN & PROFILE STA. 163+39.92 TO 174+00
- I-2 PLAN & PROFILE STA. 174+00 TO 182+63.47
- I-3 DRAINAGE DETAILS/PROFILES

RECORD DRAWINGS

THESE PLANS SHOW RECORD INFORMATION RECEIVED FROM:

CONTRACTOR: **SOUTHERN NEVADA PAVING/TAB**

DATE: **6-18-90**

THIS DATA MAY OR MAY NOT REFLECT THE ACTUAL FIELD LOCATIONS. ALL DATA SHOULD BE CONFIRMED PRIOR TO USE ON DEVELOPMENT OR ENGINEERING PLANS.

DESCRIPTION	ISSUE TO BID
REV	DATE
A	8/7/89
B	8/18/89
C	8-7-89
D	8-7-89
E	8-7-89
F	8-7-89
G	8-7-89
H	8-7-89
I	8-7-89
J	8-7-89
K	8-7-89
L	8-7-89
M	8-7-89
N	8-7-89
O	8-7-89
P	8-7-89
Q	8-7-89
R	8-7-89
S	8-7-89
T	8-7-89
U	8-7-89
V	8-7-89
W	8-7-89
X	8-7-89
Y	8-7-89
Z	8-7-89

DESIGNED BY: *[Signature]*
CHECKED BY: *[Signature]*
DATE: 8-7-89

G.C. WALLACE, INC.
Engineering/Architecture
1555 NORTH RAINBOW BLVD., LAS VEGAS, NEVADA 89102

HOWARD HUGHES PROPERTIES
VILLAGE 1 NORTH - RAMPART BLVD.
KEY MAP, VICINITY MAP AND LIST OF DRAWINGS

SHEET
10
OF 7 SHEETS

15-3 107-VI03