


JOB NO. 620.314

8/84 DIETERICH POST 65328

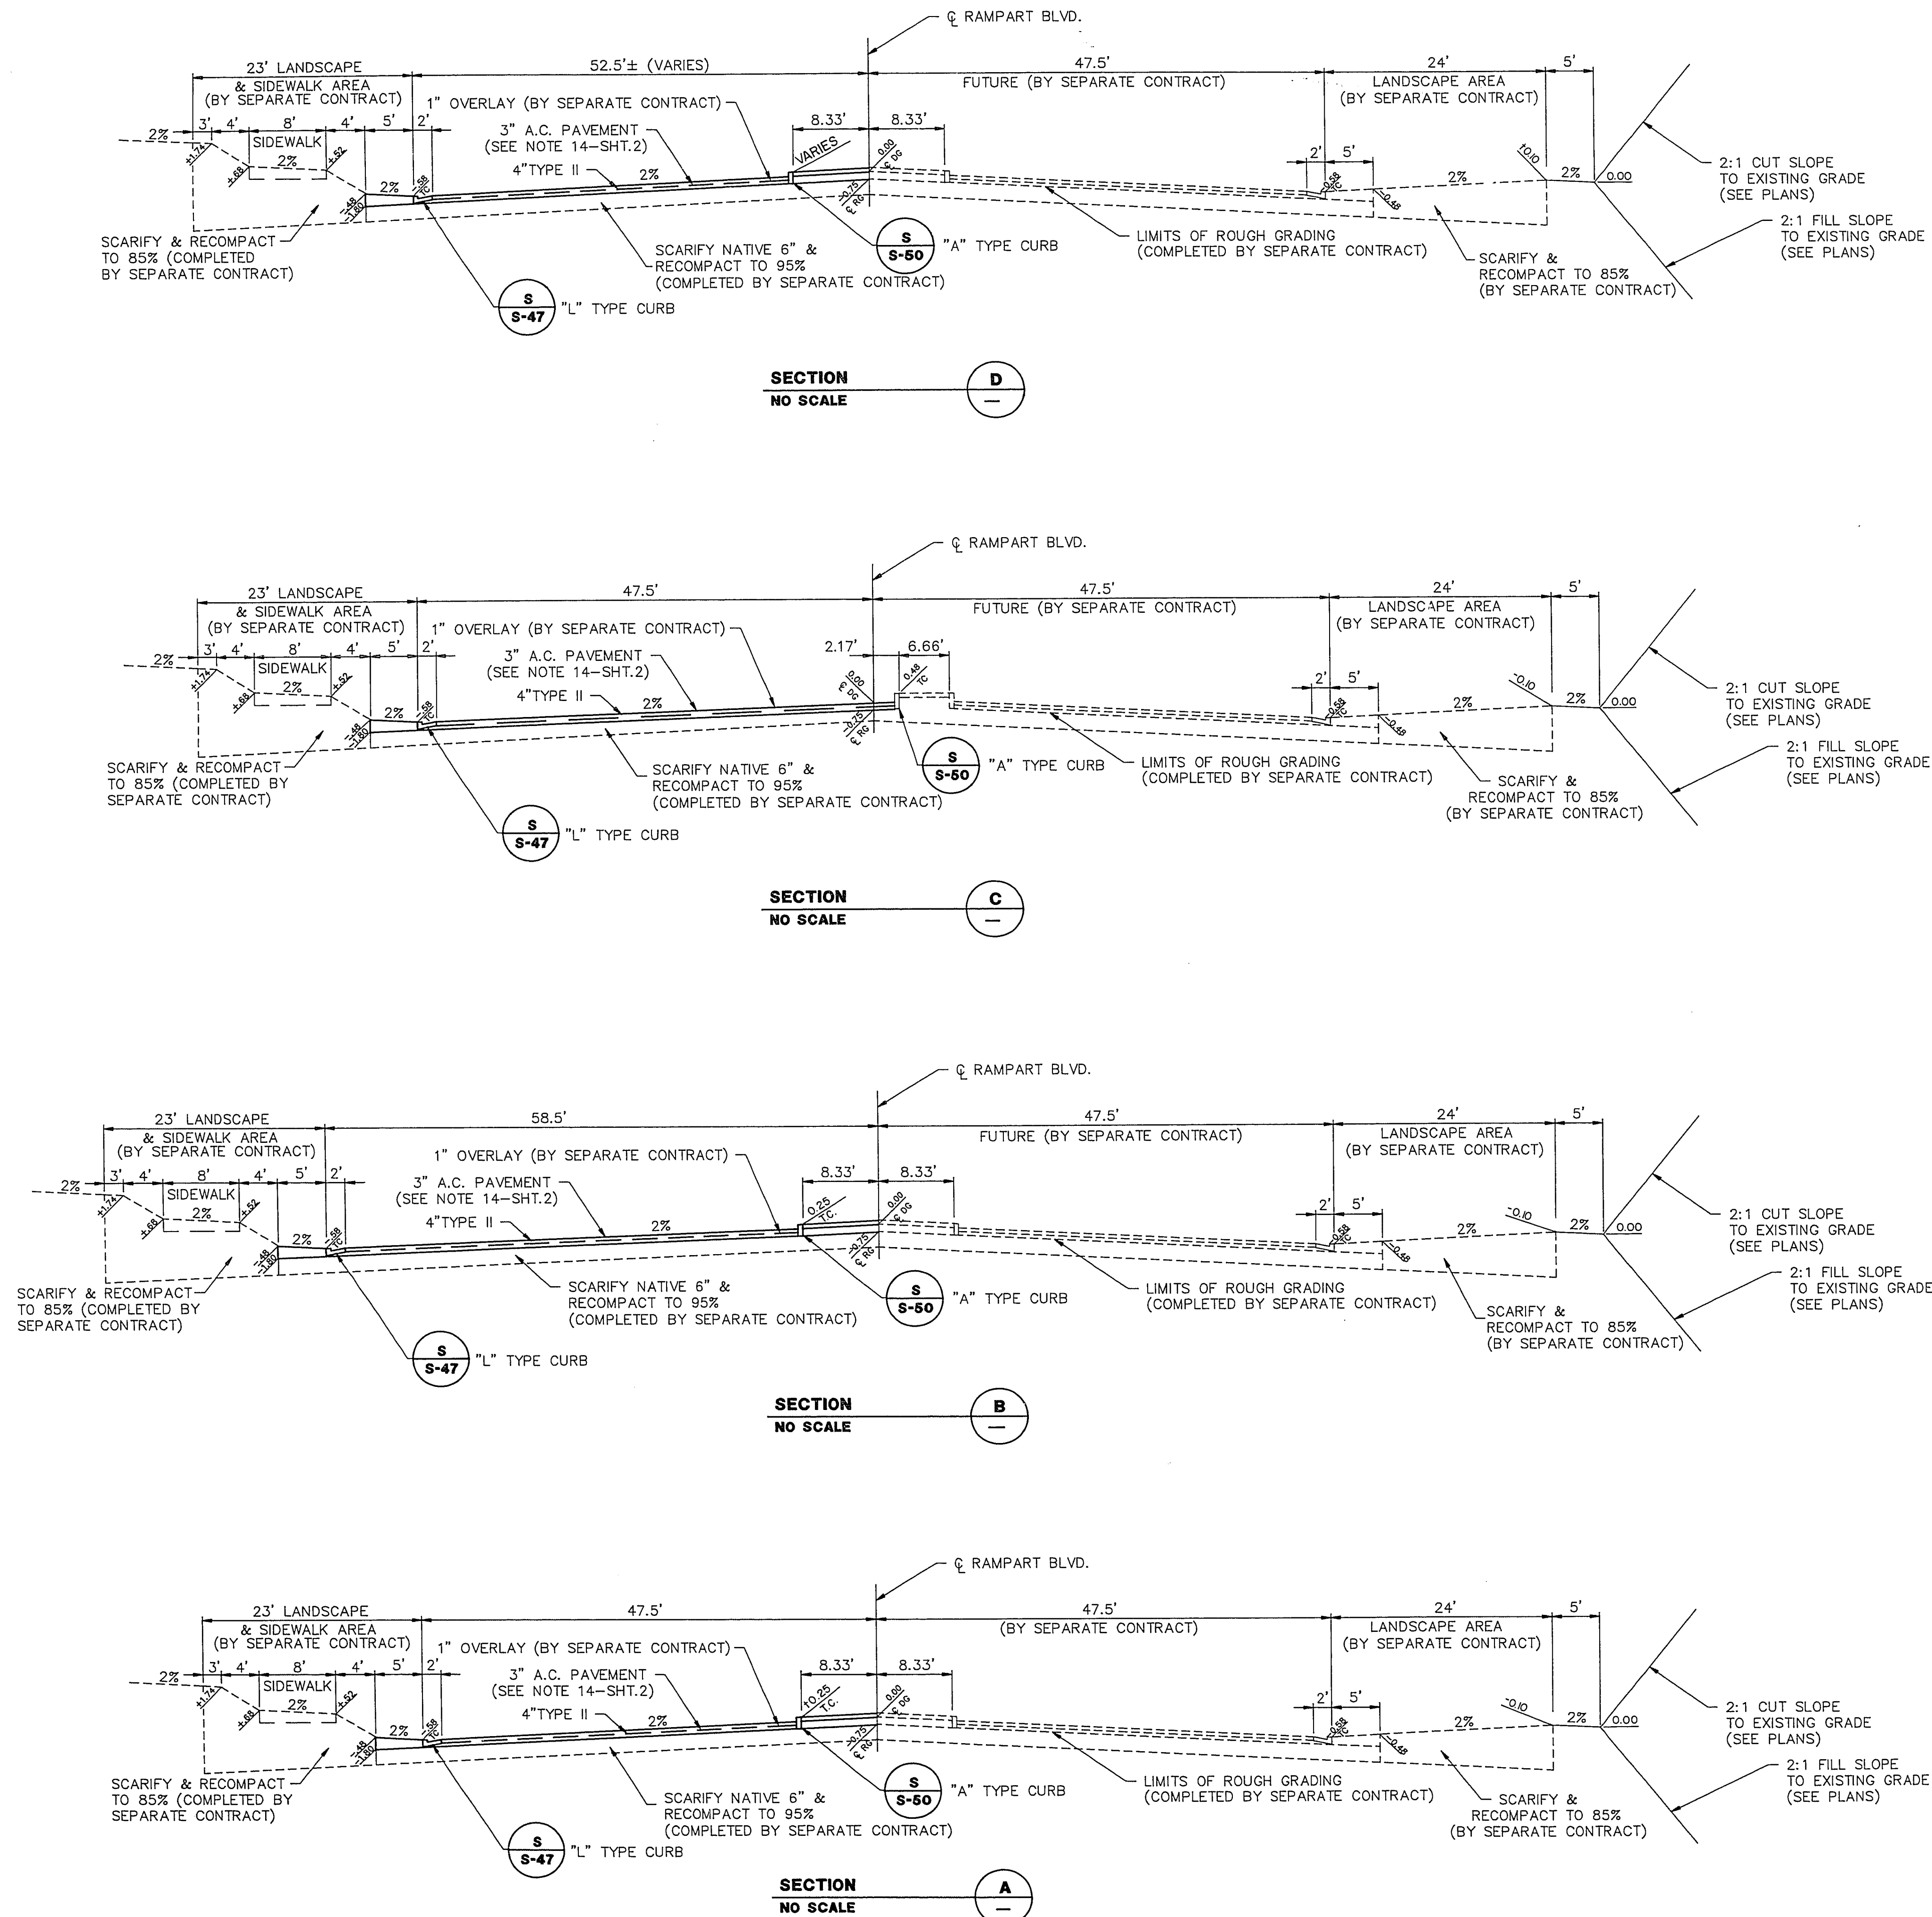

RECORD DRAWINGS
THESE PLANS SHOW RECORD INFORMATION RECEIVED FROM:
CONTRACTOR: SOUTHERN NEVADA PAVING/TAB
DATE: 6-18-90
THIS DATA MAY OR MAY NOT REFLECT THE ACTUAL FIELD LOCATIONS. ALL DATA SHOULD BE CONFIRMED PRIOR TO USE ON DEVELOPMENT OR ENGINEERING PLANS.

DESCRIPTION	DATE	REV	DATE	REV	DATE
ISSUE TO BD	8/7/89	A	8/7/89		
RECORD DRAWING	8/19/90	2	8/19/90		

REGISTERED PROFESSIONAL ENGINEER
CHRISTOPHER W. ANDERSON
CIVIL
NO. 31125
STATE OF NEVADA

1595 SOUTH RAINBOW BLVD / LAS VEGAS, NEVADA 89102

G.C. WALLACE, INC.
Engineering/Architecture

HOWARD HUGHES PROPERTIES	SHEET
VILLAGE 1 NORTH RAMPART BLVD.	1-3
TYPICAL STREET SECTIONS	8 OF 7 SHEETS