
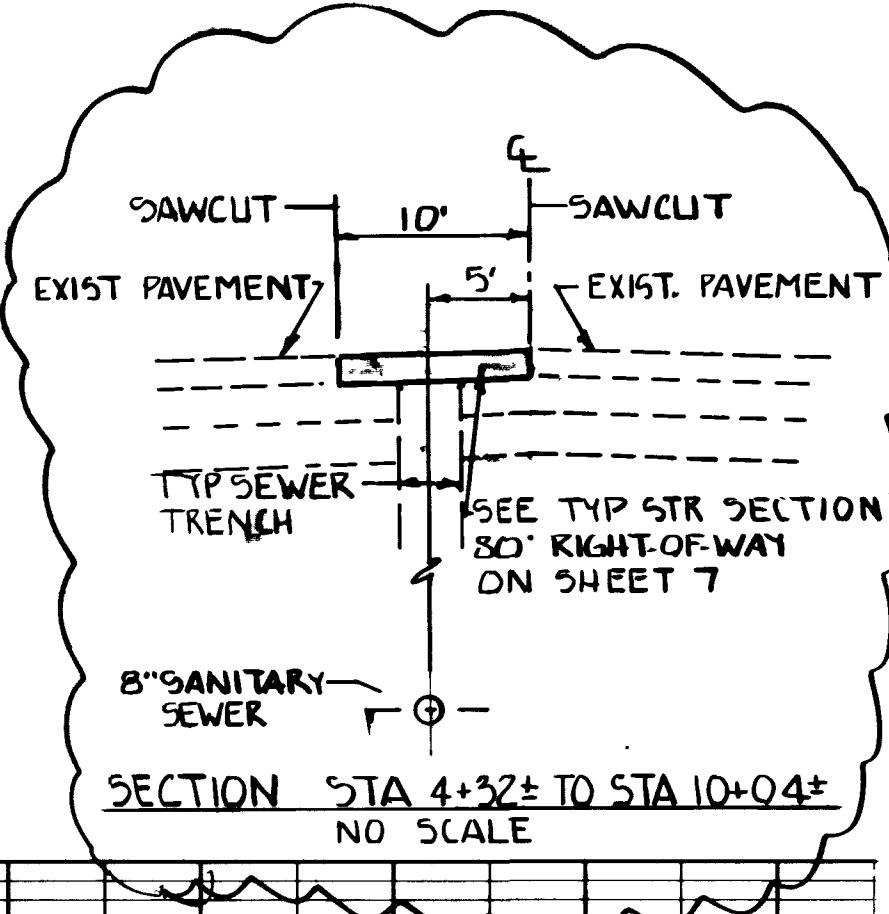
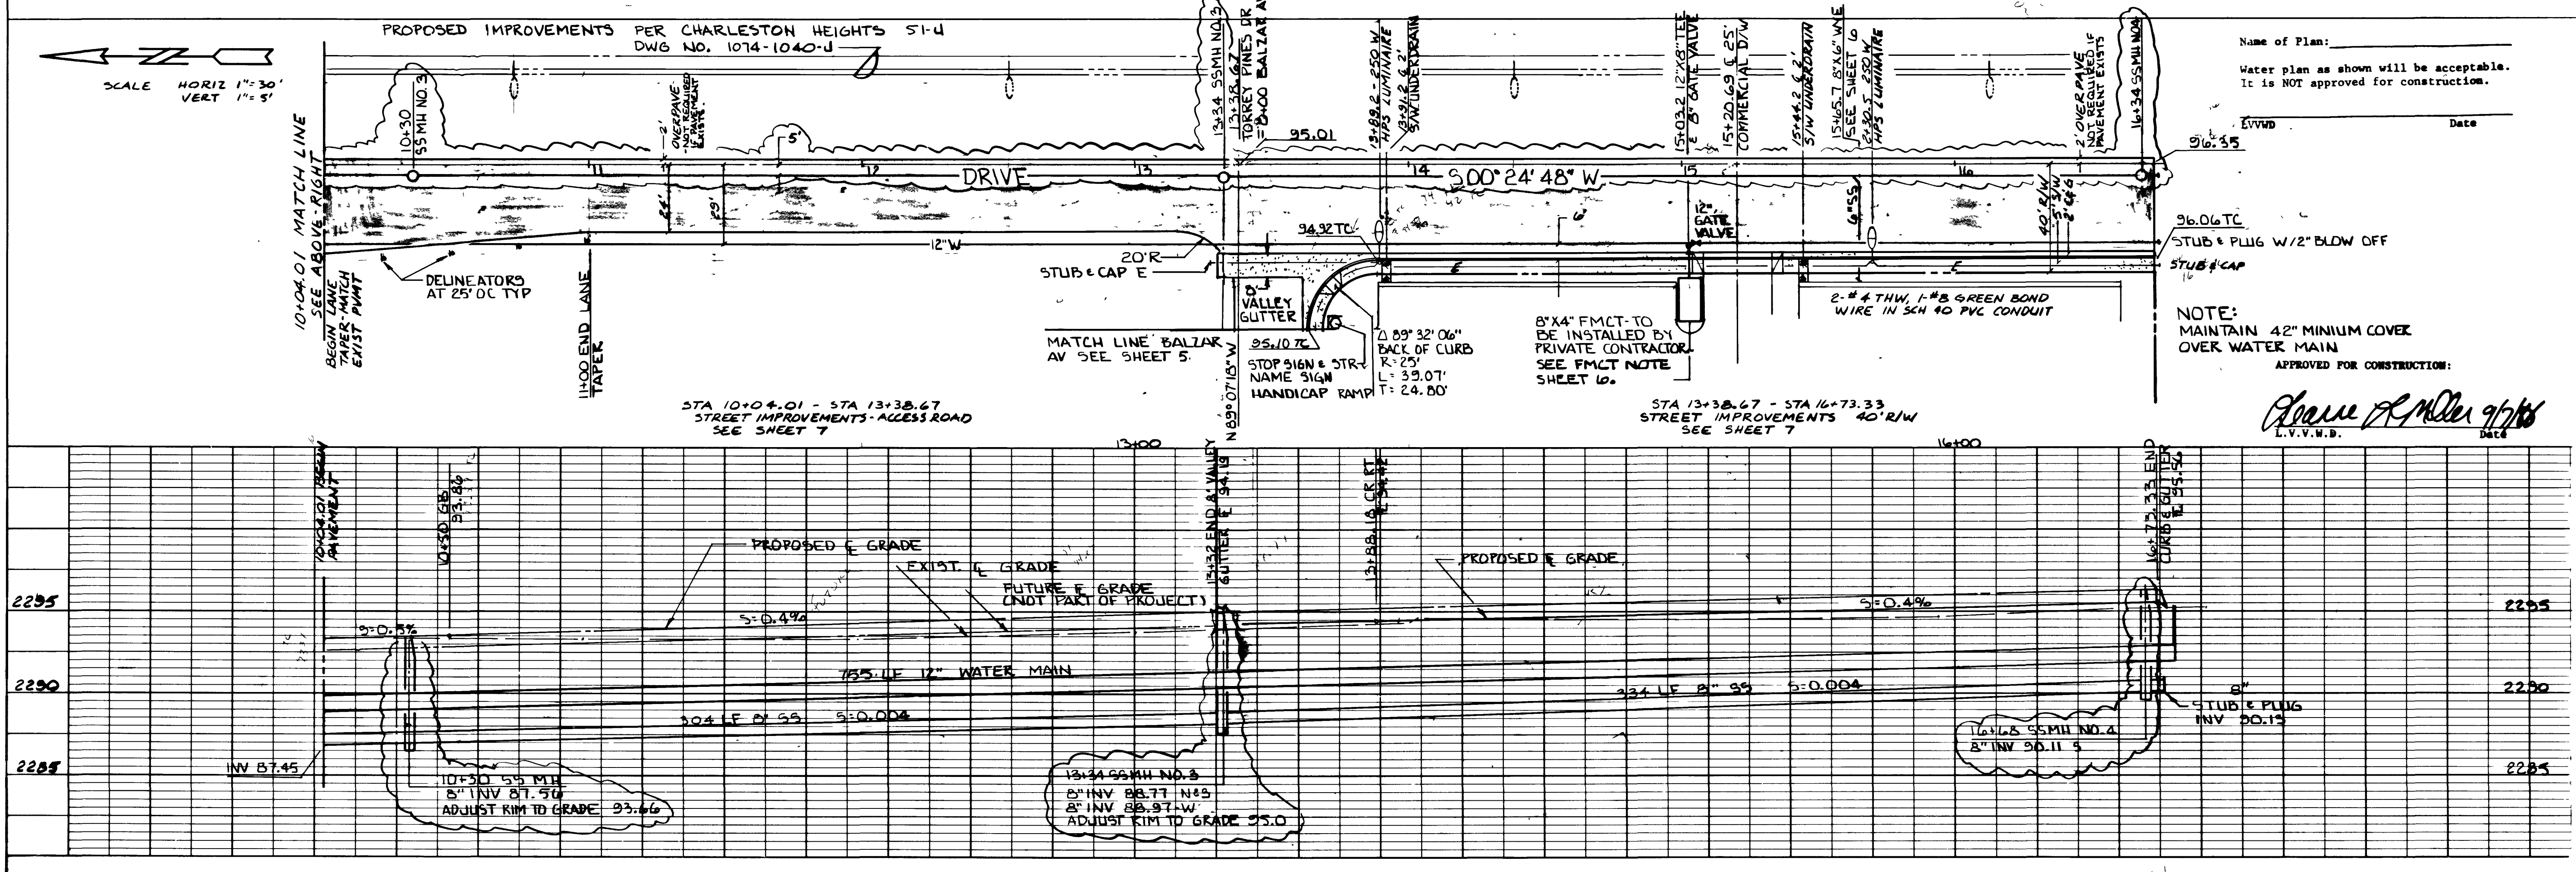


DATE	
BY	
REVISIONS	
NO.	
DESCRIPTION	
DATE	
BY	
NO.	
DESCRIPTION	
DATE	
BY	
NO.	
DESCRIPTION	

DATE	
BY	
REVISIONS	
NO.	
DESCRIPTION	
DATE	
BY	
NO.	
DESCRIPTION	
DATE	
BY	
NO.	
DESCRIPTION	

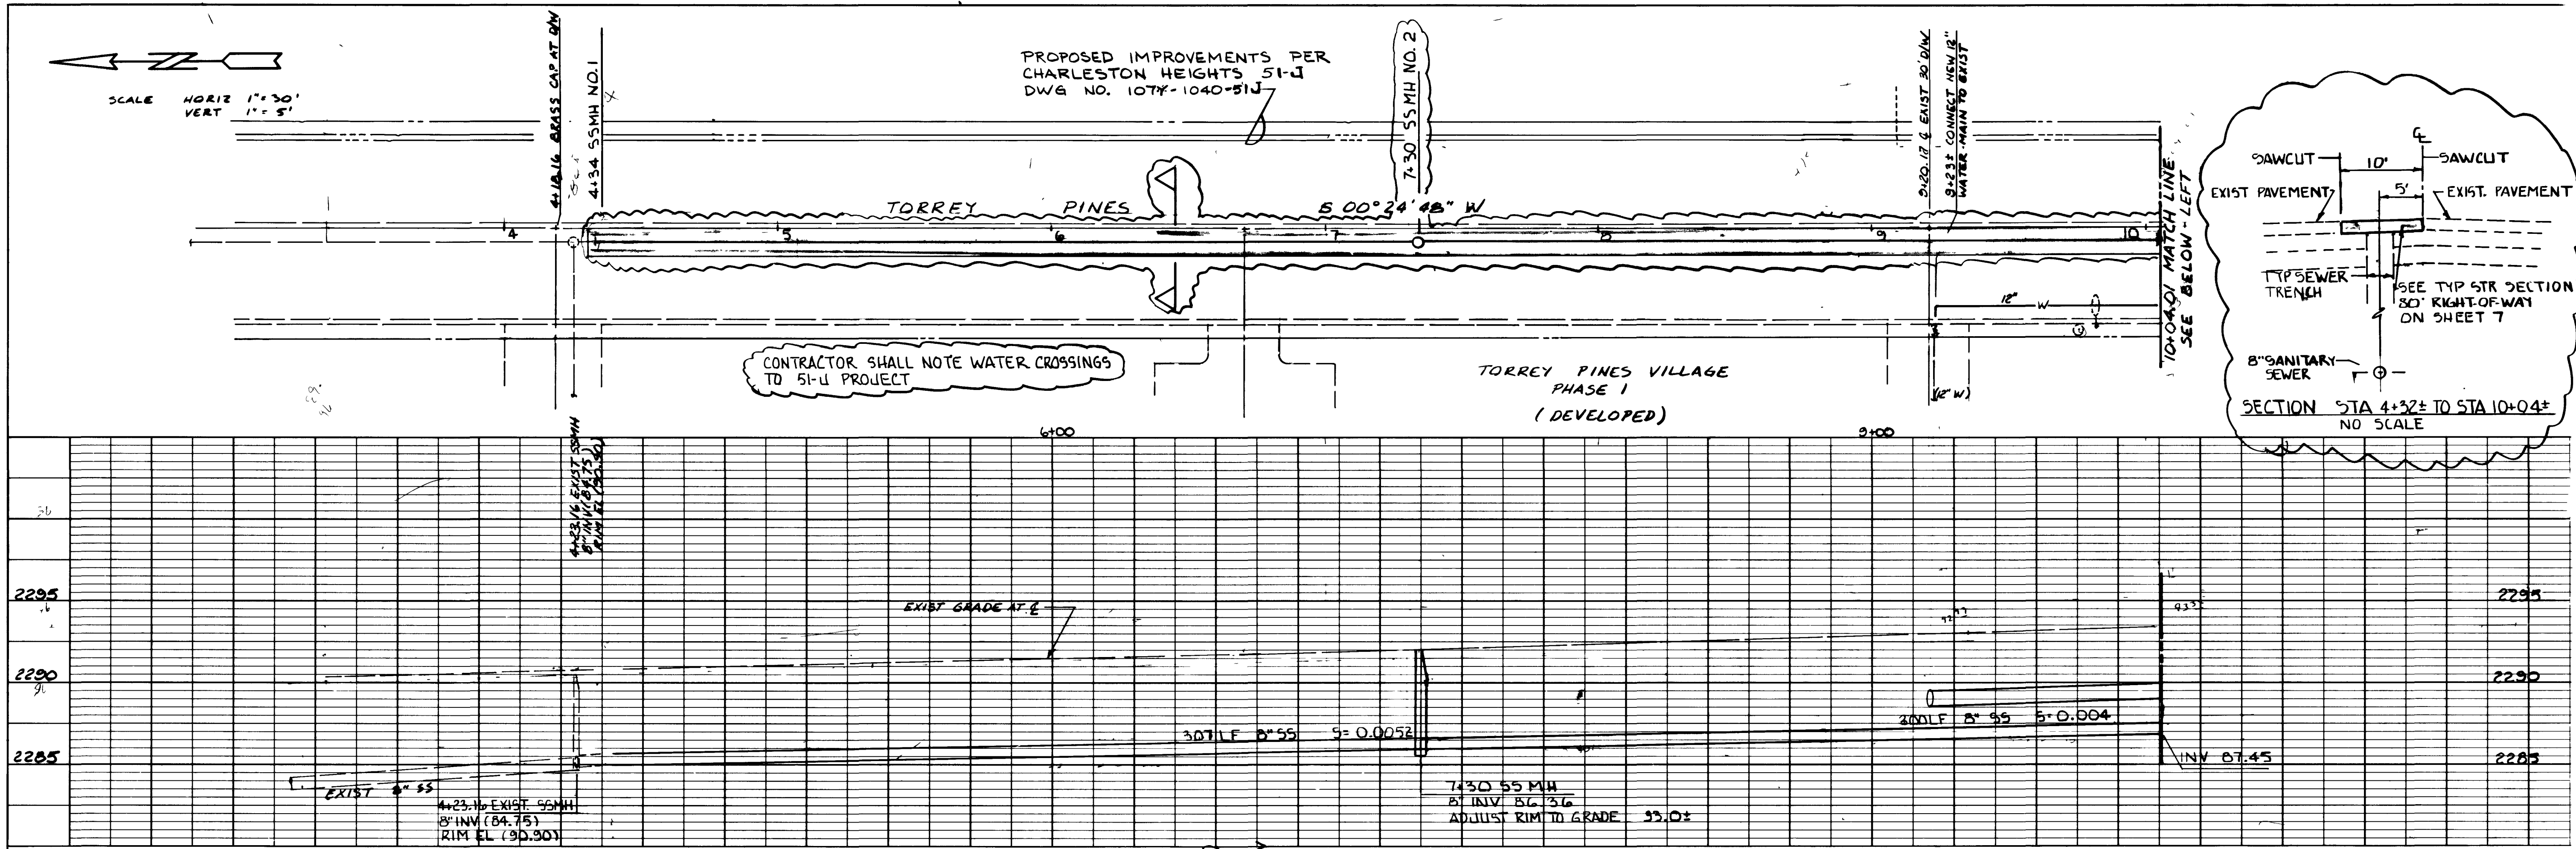


REVISIONS	
NO.	DESCRIPTION
1	REVISE SEWER ALIGNMENT
2	ADD TRENCH SECTION & DETAIL
3	BY E.M. 8/30/88

K D F ENGINEERING

TORREY PINES - PLAN / PROFILE  
 RICHMOND PARK CONDOMINIUMS  
 PHASE I  
 HIGH DESERT ESTATES

NOTE: MAINTAIN 42" MINIMUM COVER OVER WATER MAIN

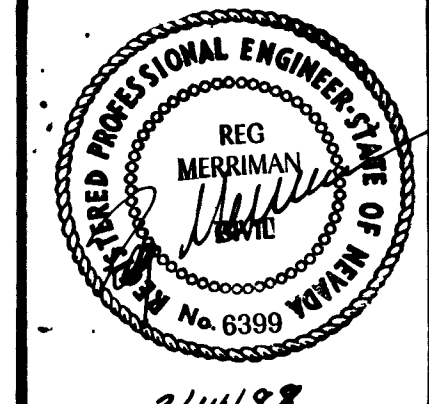

SHEET 4 OF 7

PLATE 2, PLAN PROFILE OF P & E STANDARD  
 EUGENE DIETZEN CO.

4987

19-8-40

1074-2645-1

