




6-6-72

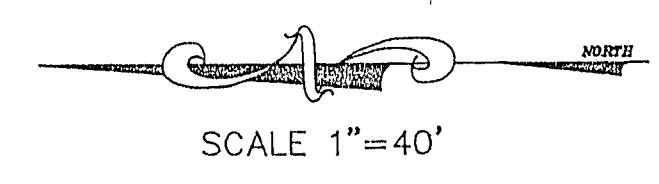

SURVEYORS CERTIFICATE
 I, KENNETH D. FARRIMOND, A PROFESSIONAL LAND SURVEYOR IN THE STATE OF NEVADA DO HEREBY CERTIFY THAT THE MONUMENTS HAVE BEEN SET AND THE TIE DISTANCES IS AS SHOWN HEREON. THE SURVEY WAS COMPLETED ON DECEMBER 29, 1990.

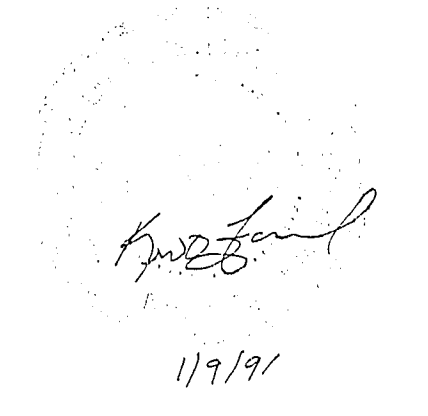

- LEGEND**
- FOUND REBAR AND AL CAP - PLS # 4134
 - SET 5/8" REBAR AND AL CAP - PLS # 4134
 - ▲ SET 1" DIAMETER BRASS CAP IN CURB - MARKED AS REFERENCE MARK (RM), TIE DISTANCE AND PLS # 4134
 - SET 5/8" REBAR AND AL CAP - MARKED AS REFERENCE MARK (RM), TIE DISTANCE AND PLS # 4134

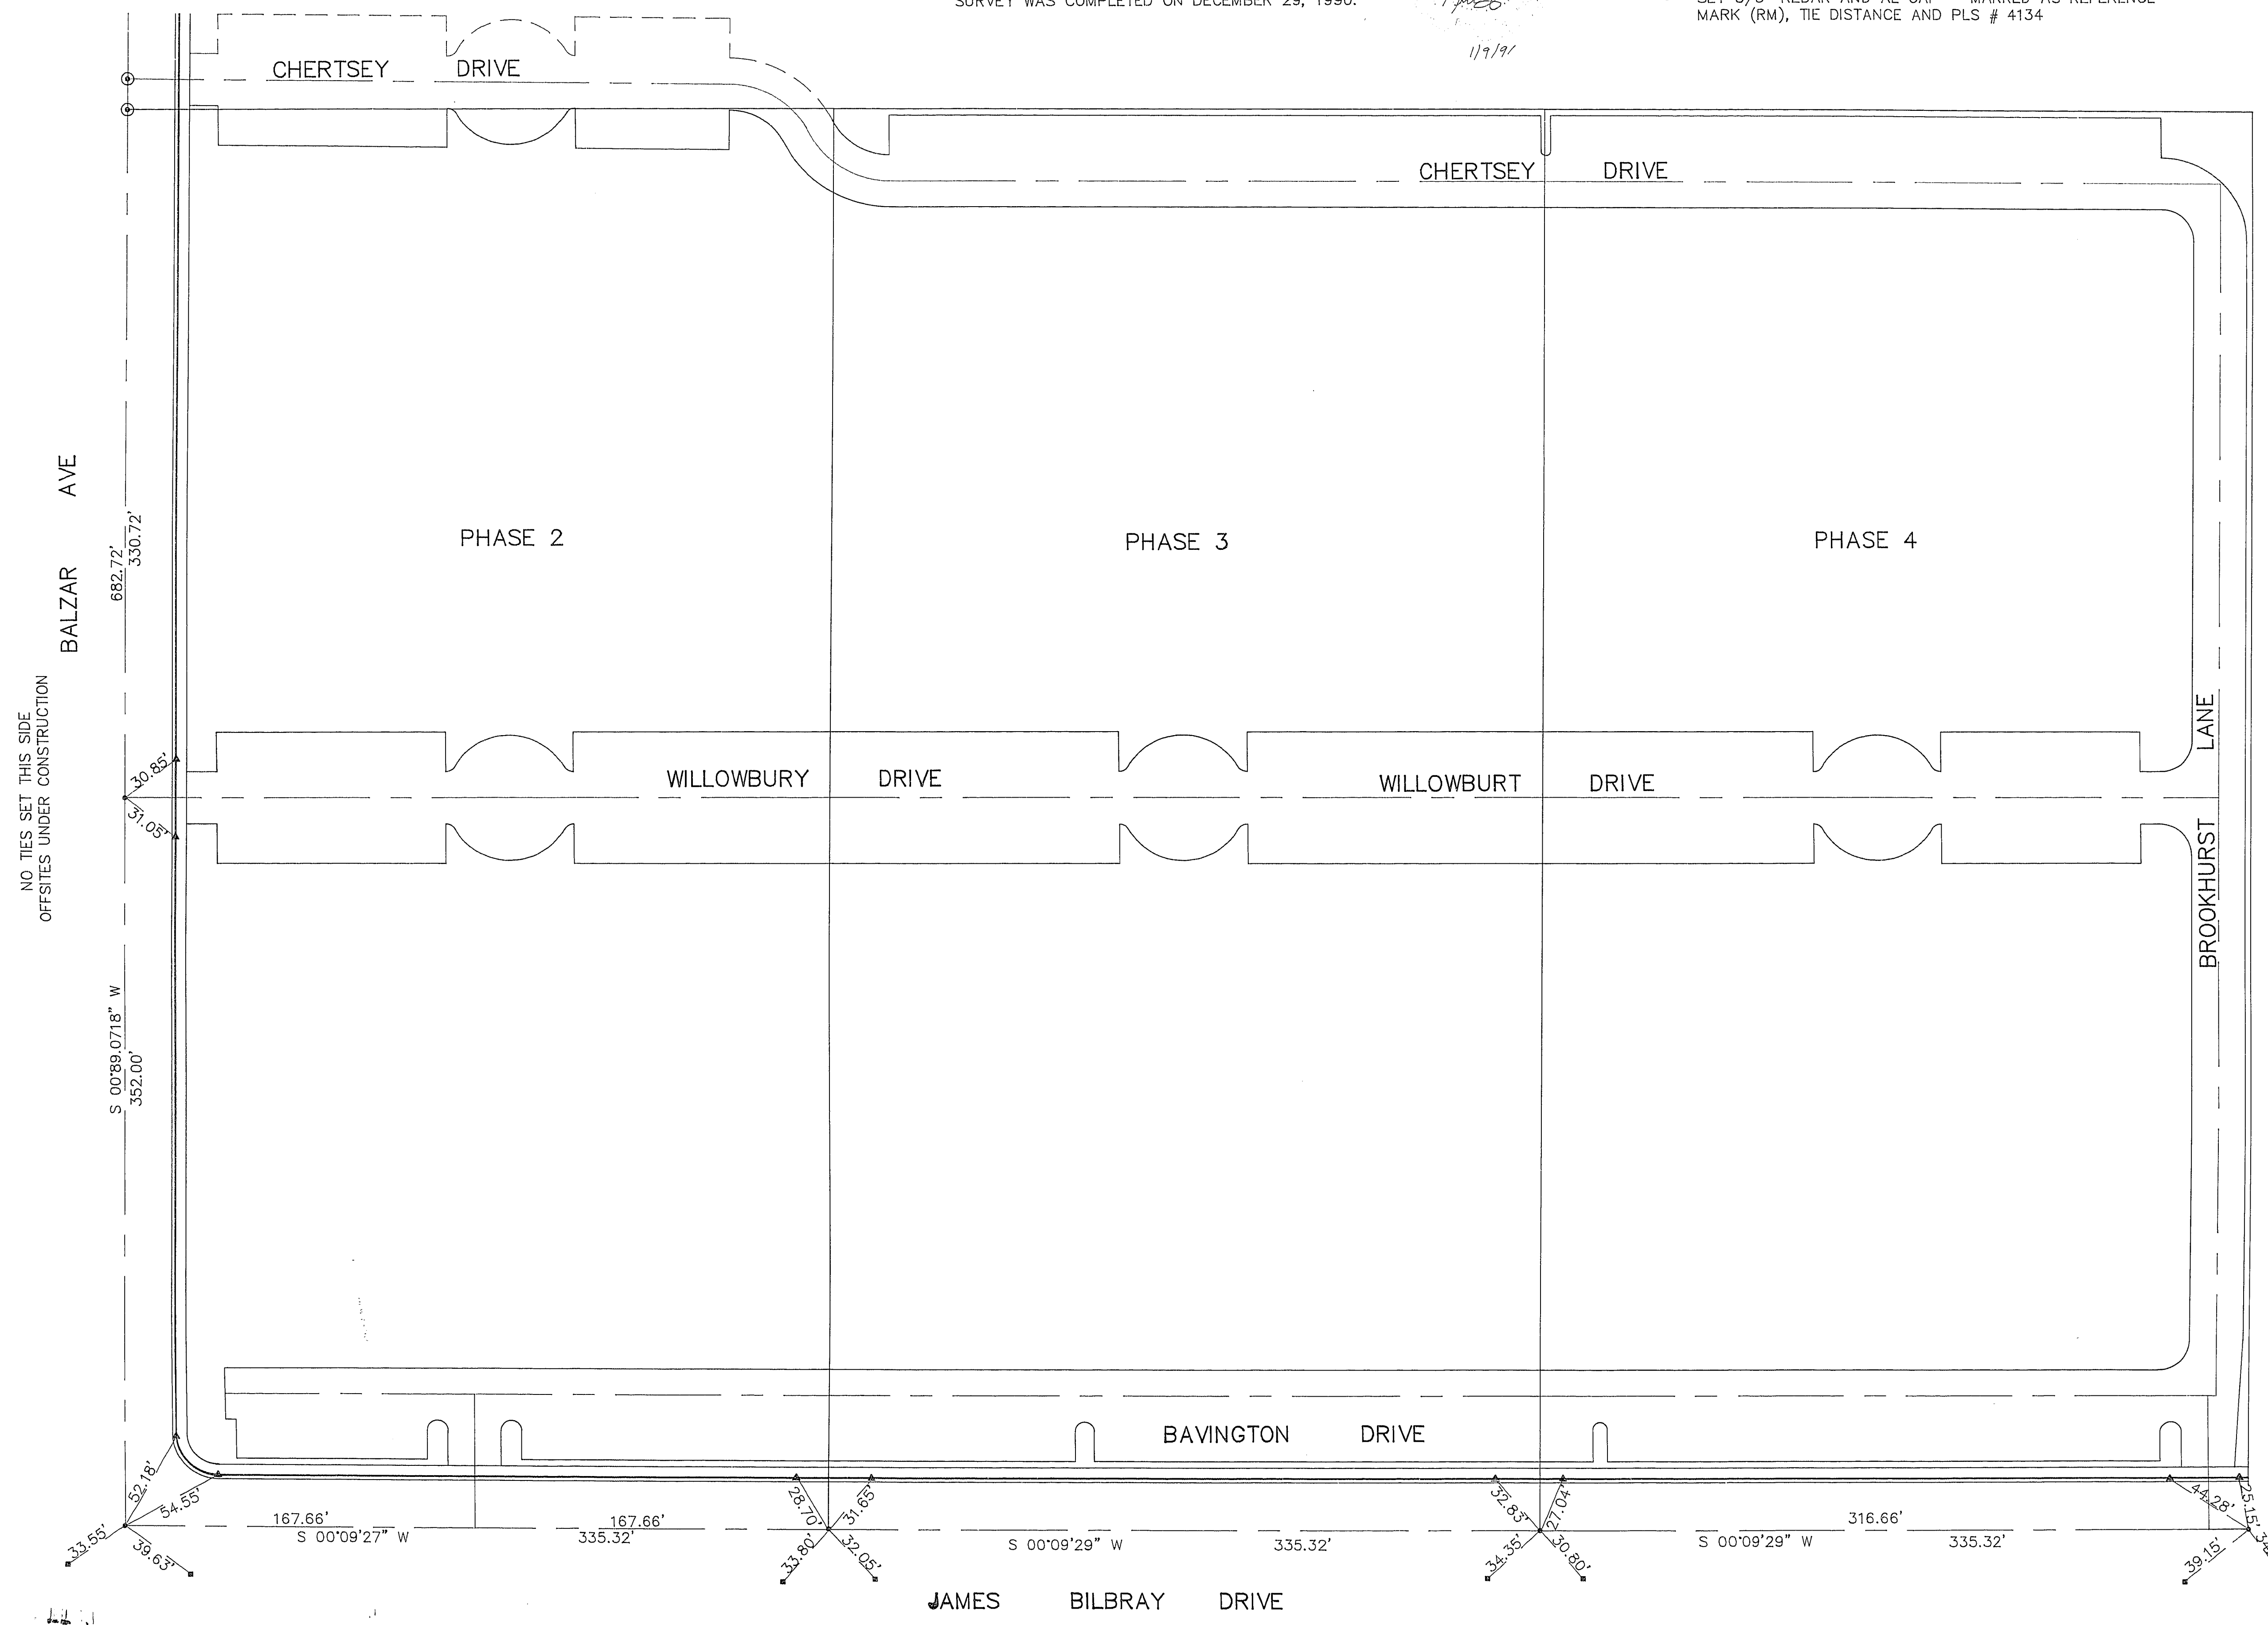

REVISIONS	BY

**RICHMOND PARK CONDOMINIUMS
 MONUMENT TIE MAP
 PHASES 2,3,&4**

KEN FARRIMOND
 4777 E. CHARLESTON
 SUITE H
 LAS VEGAS, NV 89104
 (702) 457-6113

DESIGNED
 R. MERRIMAN
 CHECKED

DATE
 JANUARY 1991

SCALE
 1" = 40'

JOB NO.

SHEET