


**ESTIMATE OF QUANTITIES**

8" VCP	470 L.F.
4" VCP	768 L.F.
MANHOLE	3 EACH

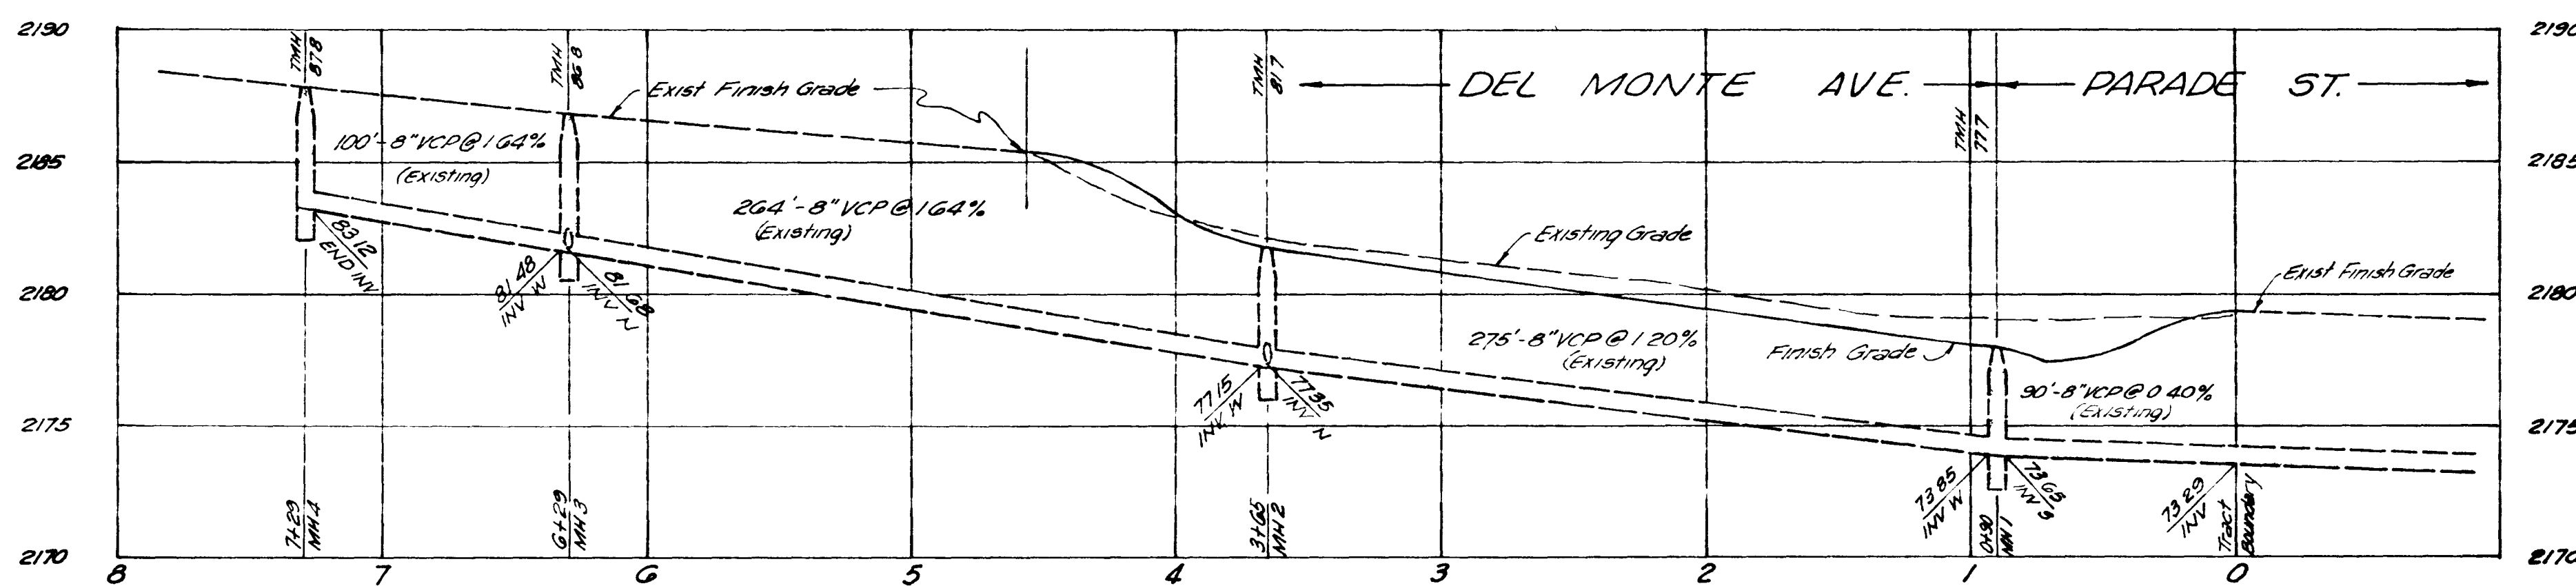

**APPROVALS**

CITY ENGINEER \_\_\_\_\_ DATE \_\_\_\_\_  
 SUPT OF SANITATION \_\_\_\_\_ DATE \_\_\_\_\_




**ROYAL CREST PARK**

CHECKED <i>RK</i>	APPROVED <i>R. Kraemer</i>	DRAWN <i>RK</i>
DATE 1-30-67		DESIGNED <i>RK</i>
<b>SEWER PLAN - PROFILE</b>		
SCALE: HOR - 1"=50'	VERT - 1"=5'	SHEET 1 OF 1

Kraemer Engineering Co. - Las Vegas, Nevada

AS BUILT LATERAL LOC.

5041 14-8-67 307-2663-1

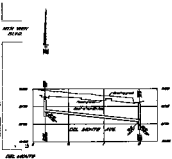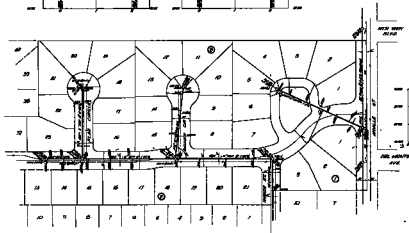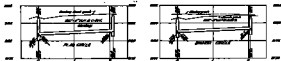

BRIDGE DECK  
 BRIDGE DECK  
 BRIDGE DECK  
 BRIDGE DECK



SUMMARY  
 CONTRACT NO. \_\_\_\_\_  
 DATE OF RECORD \_\_\_\_\_

**ROYAL CREST PARK**  
 BRIDGE PLAN - BRIDGE  
 BRIDGE PLAN - BRIDGE  
 BRIDGE PLAN - BRIDGE  
 BRIDGE PLAN - BRIDGE

AS SHOWN LATERAL ELEVATION