


QUANTITY ESTIMATE

SIGNS (POLE-MOUNTED):		
OM-3R	8 EA	NOTE: FOR CROSSWALK AND STOP BAR STRIPING DETAILS FOR THE INTERSECTIONS, SEE SHEETS 37 (T-5), 39 (T-7) AND 40 (T-8).
R1-1 (30" x 30")	5 EA	THESE QUANTITIES ARE ONLY ESTIMATES, CONTRACTOR TO VERIFY.
R2-1, 45 MPH (23" x 30")	8 EA	
R3-7A, "RIGHT LANE MUST TURN RIGHT" (30" x 30")	5 EA	
R8-3A (18" x 18")	175 EA	
W1-6L	1 EA	
STREET NAME SIGNS	8 EA	
PAVEMENT MARKINGS:		
TYPE "A" CIRCULAR WHITE CERAMIC MARKER	2,473 EA	
TYPE "E" ONE WAY WHITE REFLECTIVE MARKER	395 EA	
TYPE "F" TWO WAY WHITE/RED REFLECTIVE MARKER	27 EA	
MEDIAN NOSE MARKERS	600 EA	
THERMOPLASTIC PAVEMENT MARKING "ONLY"	8 EA	
THERMOPLASTIC PAVEMENT MARKING "BIKE"	16 EA	
THERMOPLASTIC PAVEMENT MARKING "LANE"	44 EA	
THERMOPLASTIC PAVEMENT MARKING CROSSWALK & STOP BARS	14,469 SF	
THERMOPLASTIC PAVEMENT MARKING (4")	400 LF	
THERMOPLASTIC PAVEMENT MARKING (6")	28 EA	
PAINTED PAVEMENT MARKING "BIKE"	28 EA	
PAINTED PAVEMENT MARKING (4")	4,829 LF	
PAINTED PAVEMENT MARKING (6")	600 LF	
TYPE I FILM "ONLY"	6 EA	
TYPE I FILM ARROW	12 EA	
TYPE I FILM "BIKE"	24 EA	
TYPE I FILM "LANE"	2,614 SF	
TYPE I FILM CROSSWALK & STOP BARS	7,482 LF	
TYPE II FILM (4")	400 LF	
TYPE II FILM (6")	789 LF	
TYPE II FILM (12")	375 LF	

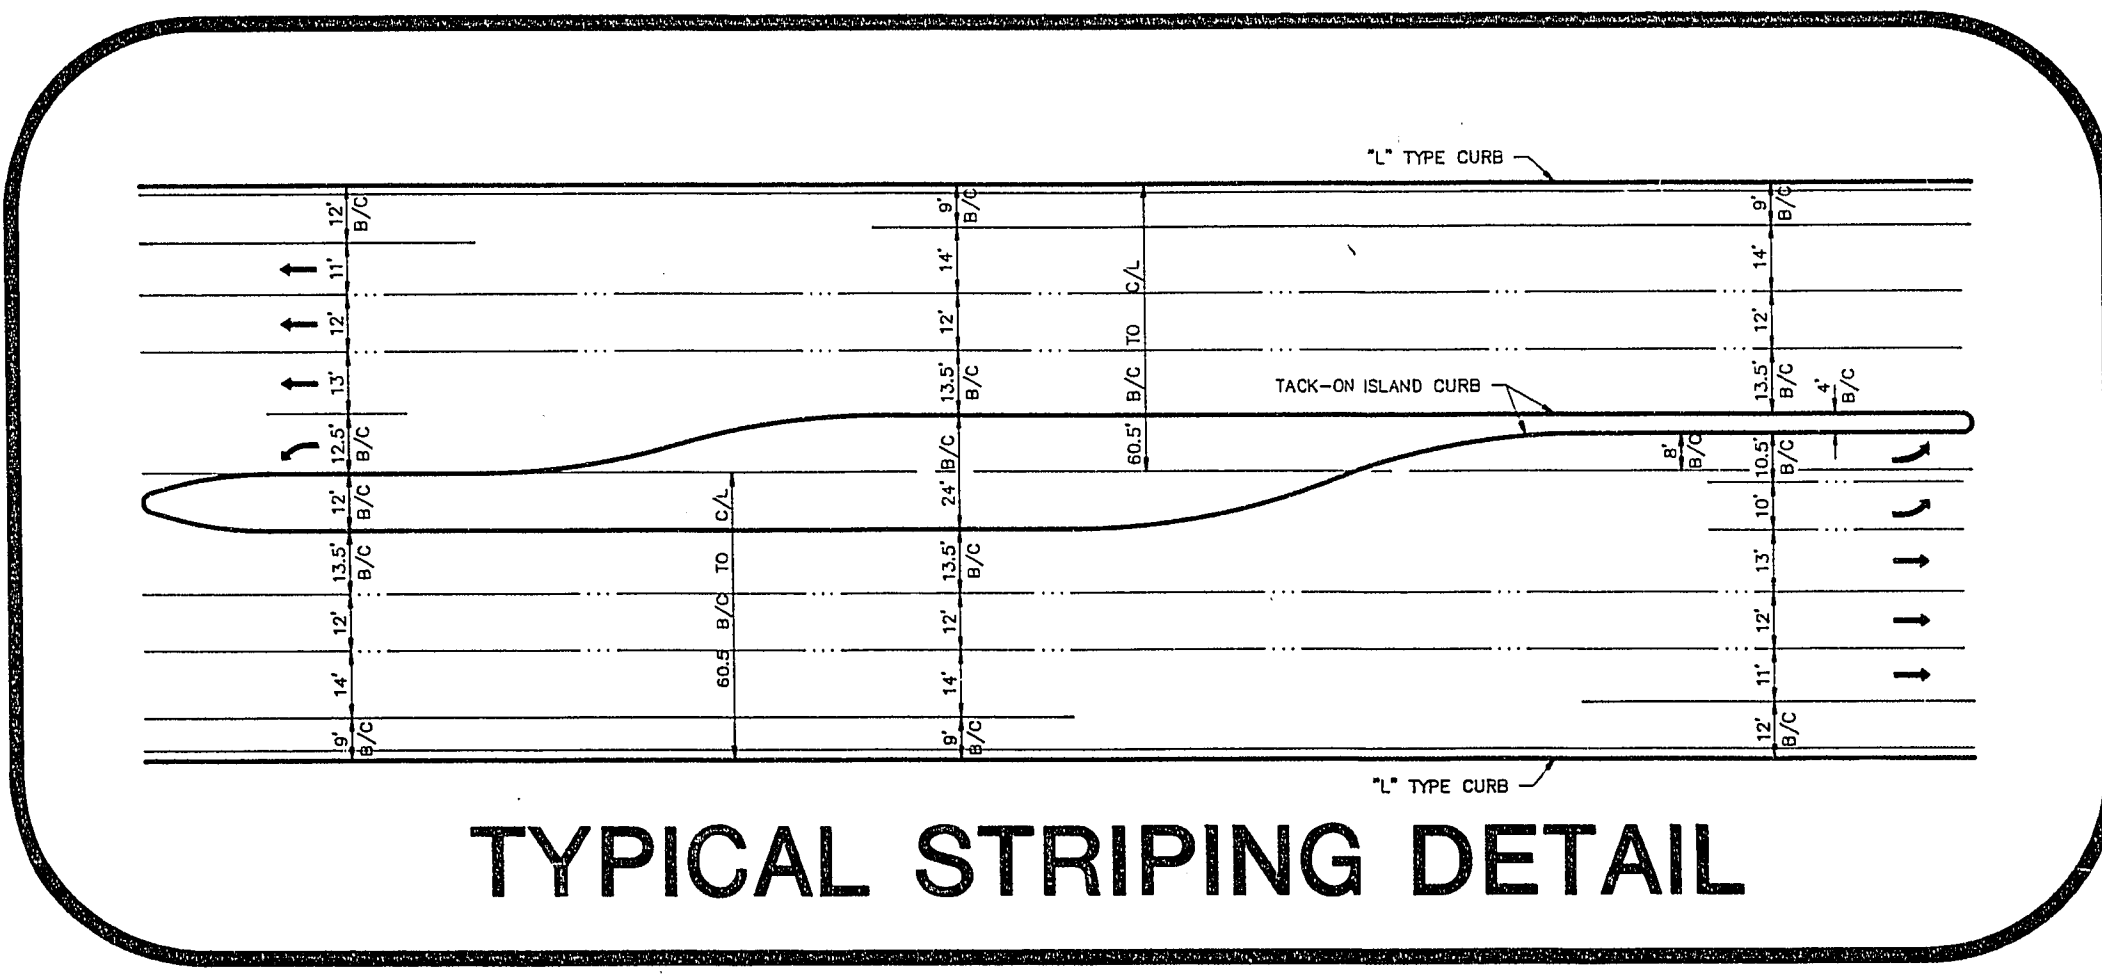

SIGN NOTES

- ALL SIGNS SHALL BE INSTALLED IN ACCORDANCE WITH THE MANUAL ON UNIFORM TRAFFIC CONTROL DEVICES (M.U.T.C.D.), LATEST EDITION.
- SIGN POSTS SHALL BE INSTALLED PER ONE OF THE FOLLOWING STANDARD DRAWINGS: CLARK COUNTY STANDARD DRAWING NUMBERS 226 AND 227, OR CITY OF LAS VEGAS STANDARD DRAWING NUMBER 404.1701. CLEAR HEIGHT TO THE LOWER EDGE OF ALL SIGNS, EXCEPT STREET NAME SIGNS, SHALL BE SEVEN (7) FEET, MINIMUM.
- INSTALL R1-1 SIGN (30" x 30"), IF NOT EXISTING.
- SIGN POSTS SHALL BE INSTALLED PER CITY OF LAS VEGAS STANDARD DRAWING NUMBERS 404.1702 AND 404.1703.
- INSTALL R2-1 SIGN "SPEED LIMIT 45" (24" x 30") AT APPROXIMATELY 250 FEET FROM CENTERLINE OF INTERSECTING STREETS.
- INSTALL R8-3A SIGNS (18" x 18") AT 120' MAXIMUM SPACING ALONG EACH SIDE OF SAHARA AVENUE.
- INSTALL R3-7R SIGN "RIGHT LANE MUST TURN RIGHT" (30" x 30").

REVISION

BY	
DATE	
REV	
DATE	


ES&S ENGINEERS & SURVEYORS, INC.
 1000 W. WASHINGTON BLVD., SUITE 200
 LAS VEGAS, NV 89102
 SUBMITTED BY: [Signature]
 9/1/92

TRAFFIC DELINEATION AND SIGNAGE PLAN

S.I.D. No. 1427 - SAHARA AVENUE
 (DURANGO DRIVE TO RAINBOW BOULEVARD)

W.O. #: 130-9520
 BY: GENE/DSR
 DATE: SEPT. 1991
 SCALE: 1"=100'

CLV DRAWING No. 107-V-2036
 T-9 41
 43

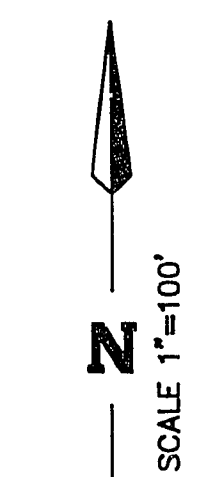

21603

"As Built" 107-V-2036