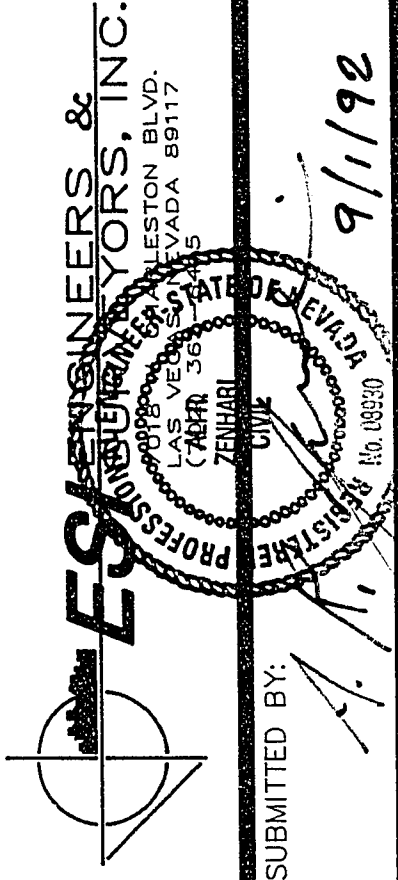


5-2-96

SUMMARY OF ESTIMATED QUANTITIES

ITEM	UNIT	SHEET 3	SHEET 4	SHEET 5	PROJECT TOTALS
TRAFFIC SIGNAL ● BUFFALO DRIVE	L.S.										1																	1
TRAFFIC SIGNAL ● TENAYA WAY	L.S.														1													1
TRAFFIC SIGNAL (UNDERGROUND) ● CIMARRON ROAD (INCL. "H" POLES)	L.S.					1																						1
UPGRADE TRAFFIC SIGNAL ● DURANGO DRIVE	L.S.	1																										1
PERMANENT SIGNS	EA.																											202
REMOVE EXIST. SIGNS	EA.	2	1		8	7		3	3	6	4	2	5	5	4	6	7	5	1									69
INSTALL STREET NAME SIGN	EA.																											8
THERMOPLASTIC PVMNT. MARKING "ONLY"	EA.																											8
THERMOPLASTIC PVMNT. MARKING ARROW	EA.																											16
THERMOPLASTIC PVMNT. MARKING "BIKE"	EA.																											44
THERMOPLASTIC PVMNT. MARKING "LANE"	EA.																											44
THERMOPLASTIC PAVEMENT MARKING CROSSWALK & STOP BARS	S.F.																											1,335
THERMOPLASTIC PAVEMENT MARKING (4")	L.F.																											14,469
THERMOPLASTIC PAVEMENT MARKING (6")	L.F.																											400
PAINTED PAVEMENT MARKING "BIKE"	EA.																											28
PAINTED PAVEMENT MARKING "LANE"	EA.																											28
PAINTED PAVEMENT MARKING (4")	L.F.																											4,829
PAINTED PAVEMENT MARKING (6")	L.F.																											600
TYPE I FILM "ONLY"	EA.																											6
TYPE I FILM ARROW	EA.																											12
TYPE I FILM "BIKE"	EA.																											24
TYPE I FILM "LANE"	EA.																											24
TYPE I FILM CROSSWALK & STOP BARS	S.F.																											2,614
TYPE II FILM (4")	L.F.																											7,482
TYPE II FILM (6")	L.F.																											400
TYPE II FILM (8")	L.F.																											789
TYPE II FILM (12")	L.F.																											375
RELOCATE WATER METER	EA.																	2										2
REMOVE WATER SPIGOT	EA.																	1										1
RELOCATE FIRE HYDRANT	EA.												2				1	2										5
6" WATER LATERAL	EA.														2			1										3
8" WATER LATERAL	EA.											1	2	1				1										6
6" SEWER LATERAL	EA.					1									1	1		1	1									5
8" SEWER LATERAL	EA.					1						2	2	1			1	1										8
10" PVC SEWER MAIN	L.F.				70	70					70																	210
15" PVC SEWER MAIN	L.F.	56																										56
18" PVC SEWER MAIN	L.F.														175													175
21" PVC SEWER MAIN	L.F.	379	600	600	600	600	600	600	600	600	601	610	600	600	405													7,995
24" PVC SEWER MAIN	L.F.	25																										25
60" SEWER MANHOLE	EA.	2	1	1	1	1	1	1		1	1	2	1	1	2													17
ABANDON EXIST. SEWER LINE (24")	L.S.	1	1		1																							3
TYPE "A" CIRCULAR WHITE CERAMIC MARKER	EA.																											2,473
TYPE "E" ONE WAY WHITE REFLECTIVE MARKER	EA.																											395
TYPE "F" TWO WAY WHITE/RED REFLECTIVE MARKER	EA.																											27
MEDIAN NOSE MARKER	EA.																											600

NOTE:
QUANTITIES ARE ESTIMATES ONLY. CONTRACTOR
WILL BE PAID ONLY FOR DESIGN QUANTITIES
IN PLACE.

REVISION BY DATE	SUBMITTED BY: 
------------------------	--

SUMMARY OF ESTIMATED QUANTITIES;

**S.I.D. No. 1427 - SAHARA AVENUE
(DURANGO DRIVE TO RAINBOW BOULEVARD)**

W.O. # : 130-9520
 BY : DSR
 DATE : JUNE 1992
 SCALE : NO SCALE

Call before you Dig.

1-800-227-2600
 UNDERGROUND SERVICE (USA)

C.L.V.
 DRAWING No.
 107-V-2036

24 60 3

"As Built" 107-V2036