

**Call before you Dig.**  
 1-800-227-2800  
 UNDERGROUND SERVICE USA

**NOTE:**  
 SEE SHEET 2 OF 43, GENERAL NOTE No. 17 FOR UTILITY CROSSINGS.


**NOTE:**  
 ALL FINISH GRADES OF AC PAVEMENT SHALL BE FLUSH WITH LIP OF GUTTER. ADJUST EXISTING AND PROPOSED MANHOLES IN THE PAVEMENT AREA ACCORDINGLY.

REVISION	DATE	BY

APPROVED BY: *[Signature]*  
 DATE: 05/01/91  
 BY: CHAO/BLOOM

**ES&S ENGINEERS & SURVEYORS, INC.**  
 7001 W. DURANGO AVENUE, SUITE 100  
 DENVER, CO 80231  
 (303) 733-8817

PROJECT: SAHARA AVENUE  
 SHEET: 43 OF 43

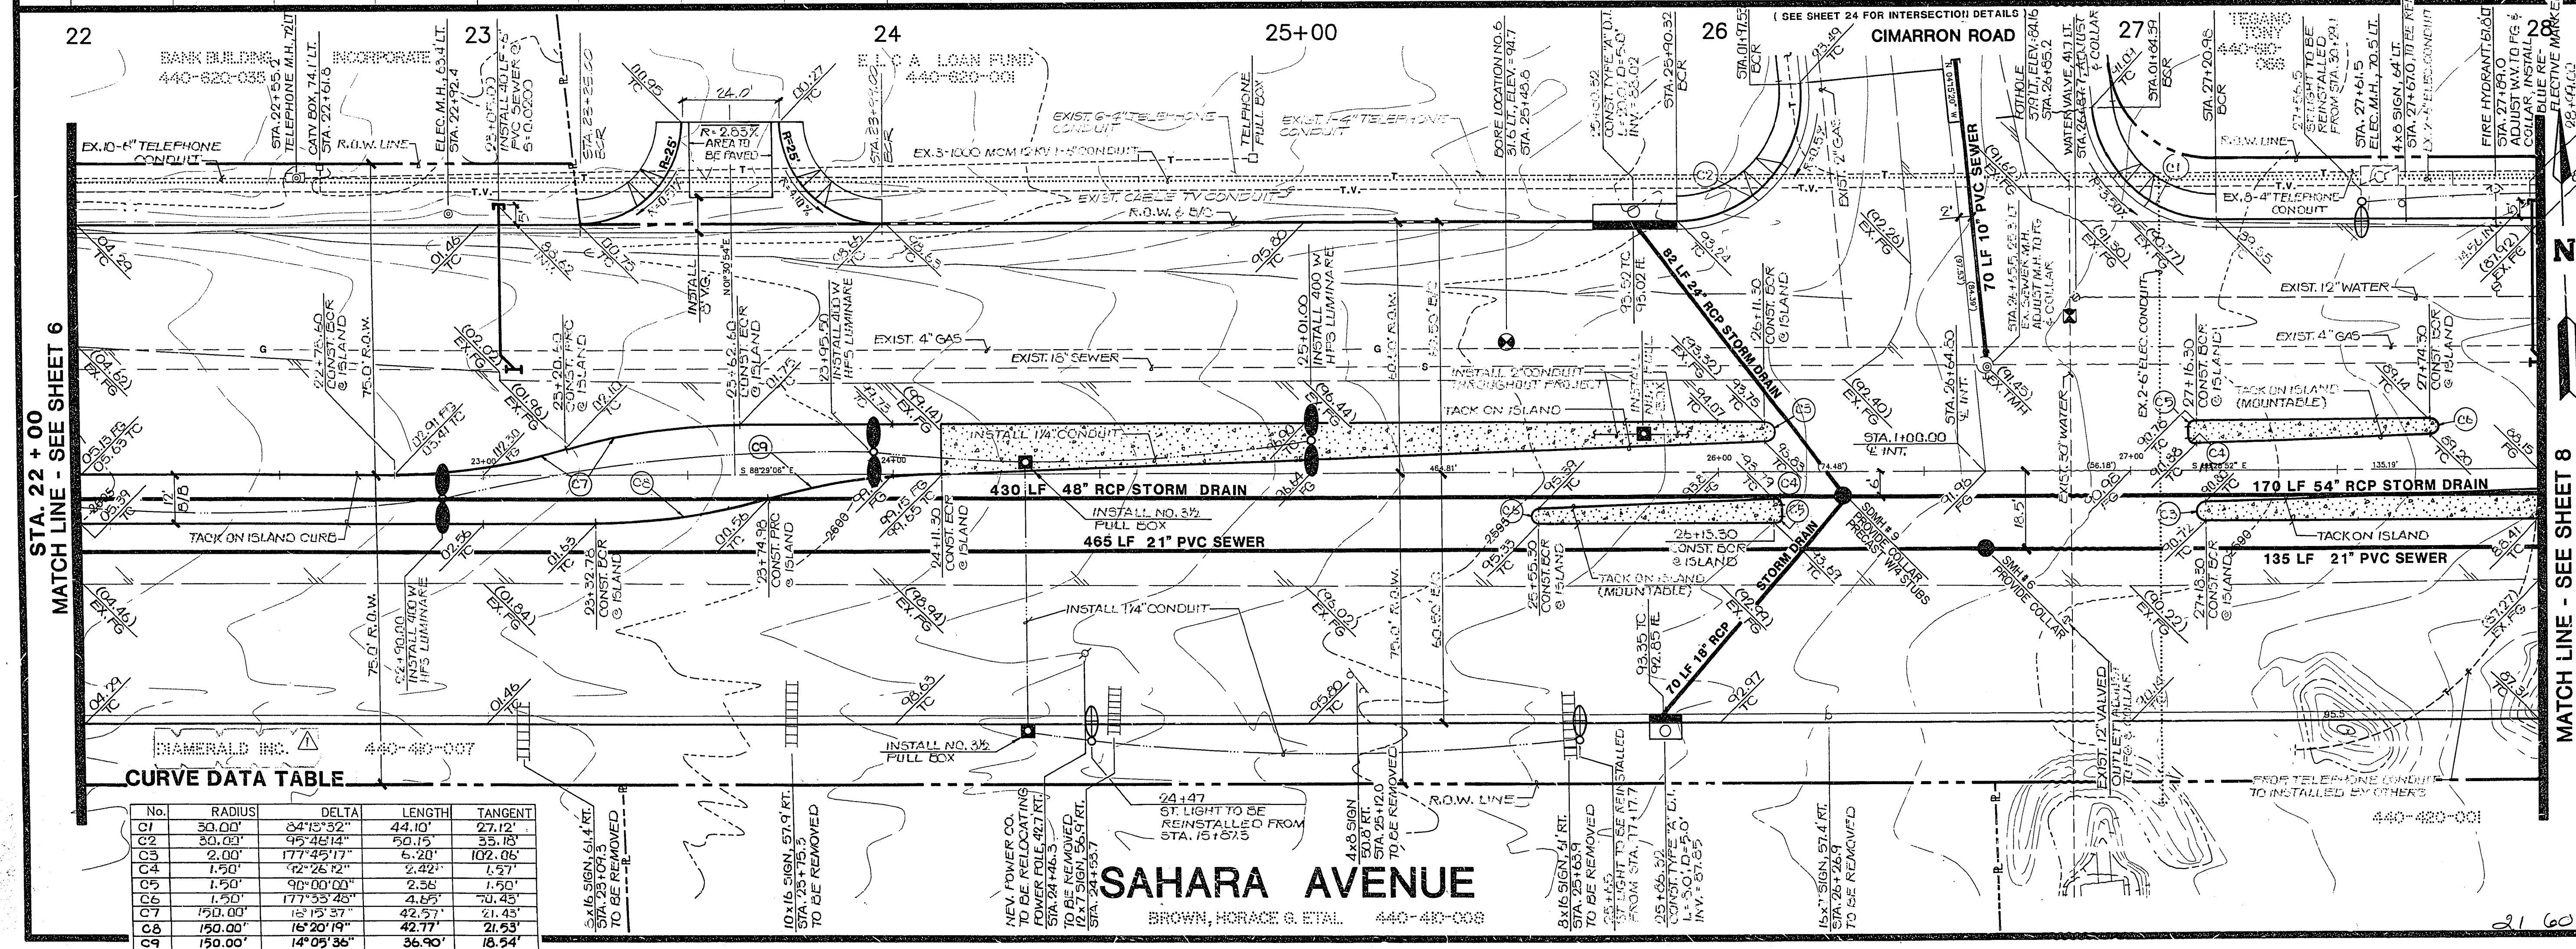

**CURVE DATA TABLE**

No.	RADIUS	DELTA	LENGTH	TANGENT
C1	30.00'	34°15'32"	44.10'	27.12'
C2	30.00'	95°48'14"	50.15'	35.15'
C3	2.00'	177°45'17"	5.20'	102.06'
C4	1.50'	62°26'52"	2.42'	1.97'
C5	1.50'	96°00'00"	2.38'	1.50'
C6	1.50'	177°33'48"	4.65'	70.45'
C7	150.00'	15°13'37"	42.57'	21.43'
C8	150.00'	162°01'19"	42.71'	21.53'
C9	150.00'	14°05'36"	36.90'	18.54'

**SAHARA AVENUE**  
 BROWN, HORACE & ASSOCIATES, INC.  
 440-40-001

**STREET & SEWER PLAN & PROFILE**  
 ( STA. 22+00 TO STA. 28+00 )

PROJECT: SAHARA AVENUE  
 ( DURANGO DRIVE TO RAINBOW BOULEVARD )

W.O. #: 130-9520  
 BY: CHAO/BLOOM  
 DATE: 5/91  
 SCALE: VERT. 1"=4'  
 HORIZ. 1"=20'

C.L.V. DRAWING NO. **7**  
 107-V-2036 **43**

21 60 3  
 "As Built" 107-V-2036