


REVISION	DATE	BY	REASON
1	07.15.91	J. MC	REVISIONS TO WATER LINES

DATE: 07.15.91
 DRAWN BY: J. MC
 CHECKED BY: J. MC
 APPROVED BY: J. MC

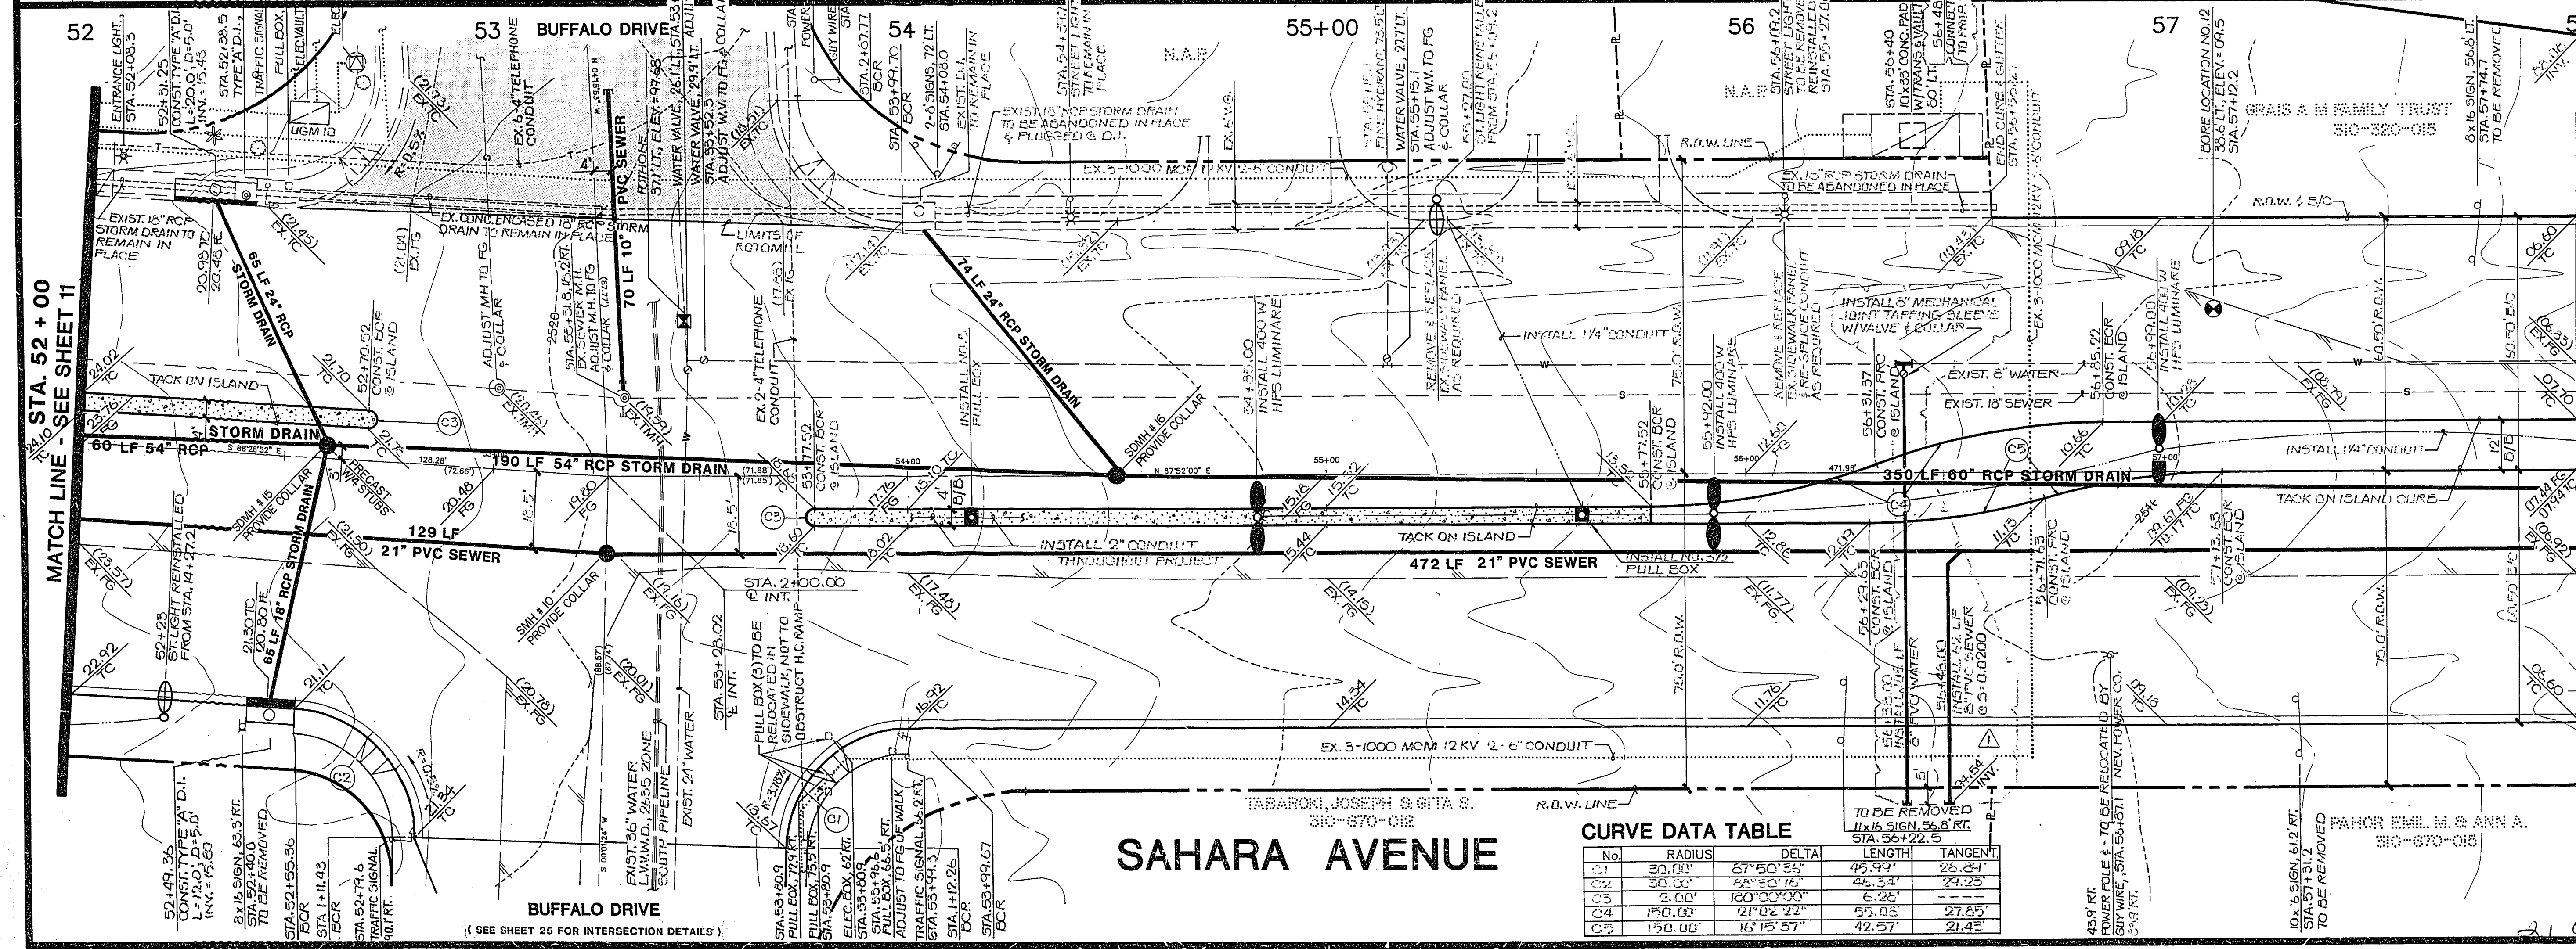

STREET & SEWER PLAN & PROFILE
 (STA. 52+00 TO STA. 58+00)

S.I.D. 1427 - SAHARA AVENUE
(DURANGO DRIVE TO RAINBOW BOULEVARD)

W.O. #: 130-9520
 BY: CHAO/BLOOM
 DATE: 5/91
 SCALE: VERT. 1"=4'
 HORIZ. 1"=20'

CLV. DRAWING NO. 12/43
 107-V-2036

CURVE DATA TABLE

No.	RADIUS	DELTA	LENGTH	TANGENT
01	50.00'	57°50'35"	45.99'	26.04'
02	50.00'	57°50'15"	45.51'	24.25'
03	2.00'	180°00'00"	6.28'	1.11'
04	150.00'	121°02'42"	55.03'	27.63'
05	150.00'	15°15'57"	42.57'	21.43'

SAHARA AVENUE

Call before you Dig.
 1-800-227-2600
 UNDERGROUND SERVICE USA

DATE: 5/91
 SCALE: VERT. 1"=4'
 HORIZ. 1"=20'

"As Built" 107V2036