

Call before you Dig.
1-800-227-2600
UNDERGROUND SERVICE USA


NOTE:
SEE SHEET 2 OF 43, GENERAL NOTE No. 17 FOR UTILITY CROSSINGS.

NOTE:
ALL FINISH GRADES OF AC PAVEMENT SHALL BE FLUSH WITH LIP OF GUTTER. ADJUST EXISTING AND PROPOSED MANHOLES IN THE PAVEMENT AREA ACCORDINGLY.

APPROVAL	REVISION
DATE	BY
1 7-5-94	O.F. RELOCATED SD MAIN #27-18" RCP

ES ENGINEERS & ARCHITECTS, INC.
2020 BROADWAY, SUITE 200
DENVER, CO 80202
TEL: 303.733.8800
FAX: 303.733.8801

SUBMITTED BY: *[Signature]* 6/23/92

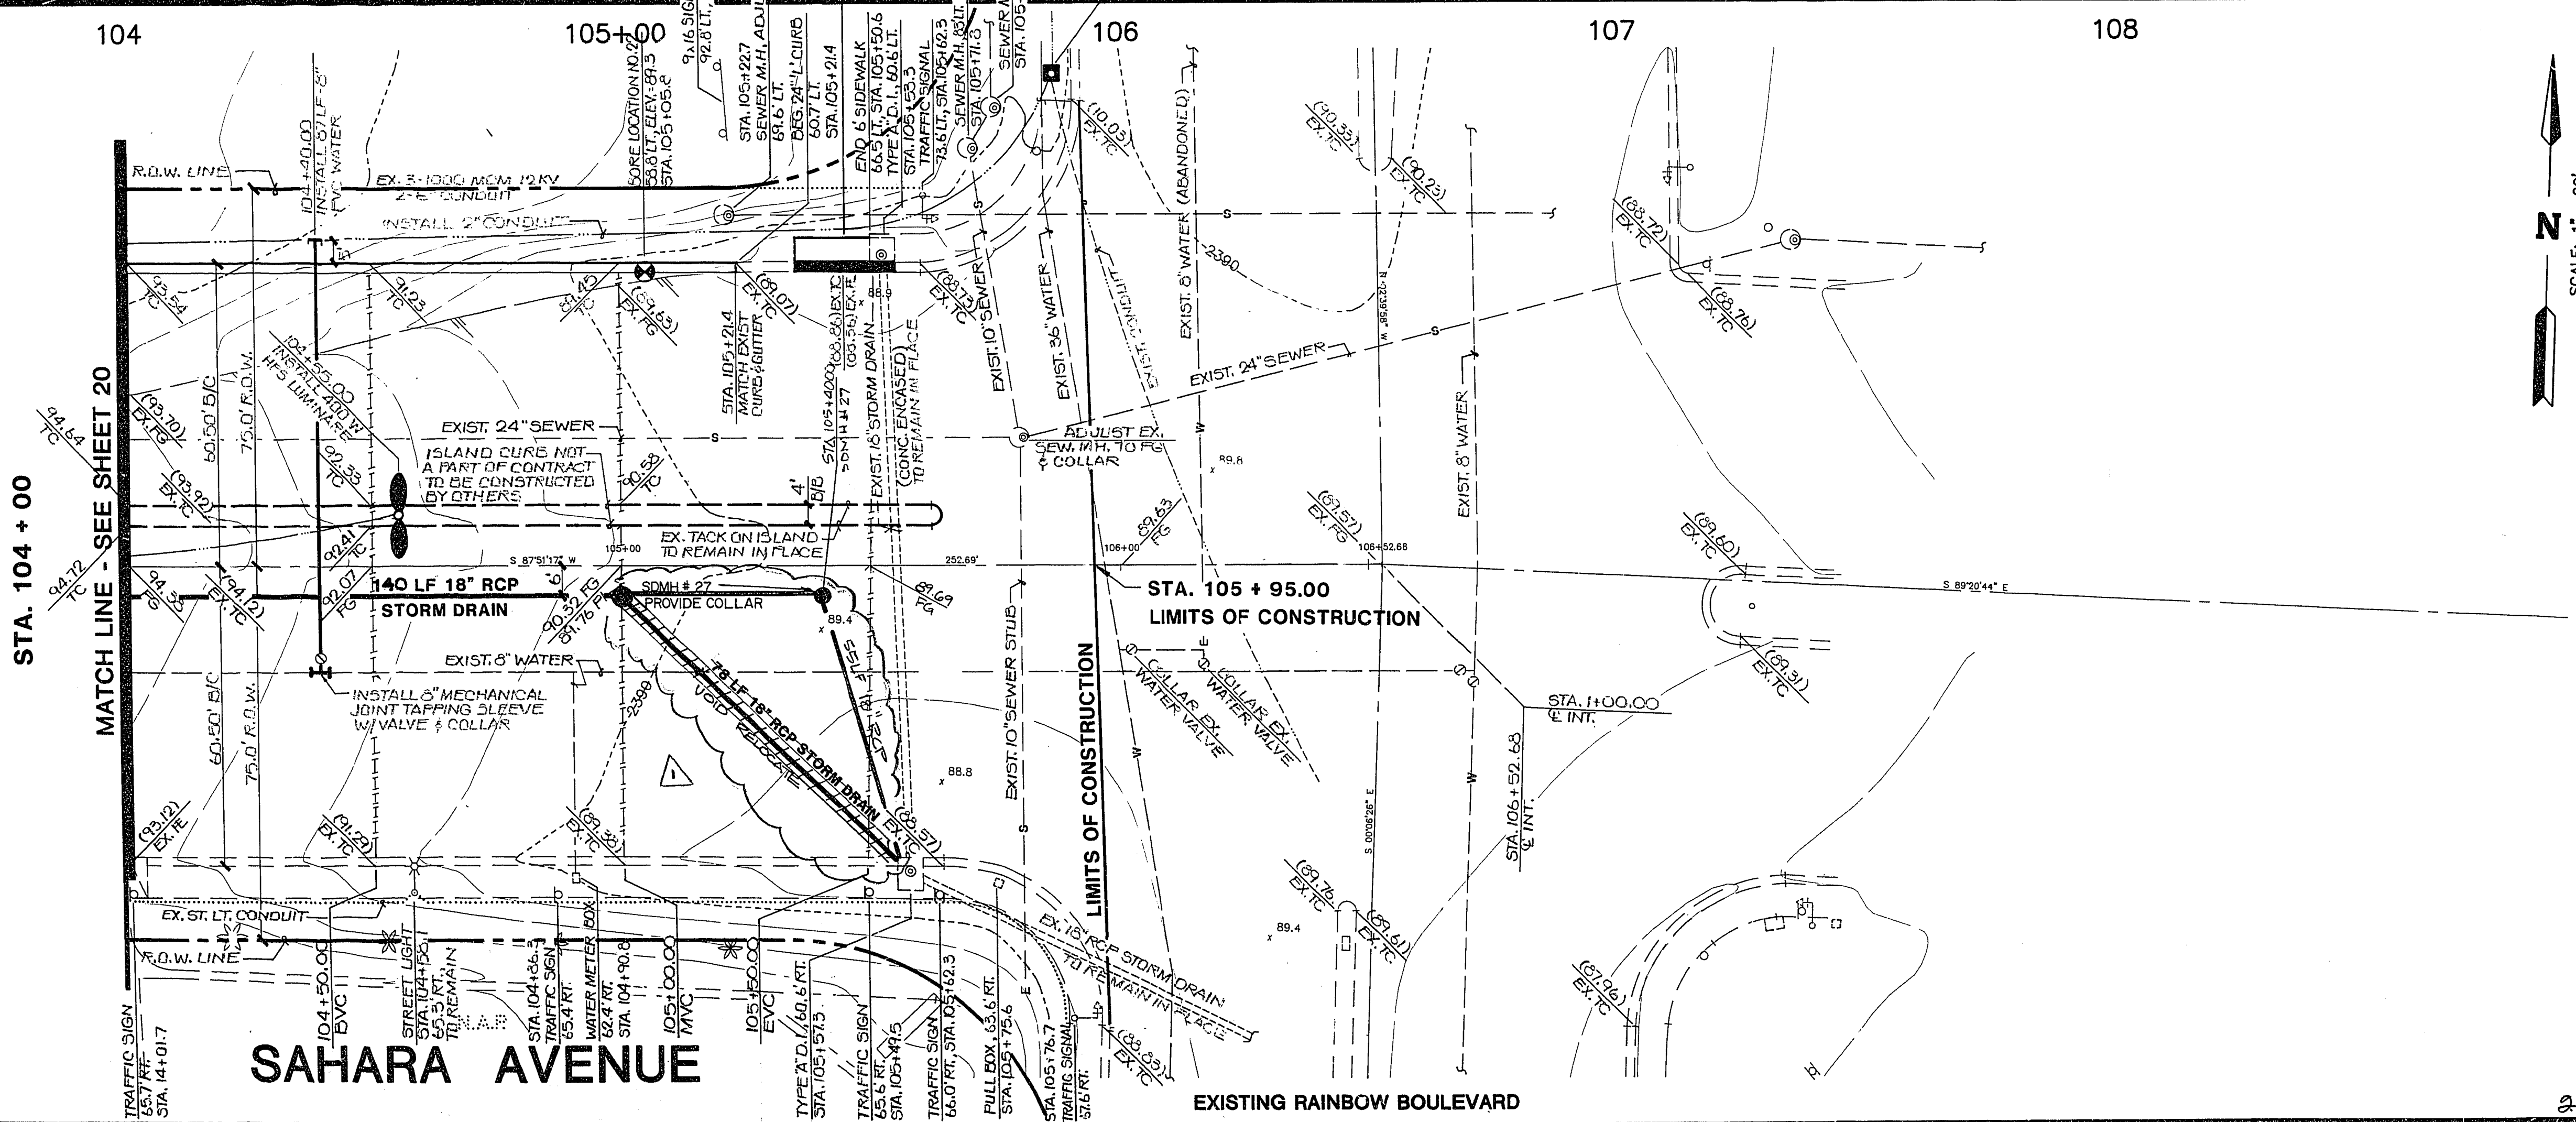

N
SCALE: 1" = 20'

TITLE
STREET & SEWER PLAN & PROFILE
(STA. 104+00 TO STA. 106+52.68)

PROJECT
S.I.D. 1427- SAHARA AVENUE
(DURANGO DRIVE TO RAINBOW BOULEVARD)

W.O. #: 130-9520
BY: CHAO/BLOOM
DATE: 5/91
SCALE: VERT. 1"=4'
HORIZ. 1"=20'

CLV. DRAWING NO. **21**
107-V-2036 **43**

21 603

"As Built" 107-V2036