
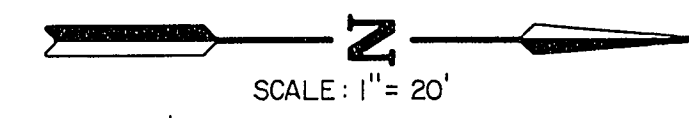


NOTE:  
SEE SHEET 2 OF 43, GENERAL NOTE No. 17 FOR UTILITY CROSSINGS.



ES ENGINEERS & ARCHITECTS INC.  
REGISTERED PROFESSIONAL ENGINEERS & ARCHITECTS  
STATE OF ARIZONA  
No. 10023 AND 10415  
LARRY A. BLOOM  
ZENHAR  
SUBMITTED BY: [Signature]  
6/23/92

Call before you Dig.  
1-800-227-2600  
UNDERGROUND SERVICE DATA

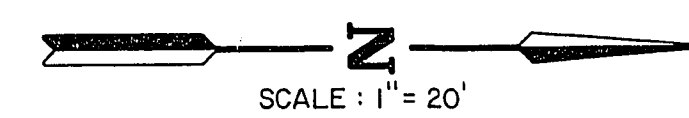

SAHARA AVENUE  
SEE SHEET 6

SAHARA AVENUE  
SEE SHEET 7

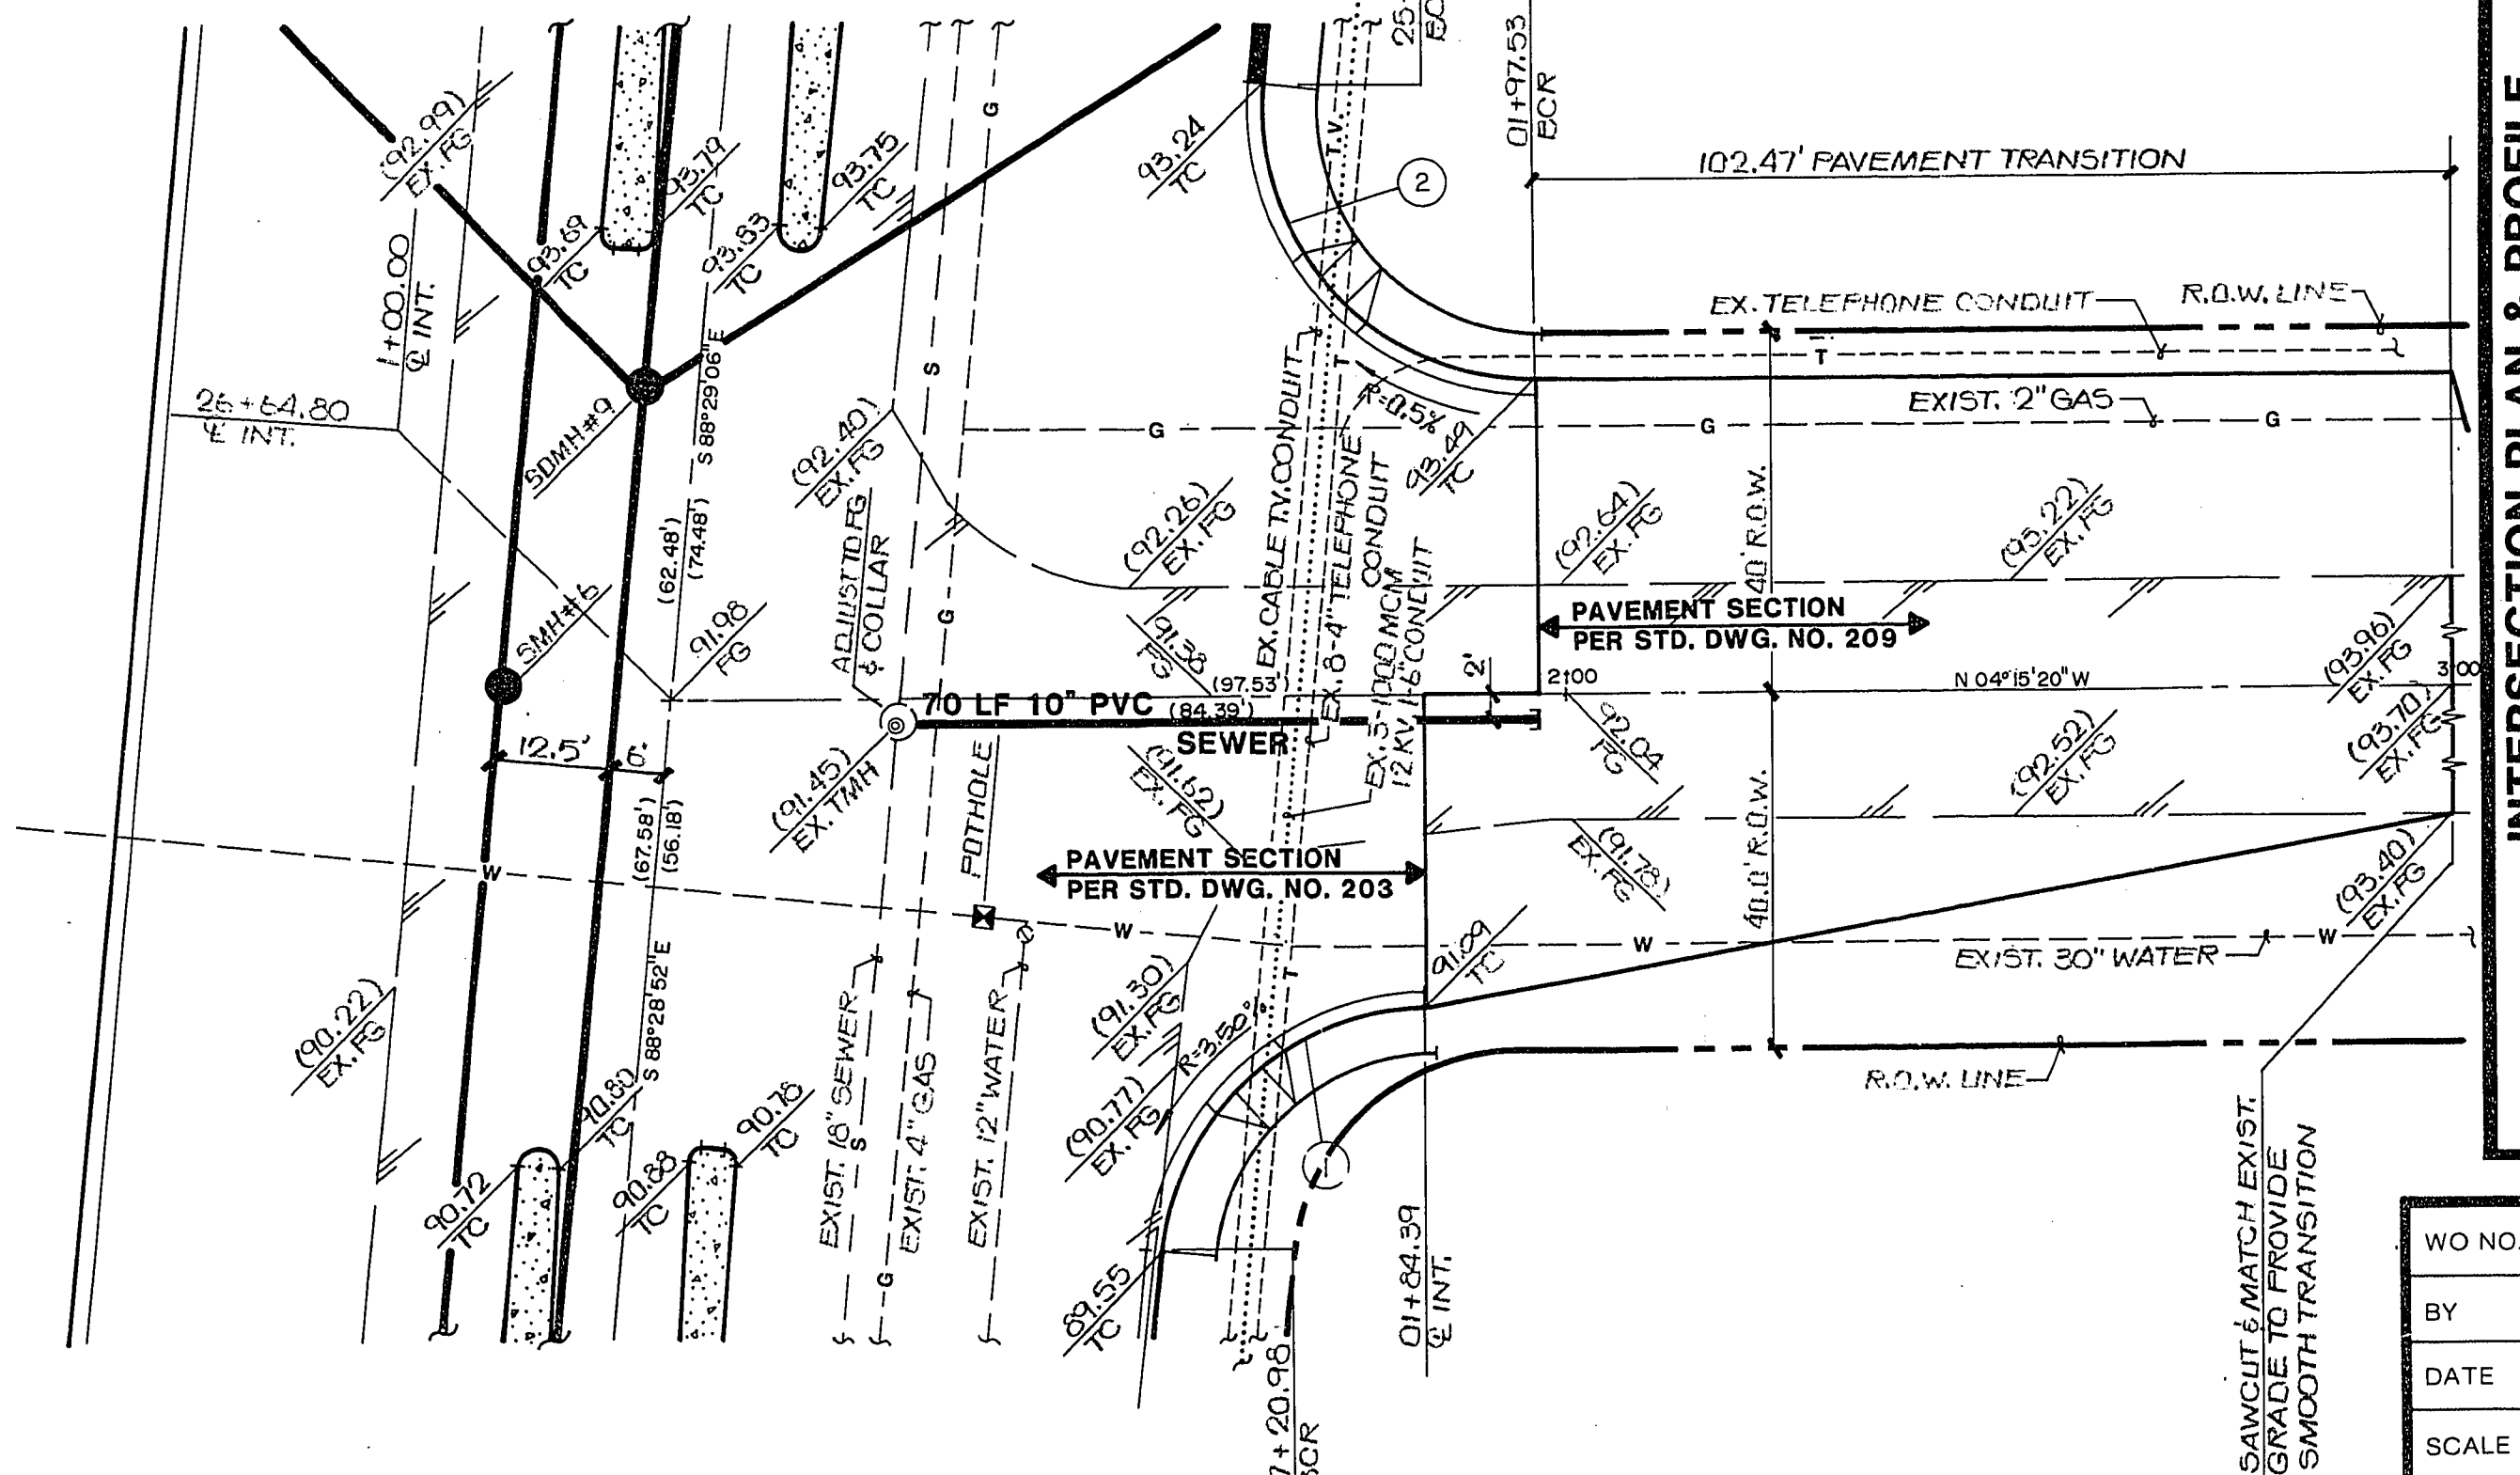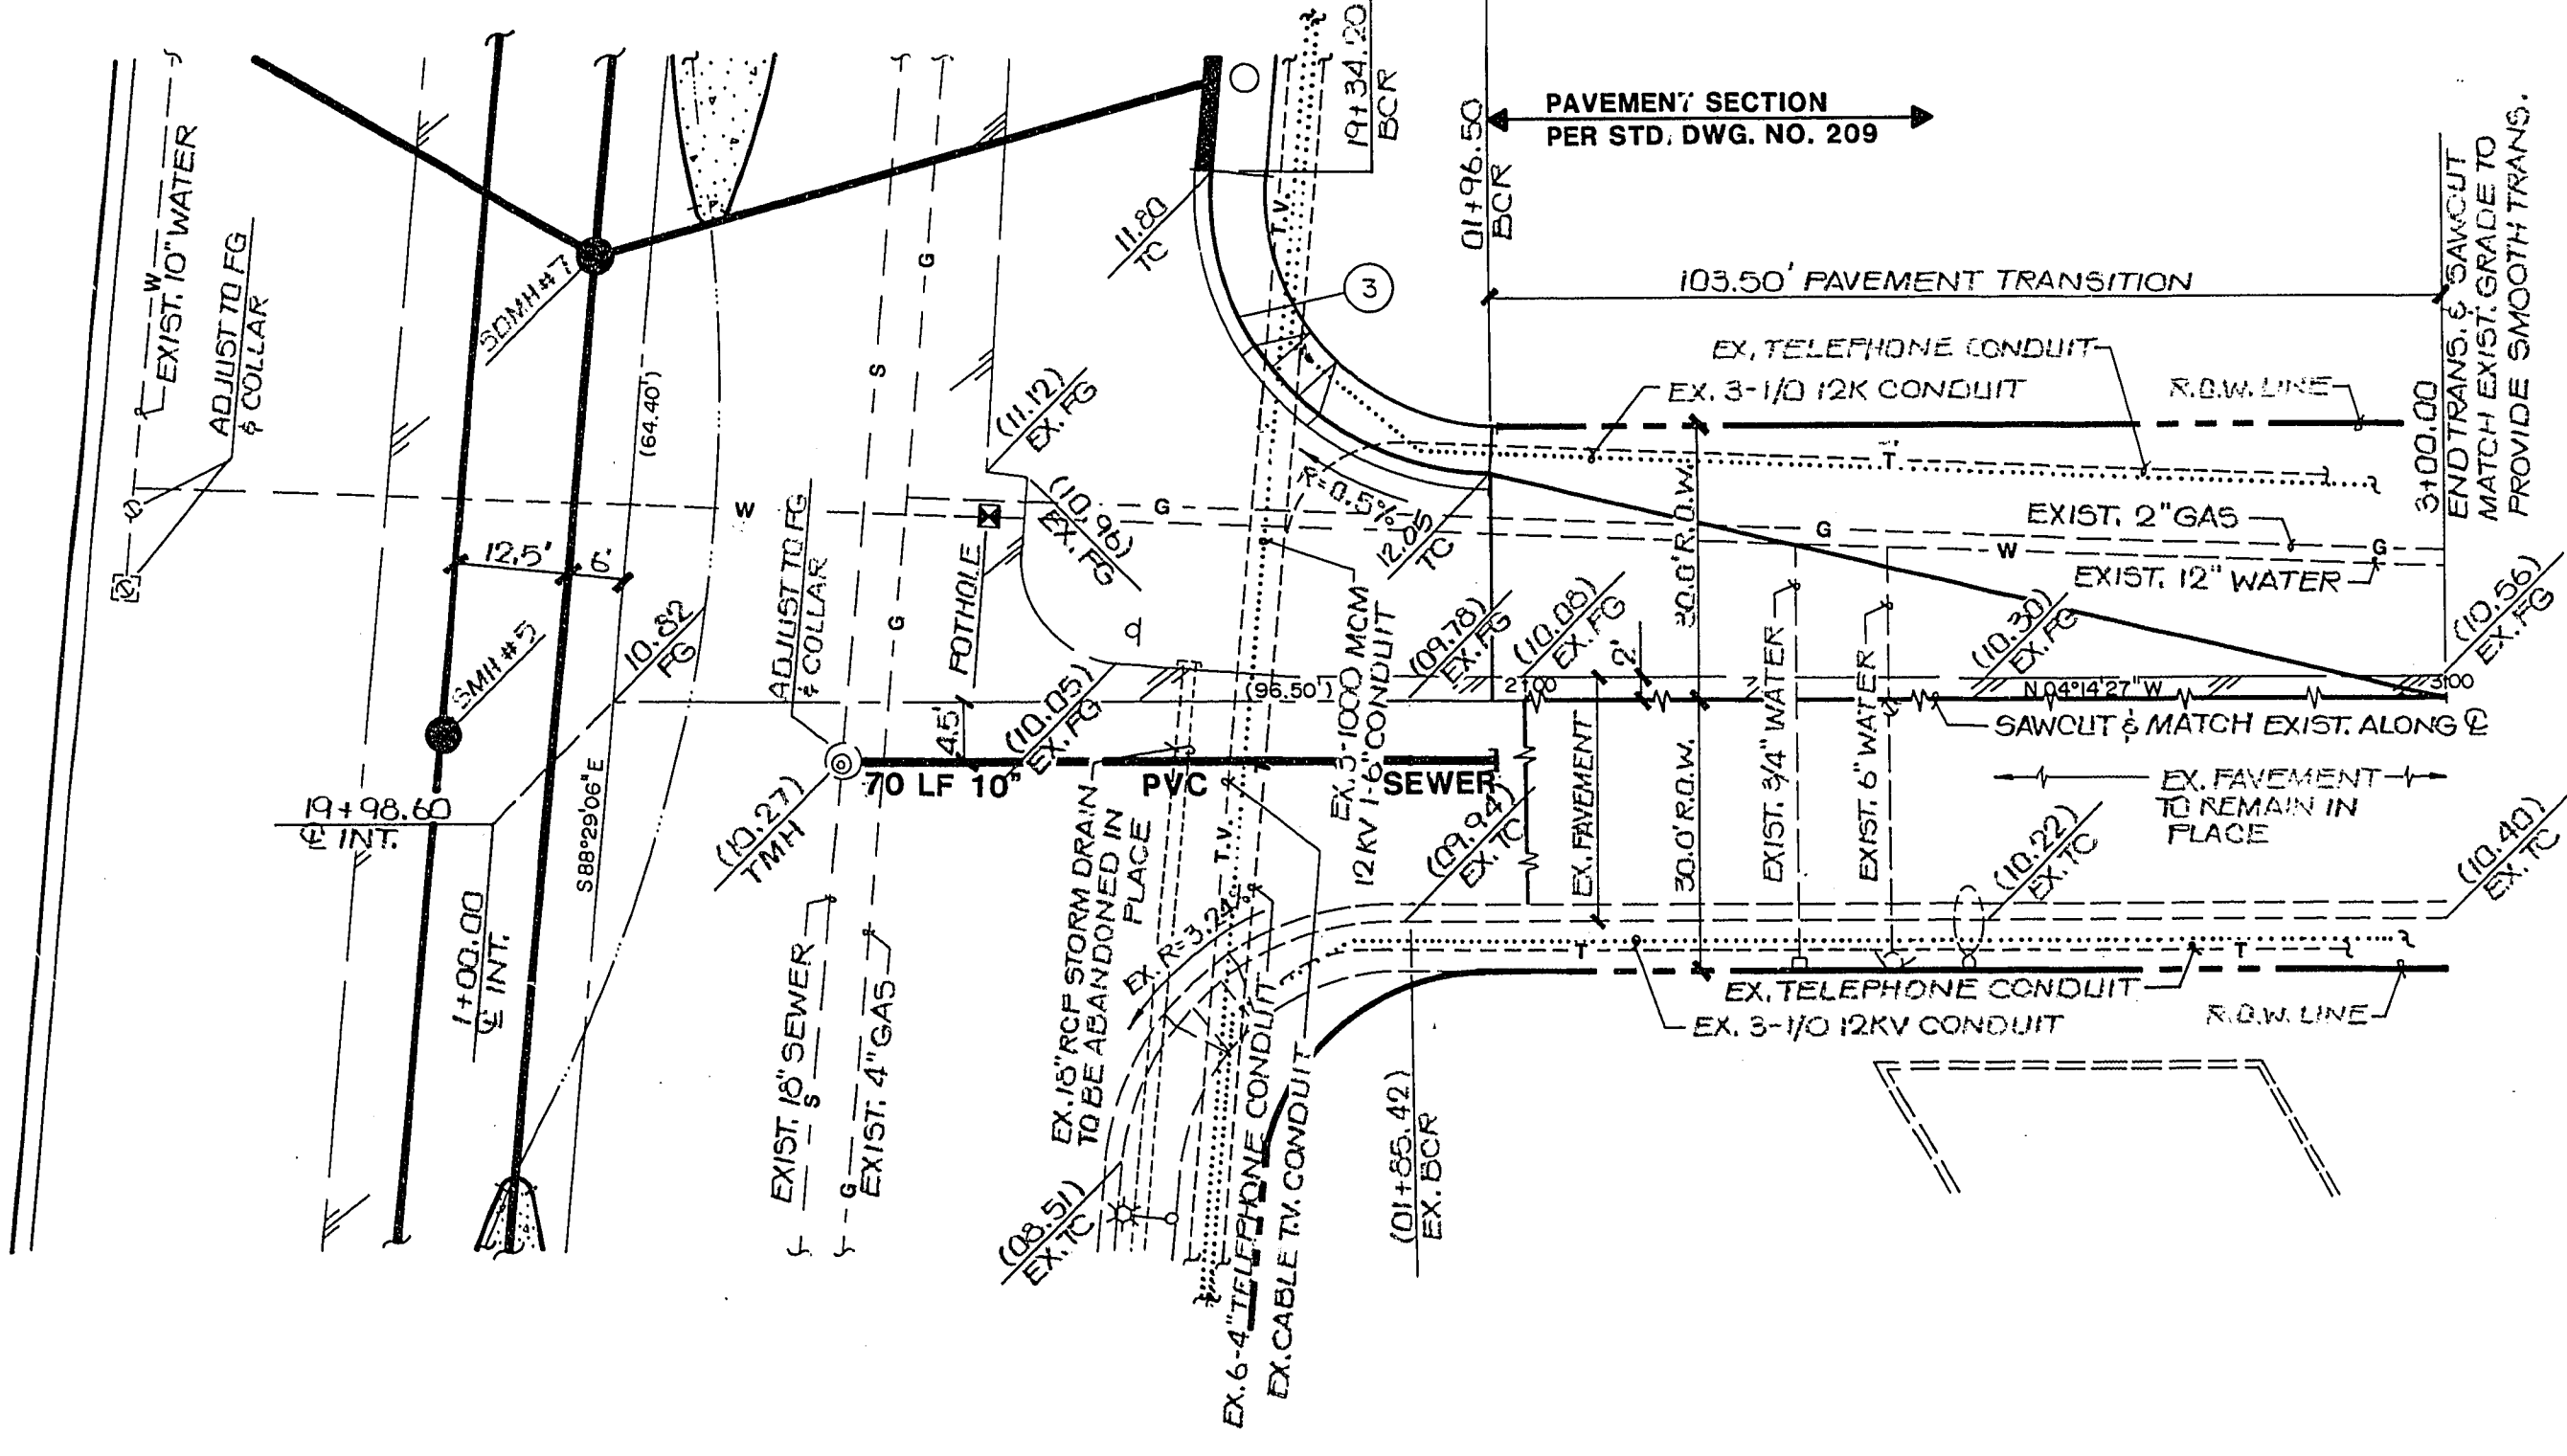

TOMSIK STREET

CIMARRON ROAD

CURVE DATA TABLE

No.	RADIUS	DELTA	LENGTH	TANGENT
1	30.00'	84°13'32"	44.10'	27.12'
2	30.00'	95°46'14"	50.15'	33.18'
3	30.00'	95°45'21"	50.14'	33.18'

INTERSECTION PLAN & PROFILE  
( TOMSIK STREET & SAHARA AVENUE )  
( DURANGO DRIVE TO RAINBOW BOULEVARD )

WO NO. 130 - 9520  
BY BLOOM  
DATE 9/91  
SCALE VERT: 1" = 4'  
HORIZ: 1" = 20'

C.L.V. DRAWING NO. 24  
107-V-2036 43

21 603

As Built 107-V-2036