


NOTE:  
SEE SHEET 2 OF 143, GENERAL NOTE No. 17 FOR UTILITY CROSSINGS.

ENGINEERS & SURVEYORS INC.  
7018 W. DURANGO BOULEVARD, SUITE 100, DENVER, CO 80231  
SUBMITTED BY: [Signature]  
DATE: 6/23/92

Call before you Dig.

1-800-227-2600  
UNDERGROUND SERVICE USA

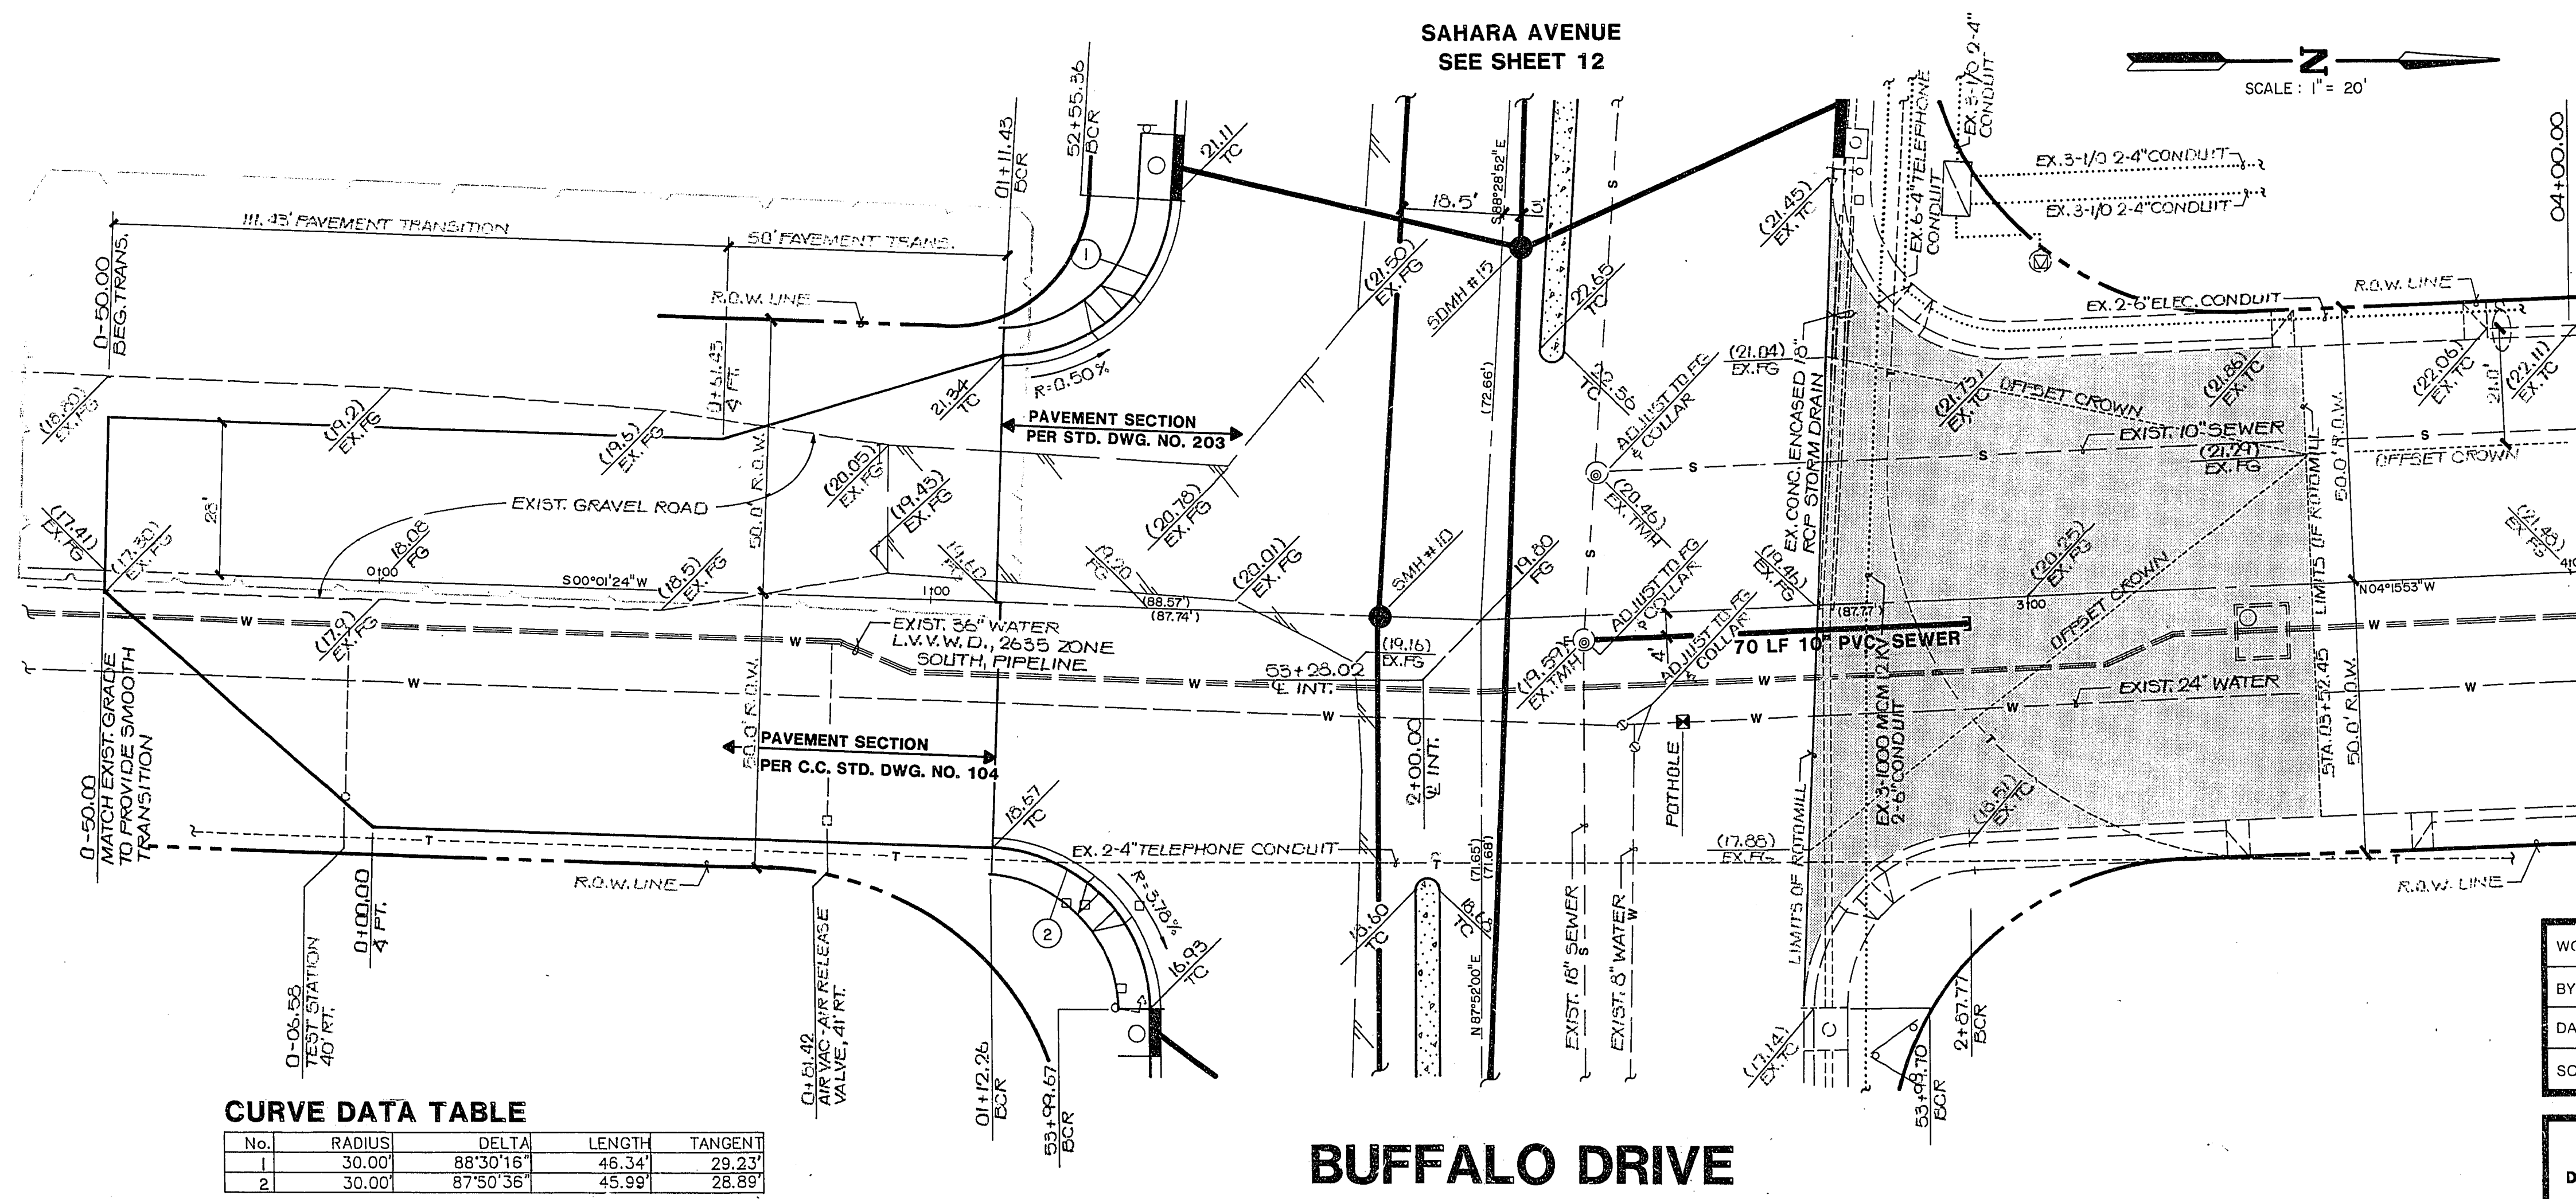

**CURVE DATA TABLE**

No.	RADIUS	DELTA	LENGTH	TANGENT
1	30.00	88°30'16"	46.34	29.23
2	30.00	87°50'36"	45.99	28.89

**INTERSECTION PLAN & PROFILE**  
( MILLER LANE & BUFFALO DRIVE )  
**S.I.D. 1427 - SAHARA AVENUE**  
( DURANGO DRIVE TO RAINBOW BOULEVARD )

WO NO. 130-9520  
BY BLOOM  
DATE 9/91  
SCALE VERT.: 1"=4'  
HORIZ.: 1"=20'

CLV. DRAWING NO. 25  
107-V-2036 43

As Built 107-V2036