


NOTE:
SEE SHEET 2 OF 43, GENERAL NOTE No. 17 FOR UTILITY CROSSINGS!

| REV | DATE | BY | REVISION |
|-----|------|----|----------|
| | | | |
| | | | |
| | | | |

ES ENGINEERS & ARCHITECTS INC.
1177 7025 303 6415
7018 W. DURANGO BOULEVARD
DENVER, CO 80231
REGISTERED PROFESSIONAL ENGINEER
NO. 117770253036415
STATE OF COLORADO
SUBMITTED BY: *[Signature]* 6/23/92


Call before you Dig.

1-800-227-2600
UNDERGROUND SERVICE USA

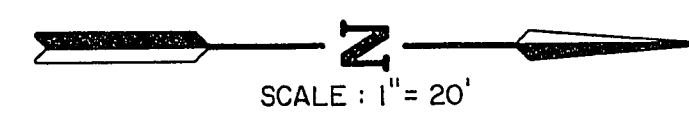

SAHARA AVENUE
SEE SHEET 13


SAHARA AVENUE
SEE SHEET 15

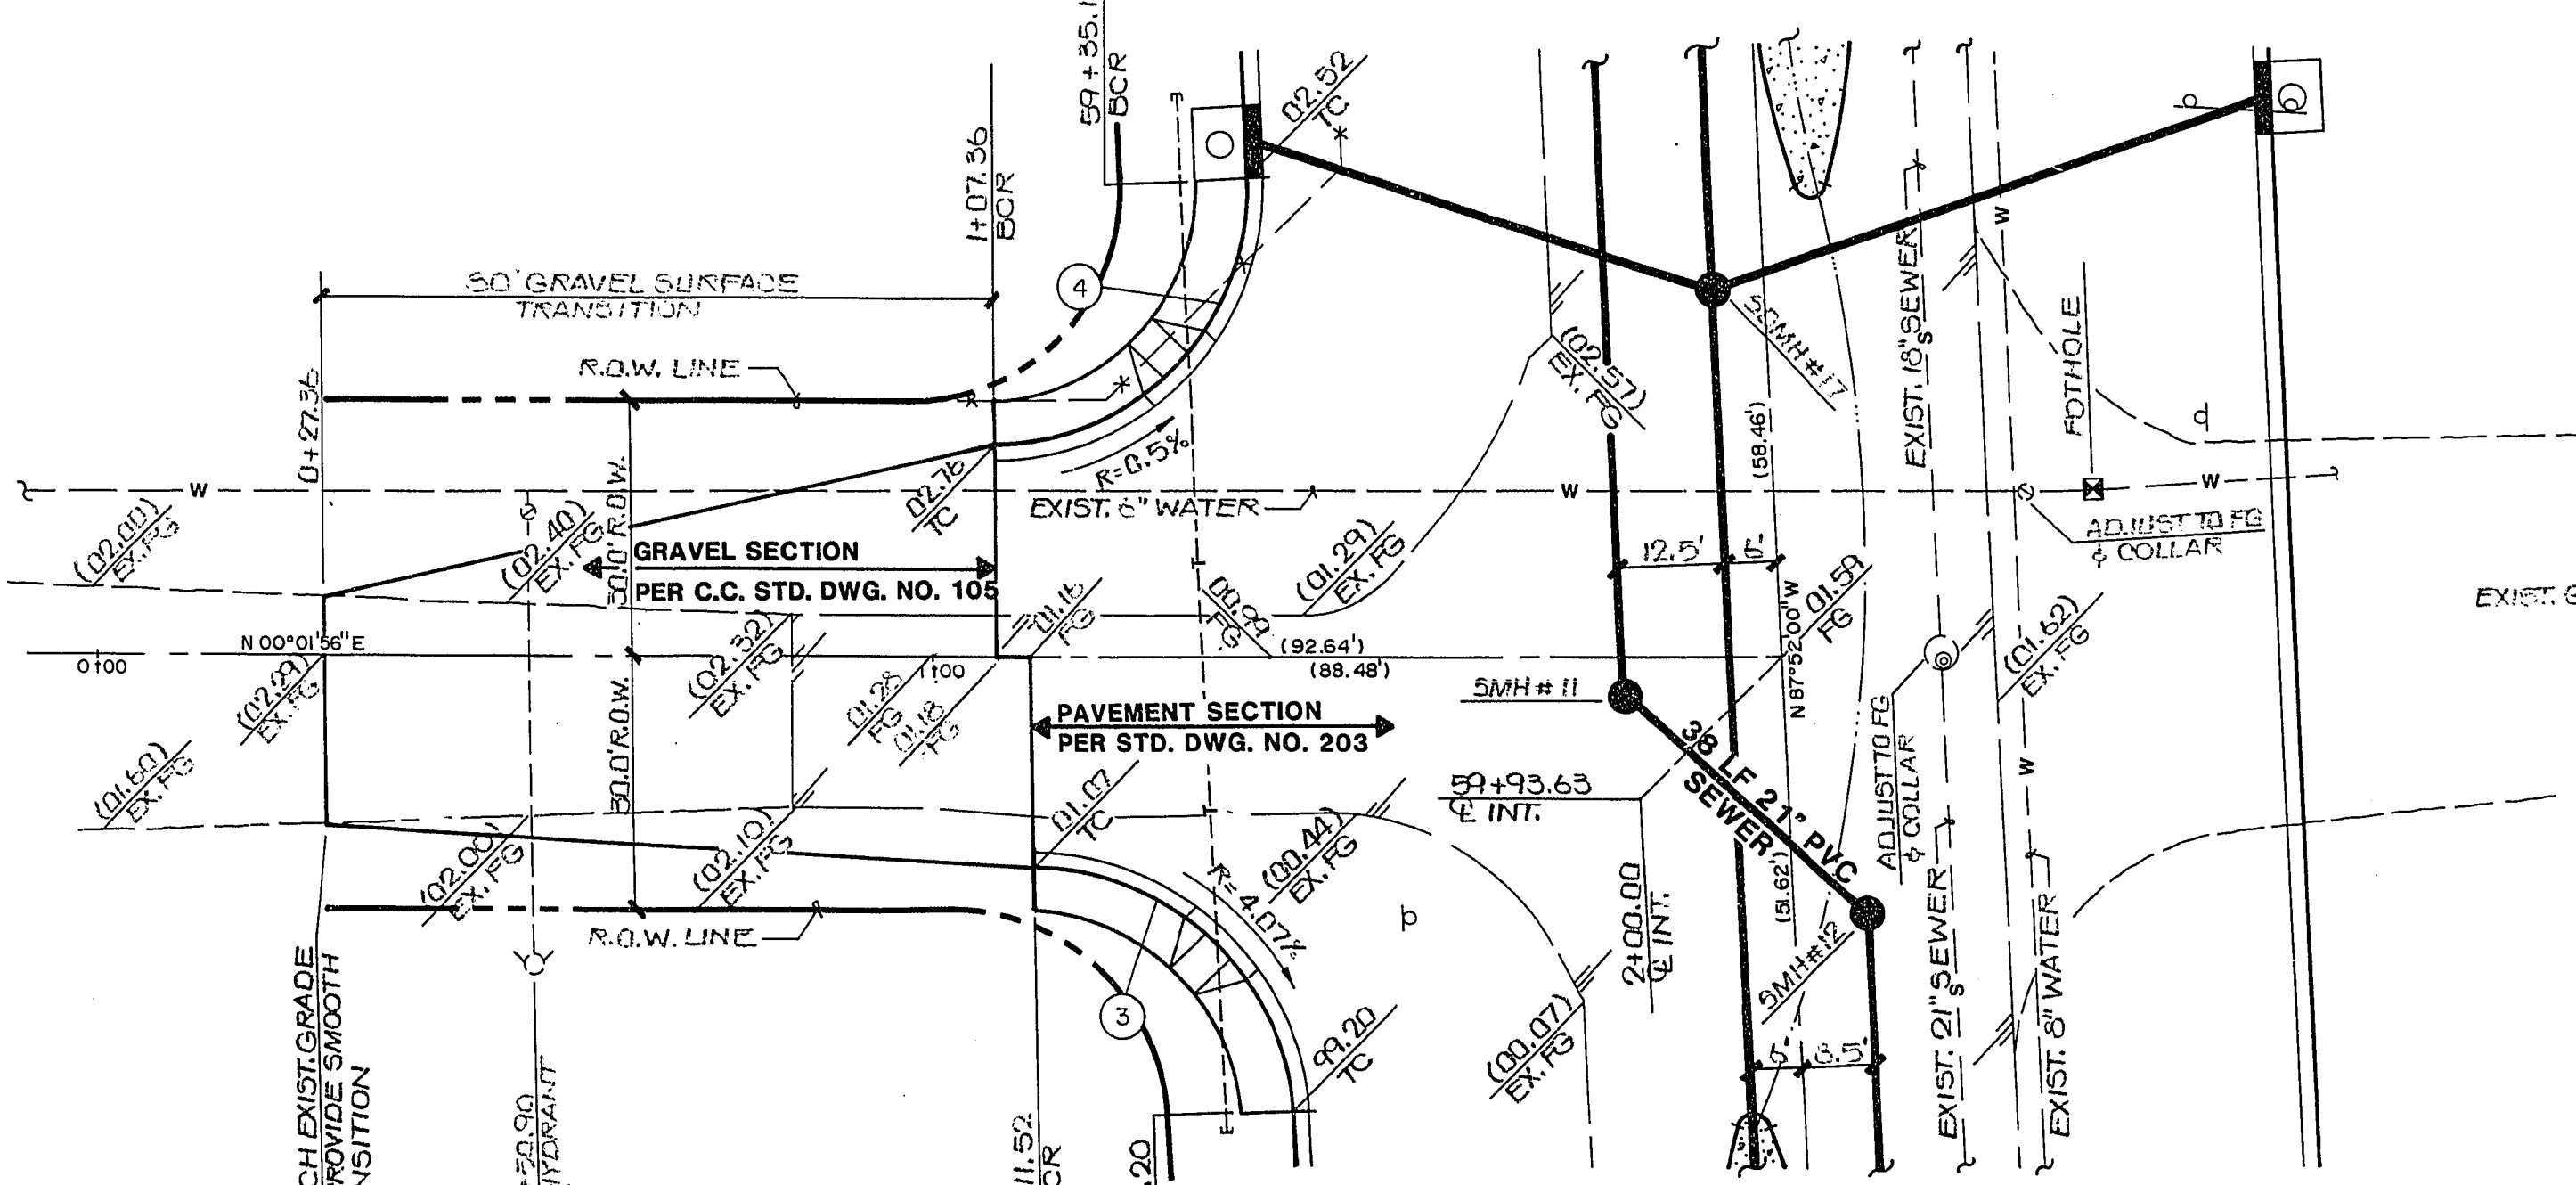

CURVE DATA TABLE

| No. | RADIUS | DELTA | LENGTH | TANGENT |
|-----|--------|-----------|--------|---------|
| 1 | 30.00' | 87°50'10" | 45.99' | 28.89' |
| 2 | 30.00' | 92°09'50" | 48.26' | 31.15' |
| 3 | 30.00' | 87°50'04" | 45.99' | 28.89' |
| 4 | 30.00' | 92°09'58" | 48.26' | 31.16' |

TIOGA WAY

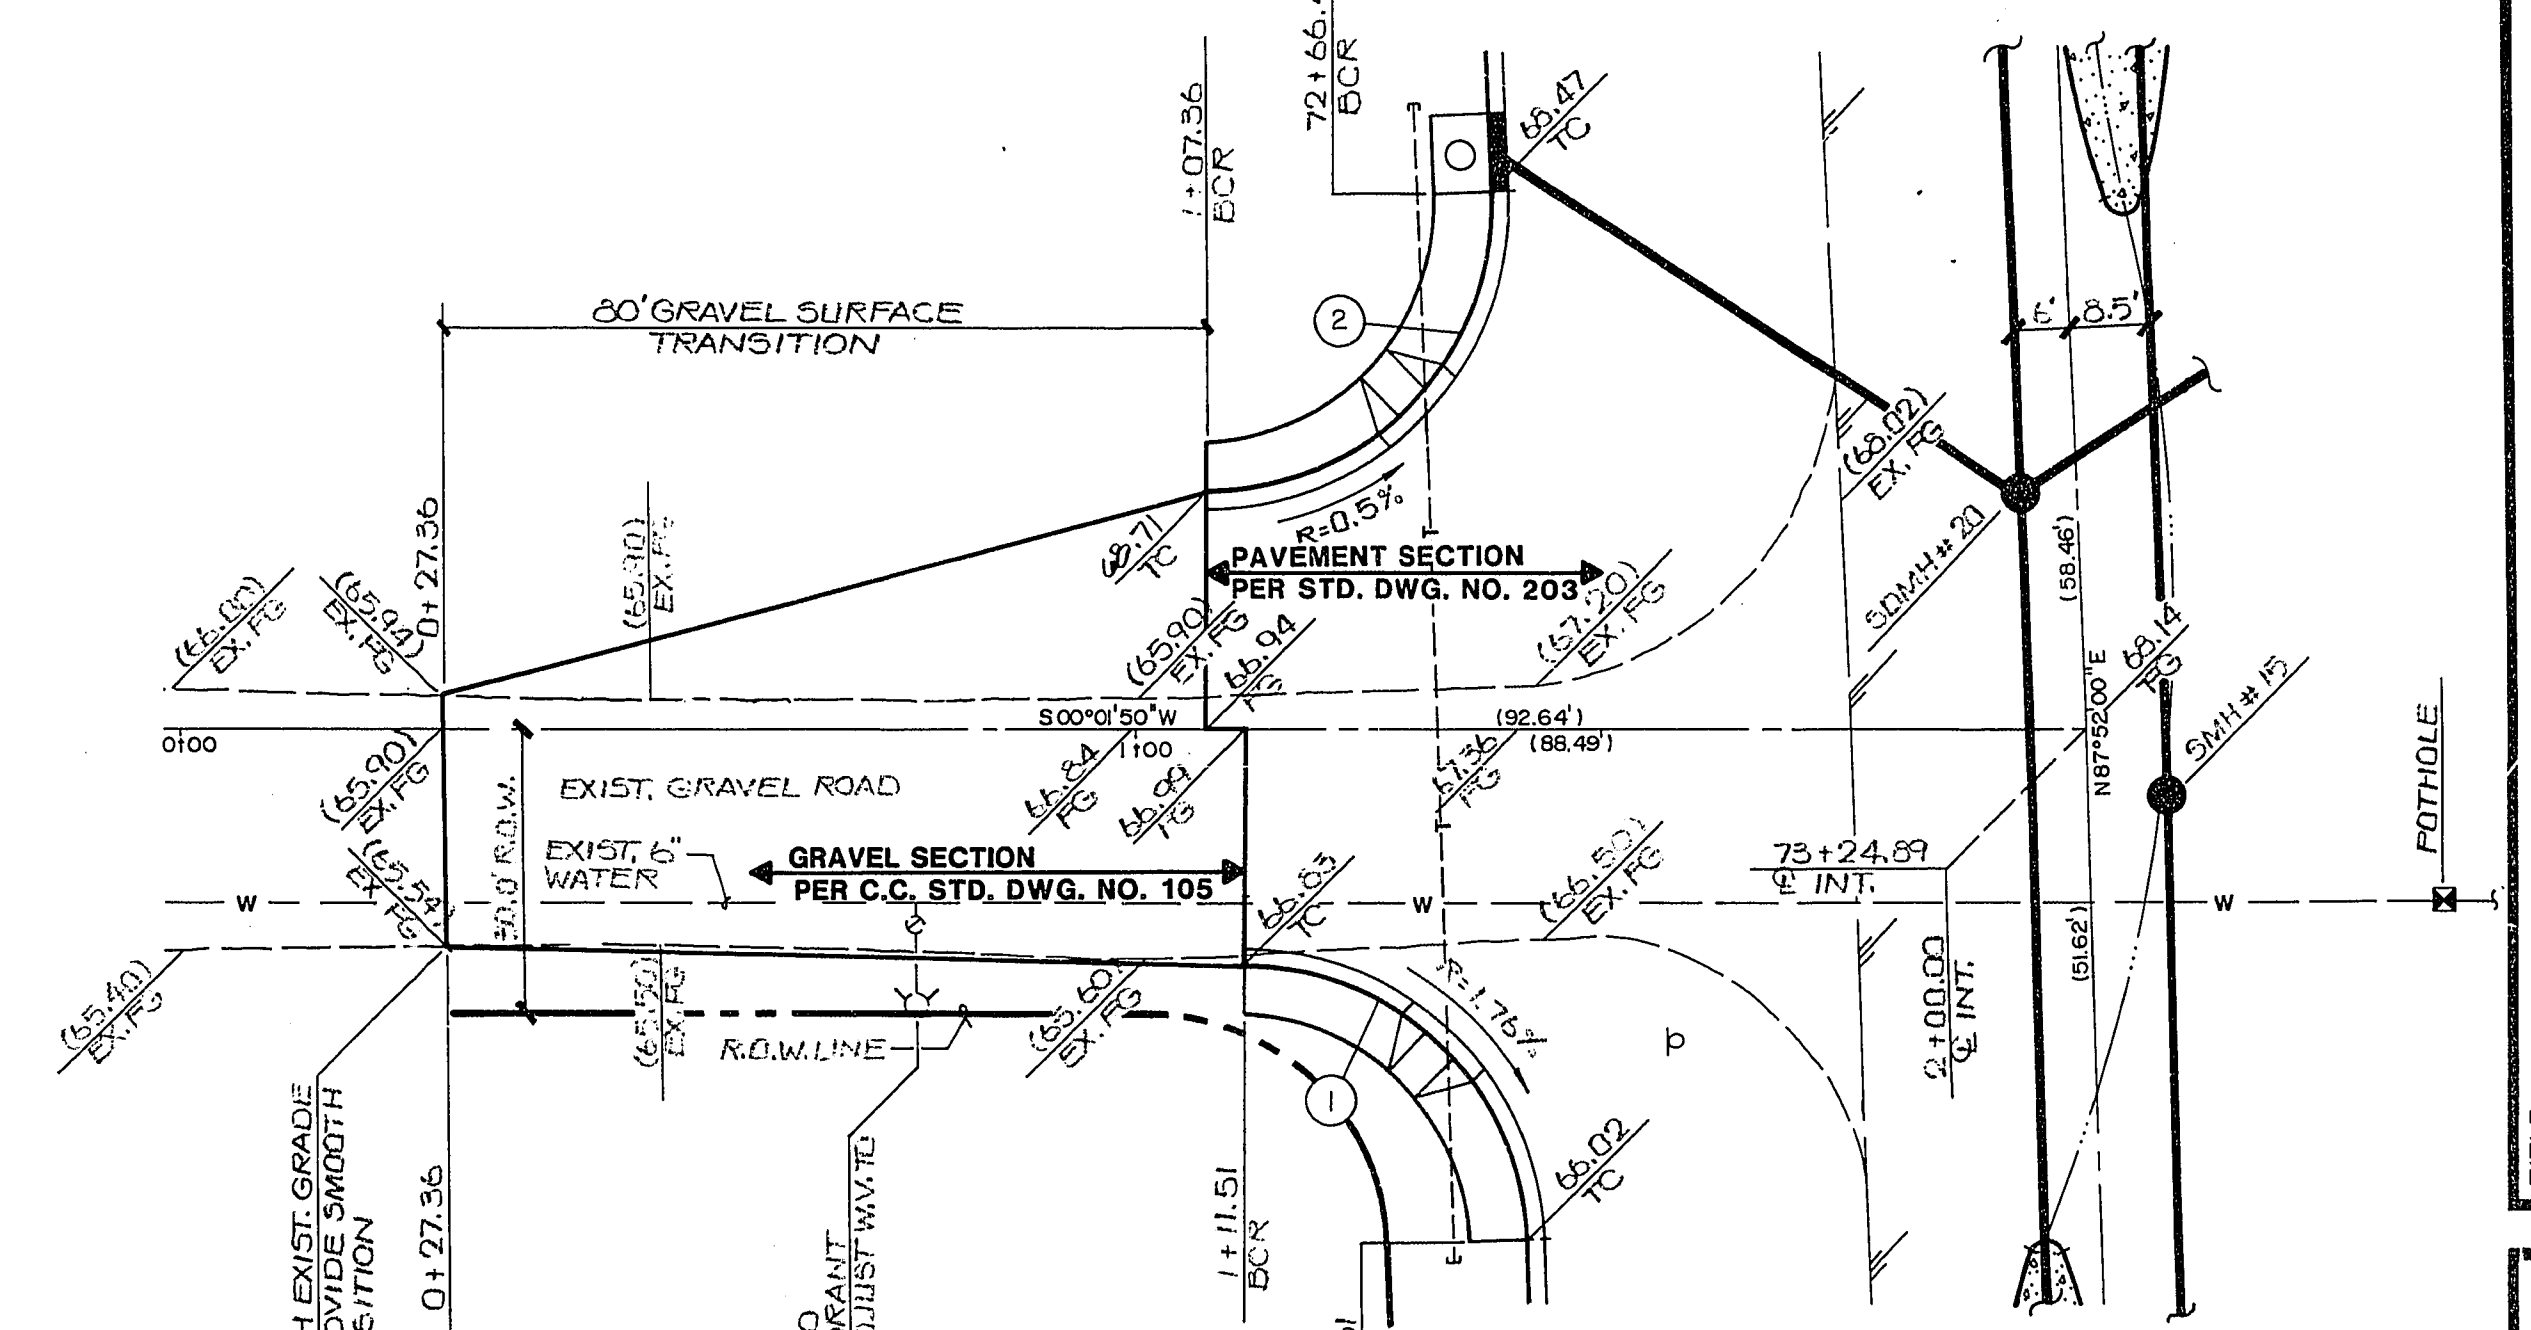

MONTE CRISTO WAY

INTERSECTION PLAN & PROFILE
(TIOGA WAY & MONTE CRISTO WAY)
PROJECT
S.I.D. 1427 - SAHARA AVENUE
(DURANGO DRIVE TO RAINBOW BOULEVARD)

WO NO. 130 - 9520
BY BLOOM
DATE 9/91
SCALE VERT.: 1"=4'
HORIZ.: 1"=20'

CLV. DRAWING NO. 26
107-V-2036 43

0.1 603
"As Built" 107-V2036