



5-2-72

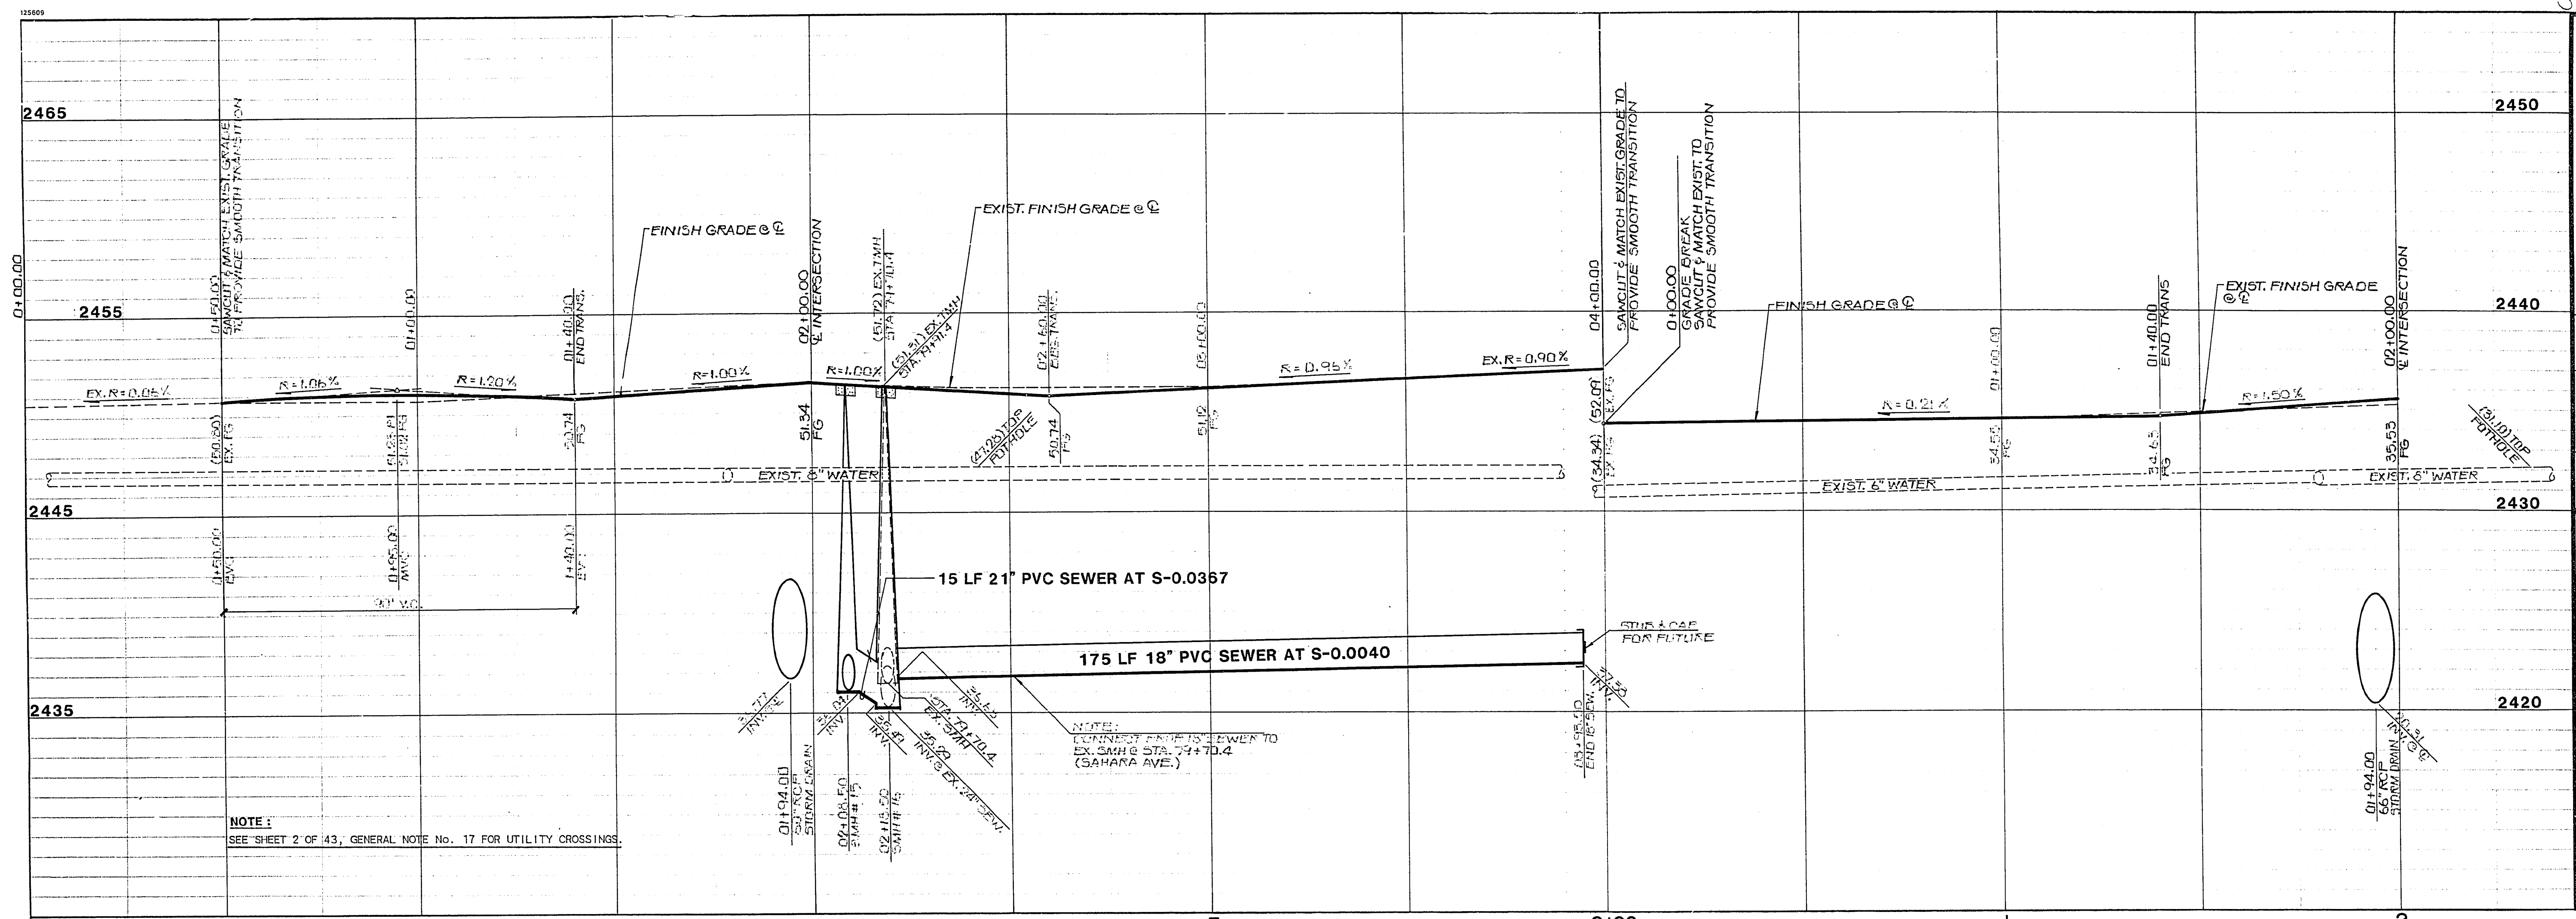

NOTE:
SEE SHEET 2 OF 43, GENERAL NOTE NO. 17 FOR UTILITY CROSSINGS.

ENGINEERS & ARCHITECTS INC.
1018 W. CHANDLER AVENUE, SUITE 100, CHANDLER, AZ 85224
PH: 480-948-7000
FAX: 480-948-7001
SUBMITTED BY: [Signature]
DATE: 6/23/92

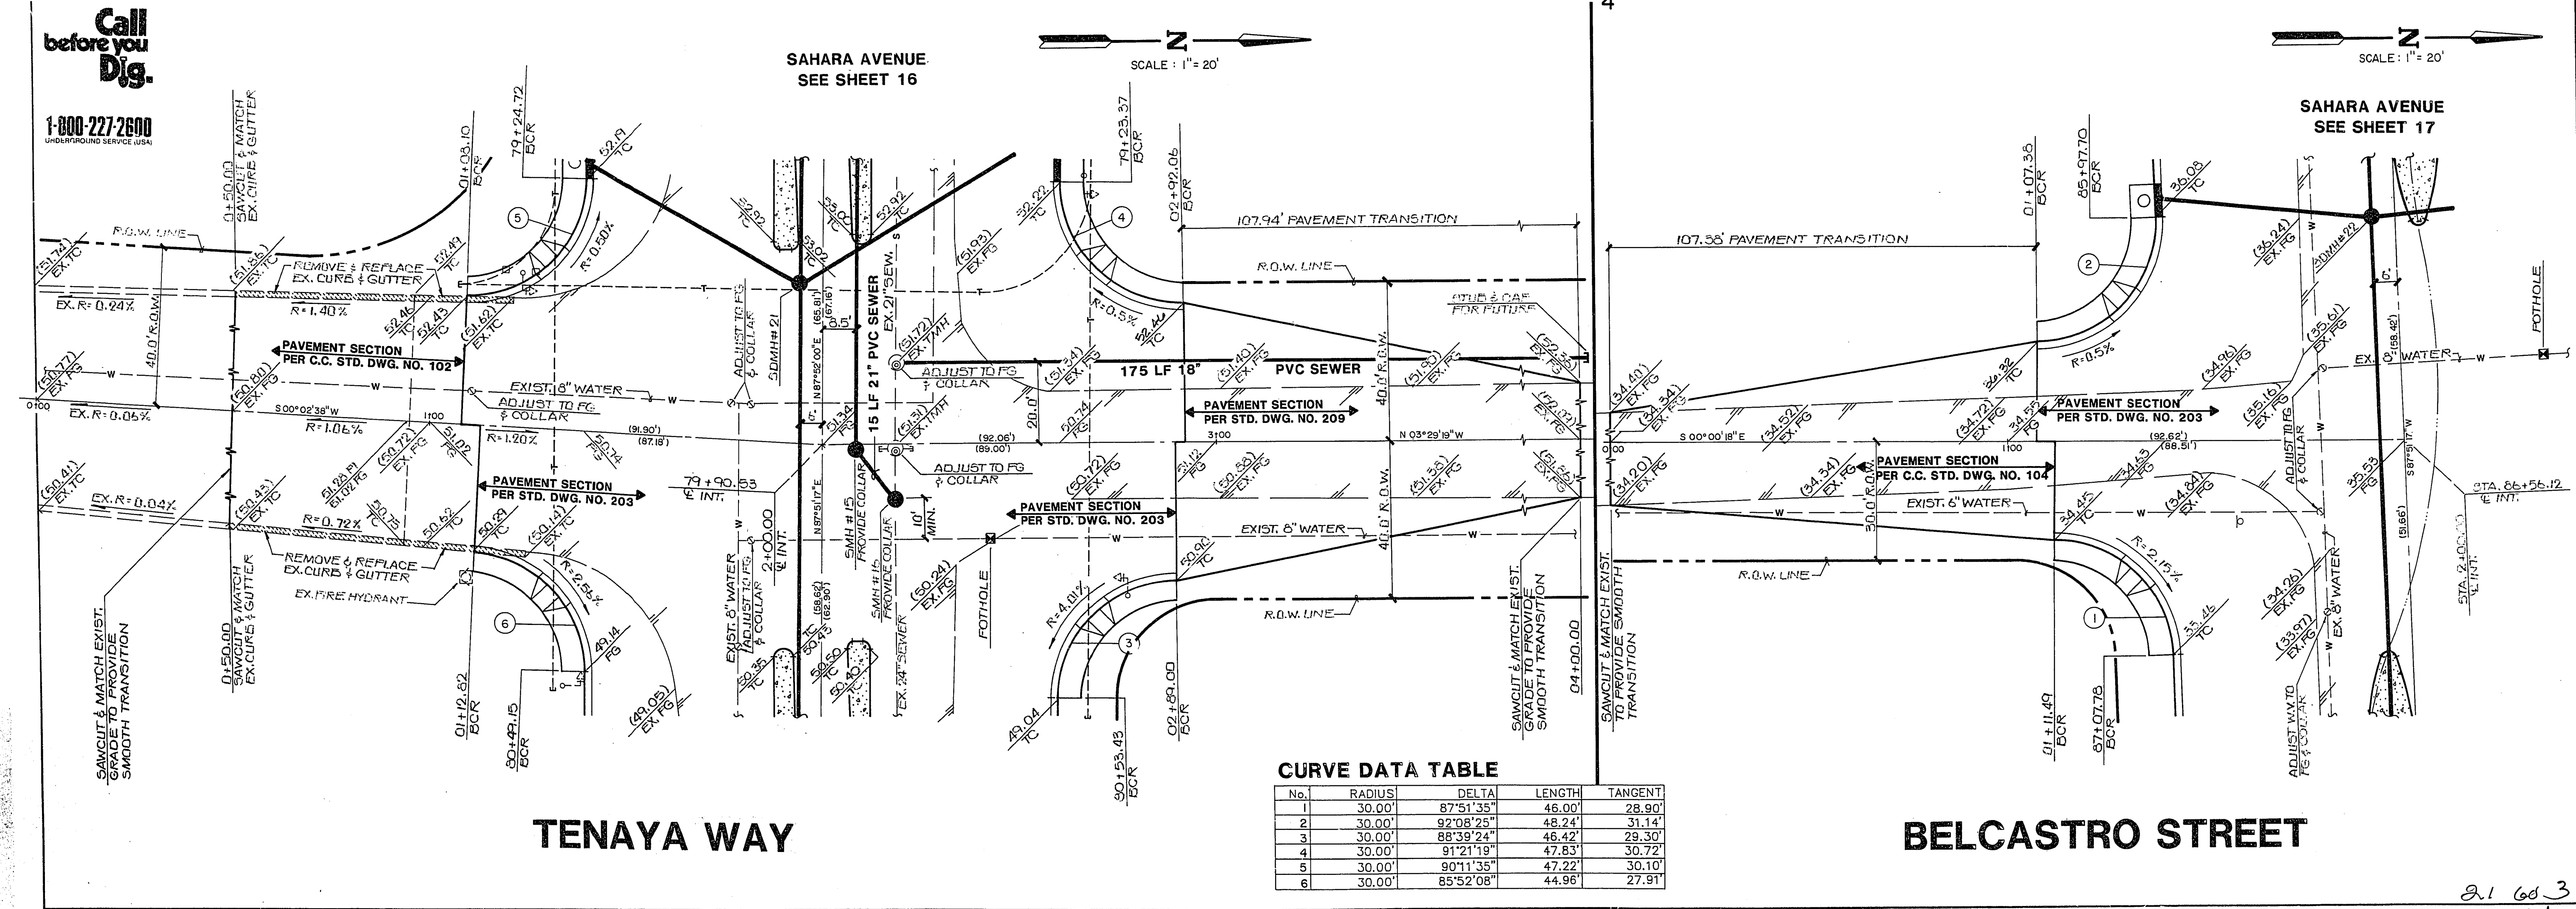

CURVE DATA TABLE

No.	RADIUS	DELTA	LENGTH	TANGENT
1	30.00'	87°51'35"	46.00'	28.90'
2	30.00'	92°08'25"	48.24'	31.14'
3	30.00'	88°39'24"	46.42'	29.30'
4	30.00'	91°21'19"	47.83'	30.72'
5	30.00'	90°11'35"	47.22'	30.10'
6	30.00'	85°52'08"	44.96'	27.91'

Call before you Dig.
1-800-227-2600
UNDERGROUND SERVICE USA

INTERSECTION PLAN & PROFILE
(TENAYA WAY & BELCASTRO STREET)
S.I.D. 1427 - SAHARA AVENUE
(DURANGO DRIVE TO RAINBOW BOULEVARD)

WO NO. 130-9520
BY BLOOM
DATE 9/91
SCALE VERT. 1"=4'
HORIZ. 1"=20'

CL.V. DRAWING NO. 27
107-V-2036 43

2.1 60.3
"As Built" 107-V2036