



REV	DATE	BY	REVISION

**Call before you Dig.**  
 1-800-227-2600  
 UNDERGROUND SERVICES, USA

NOTE:  
 SEE SHEET 2 OF 43, GENERAL NOTE No. 17 FOR UTILITY CROSSINGS.

NOTE:  
 ALL FINISH GRADES OF AC PAVEMENT SHALL BE FLUSH WITH LIP OF GUTTER. ADJUST EXISTING AND PROPOSED MANHOLES IN THE PAVEMENT AREA ACCORDINGLY.

ES ENGINEERS & ARCHITECTS INC.  
 7018 W. GARDEN AVENUE, SUITE 100, DENVER, CO 80202  
 REGISTERED PROFESSIONAL ENGINEER  
 STATE OF COLORADO  
 NO. 10001303-00415  
 ZEHARI  
 SUBMITTED BY: [Signature]  
 6/23/92

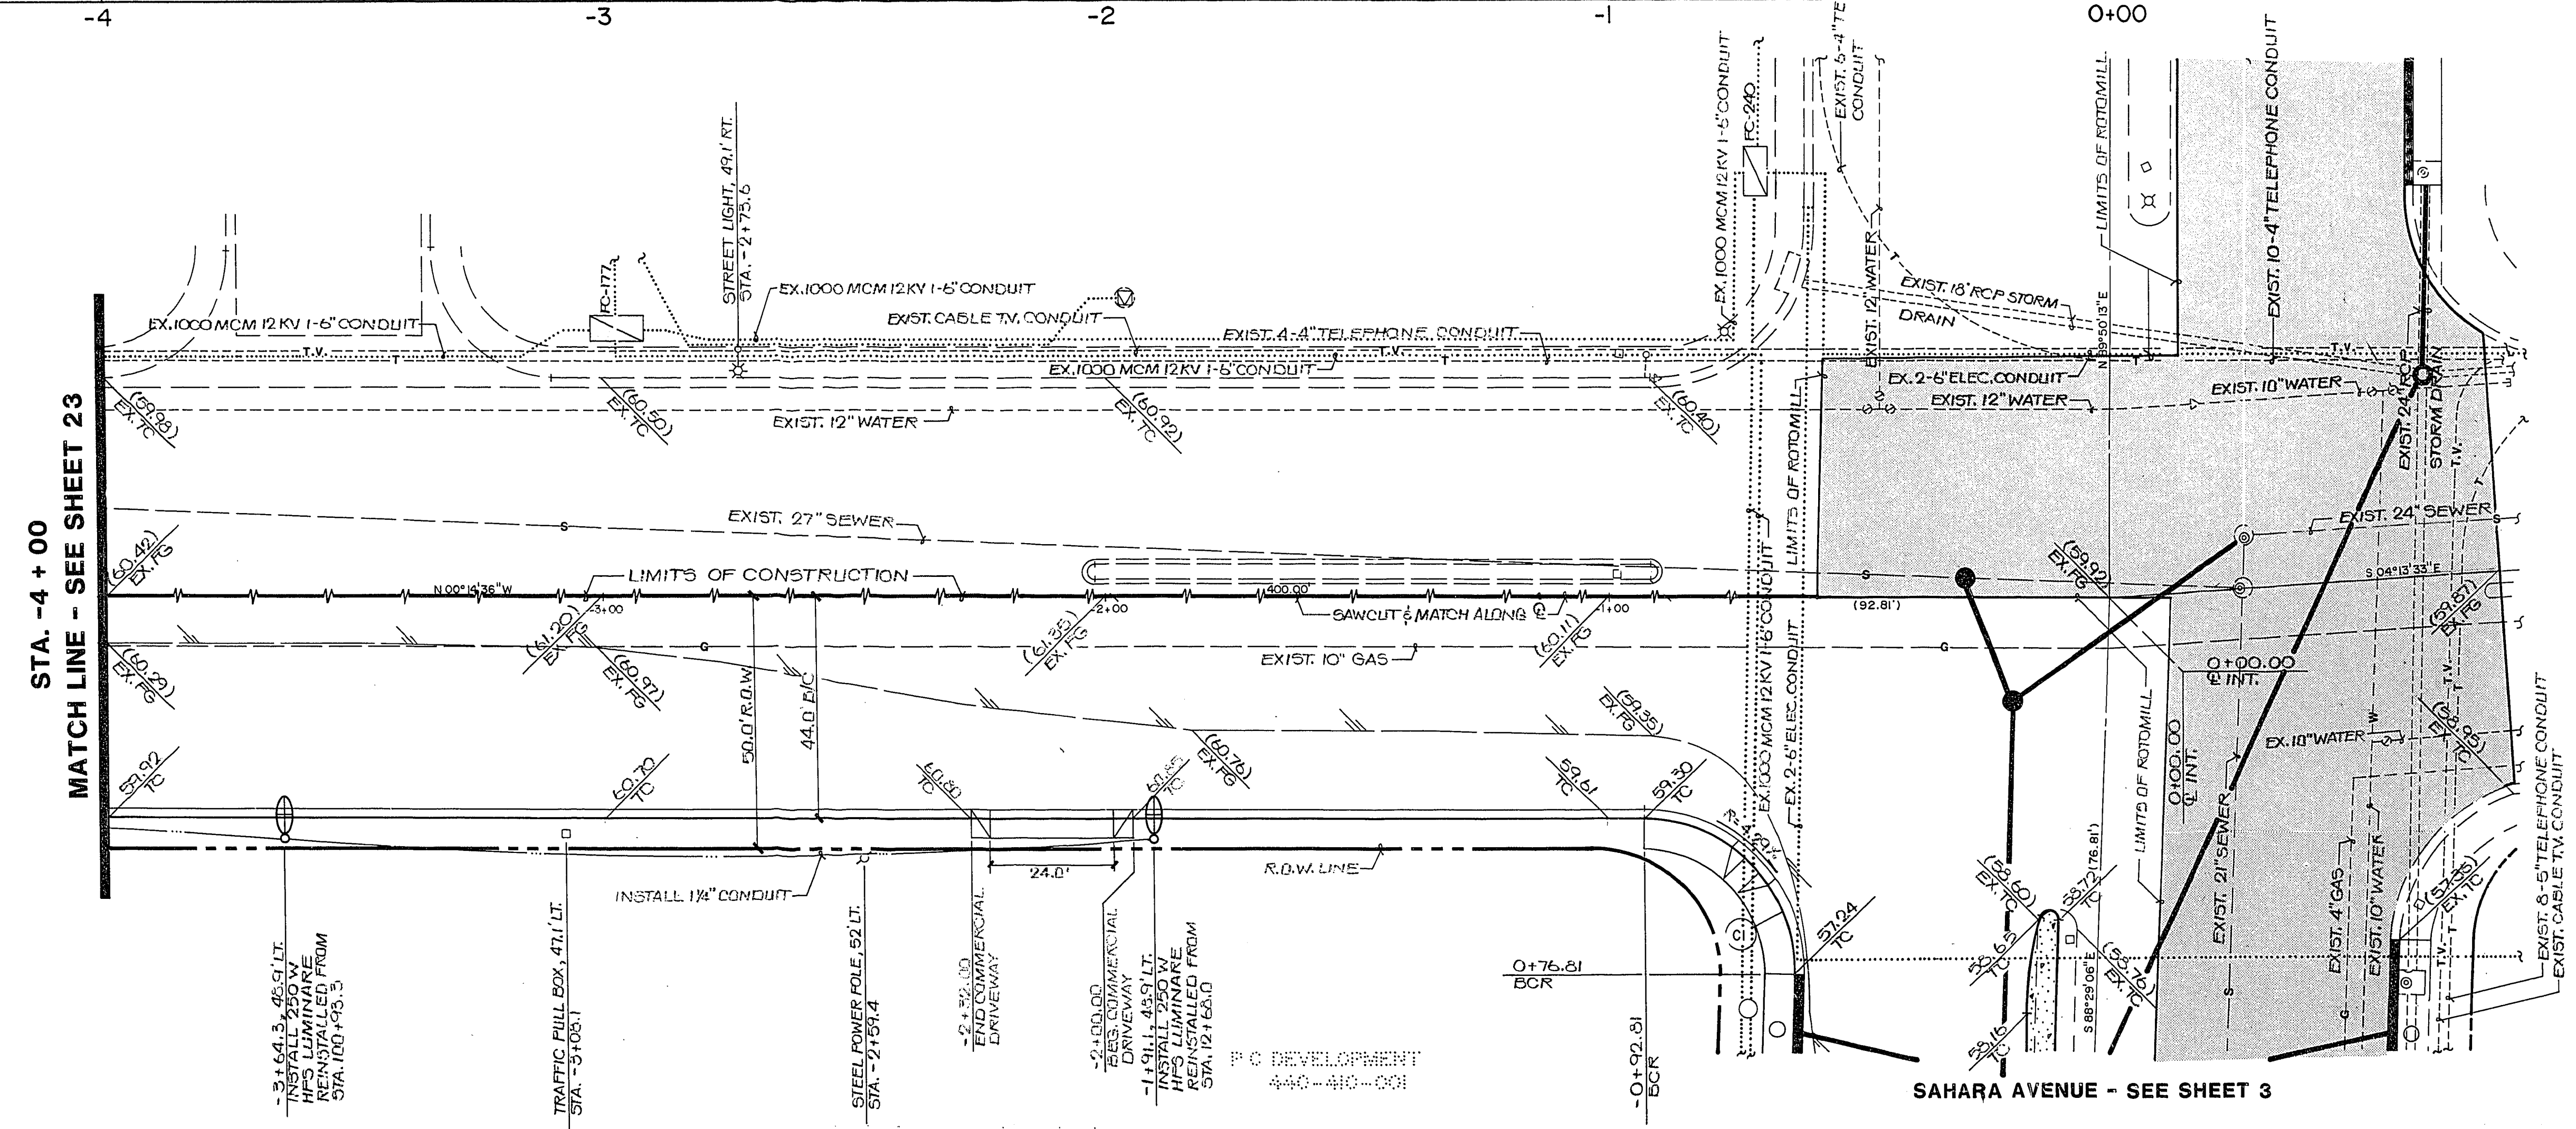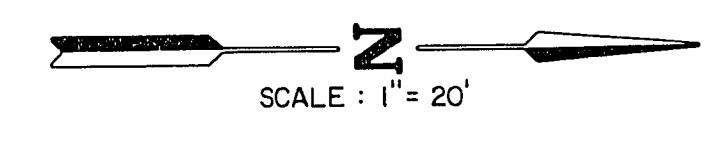

**CURVE DATA TABLE**

No.	RADIUS	DELTA	LENGTH	TANGENT
CI	30.00'	91°45'30"	48.04'	30.94'

**STREET PLAN & PROFILE**  
 S.I.D. 1427 - SAHARA AVENUE  
 ( DURANGO DRIVE )

WO NO. 130 - 9520  
 BY BLOOM  
 DATE 7/91  
 SCALE VERT. 1" = 4'  
 HORIZ. 1" = 20'

CL.V. DRAWING NO. 22  
 107-V-2036 43

**DURANGO DRIVE**

21 60 3  
 "As Built" 107-V2036