
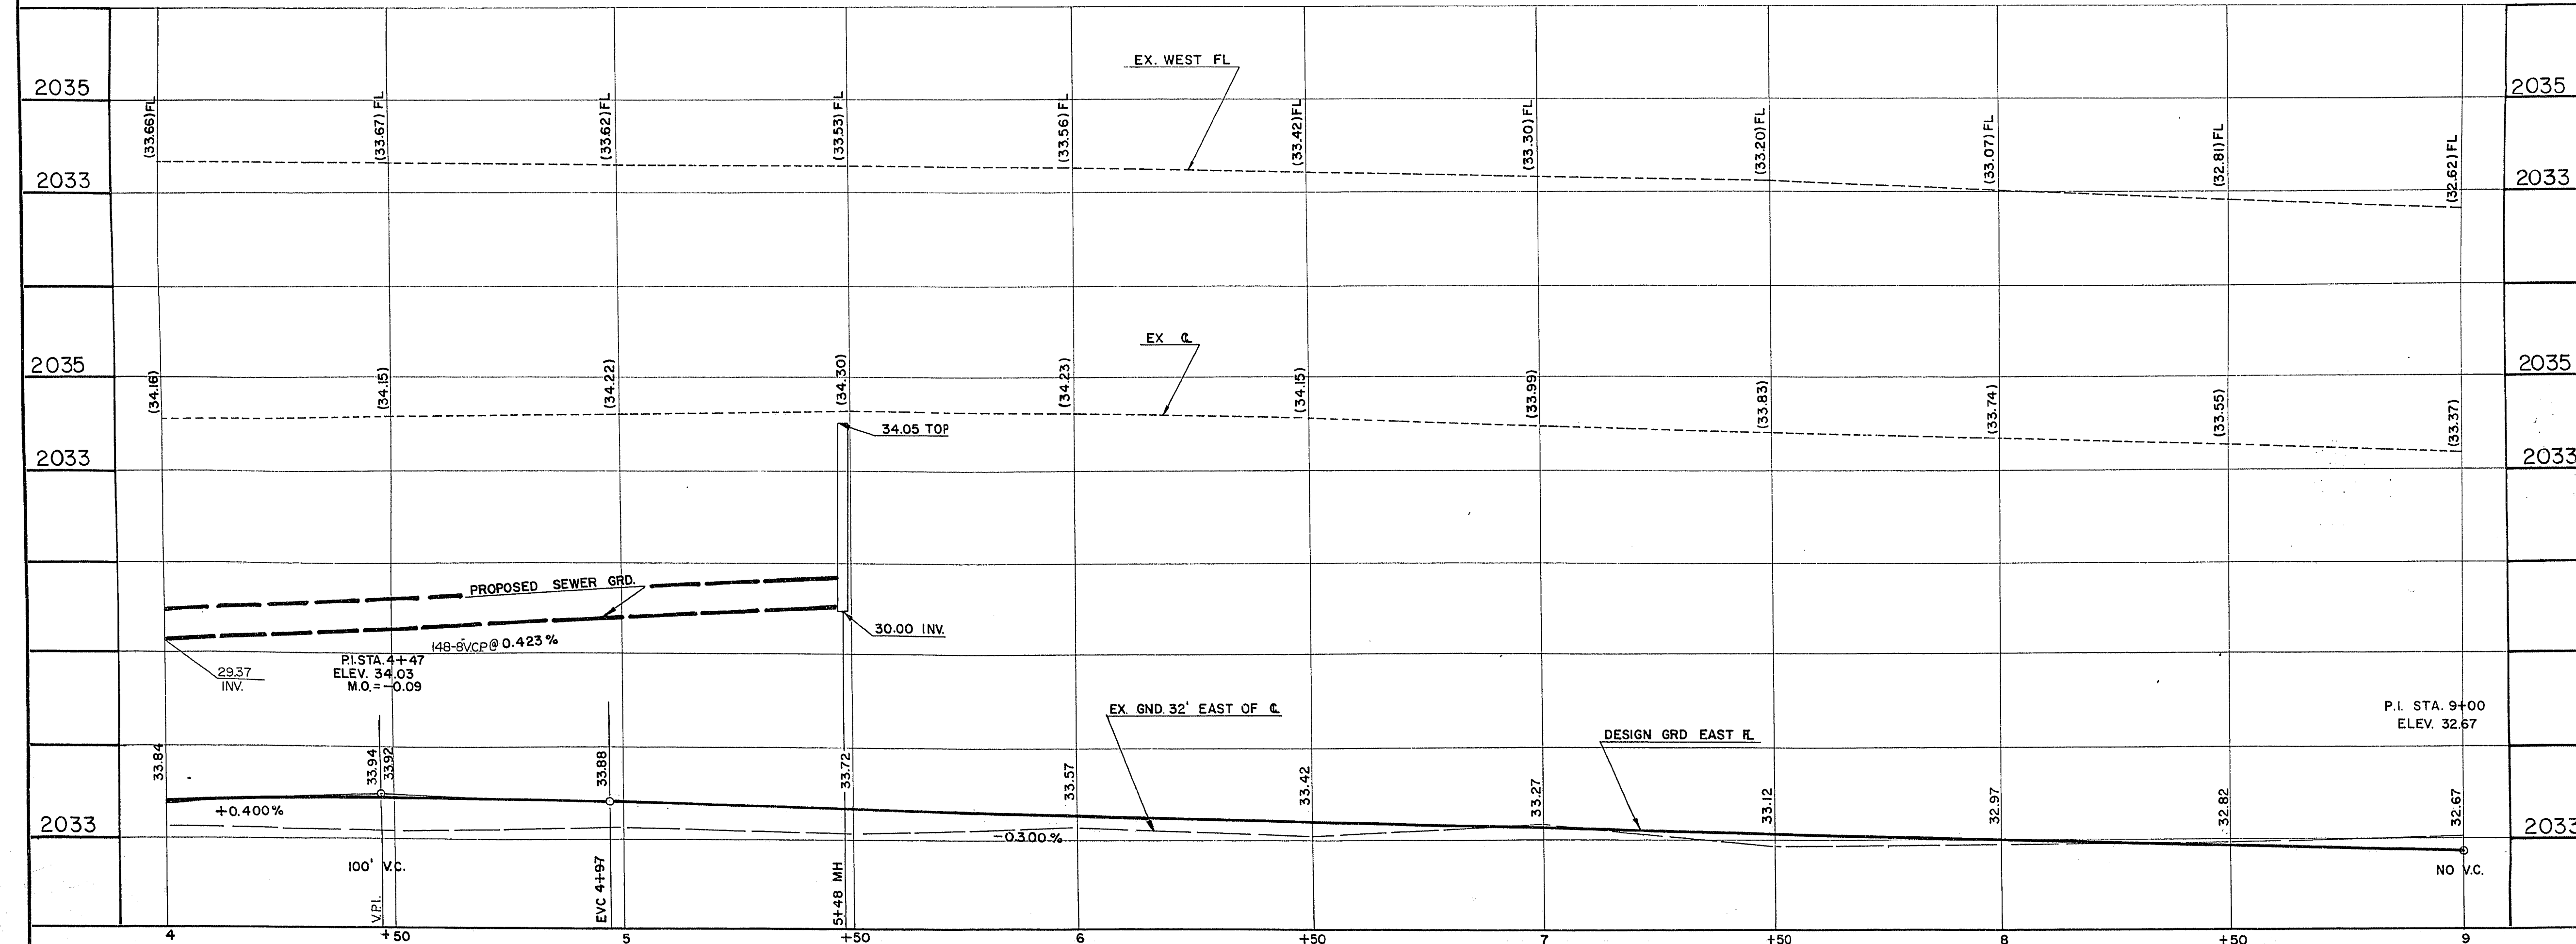


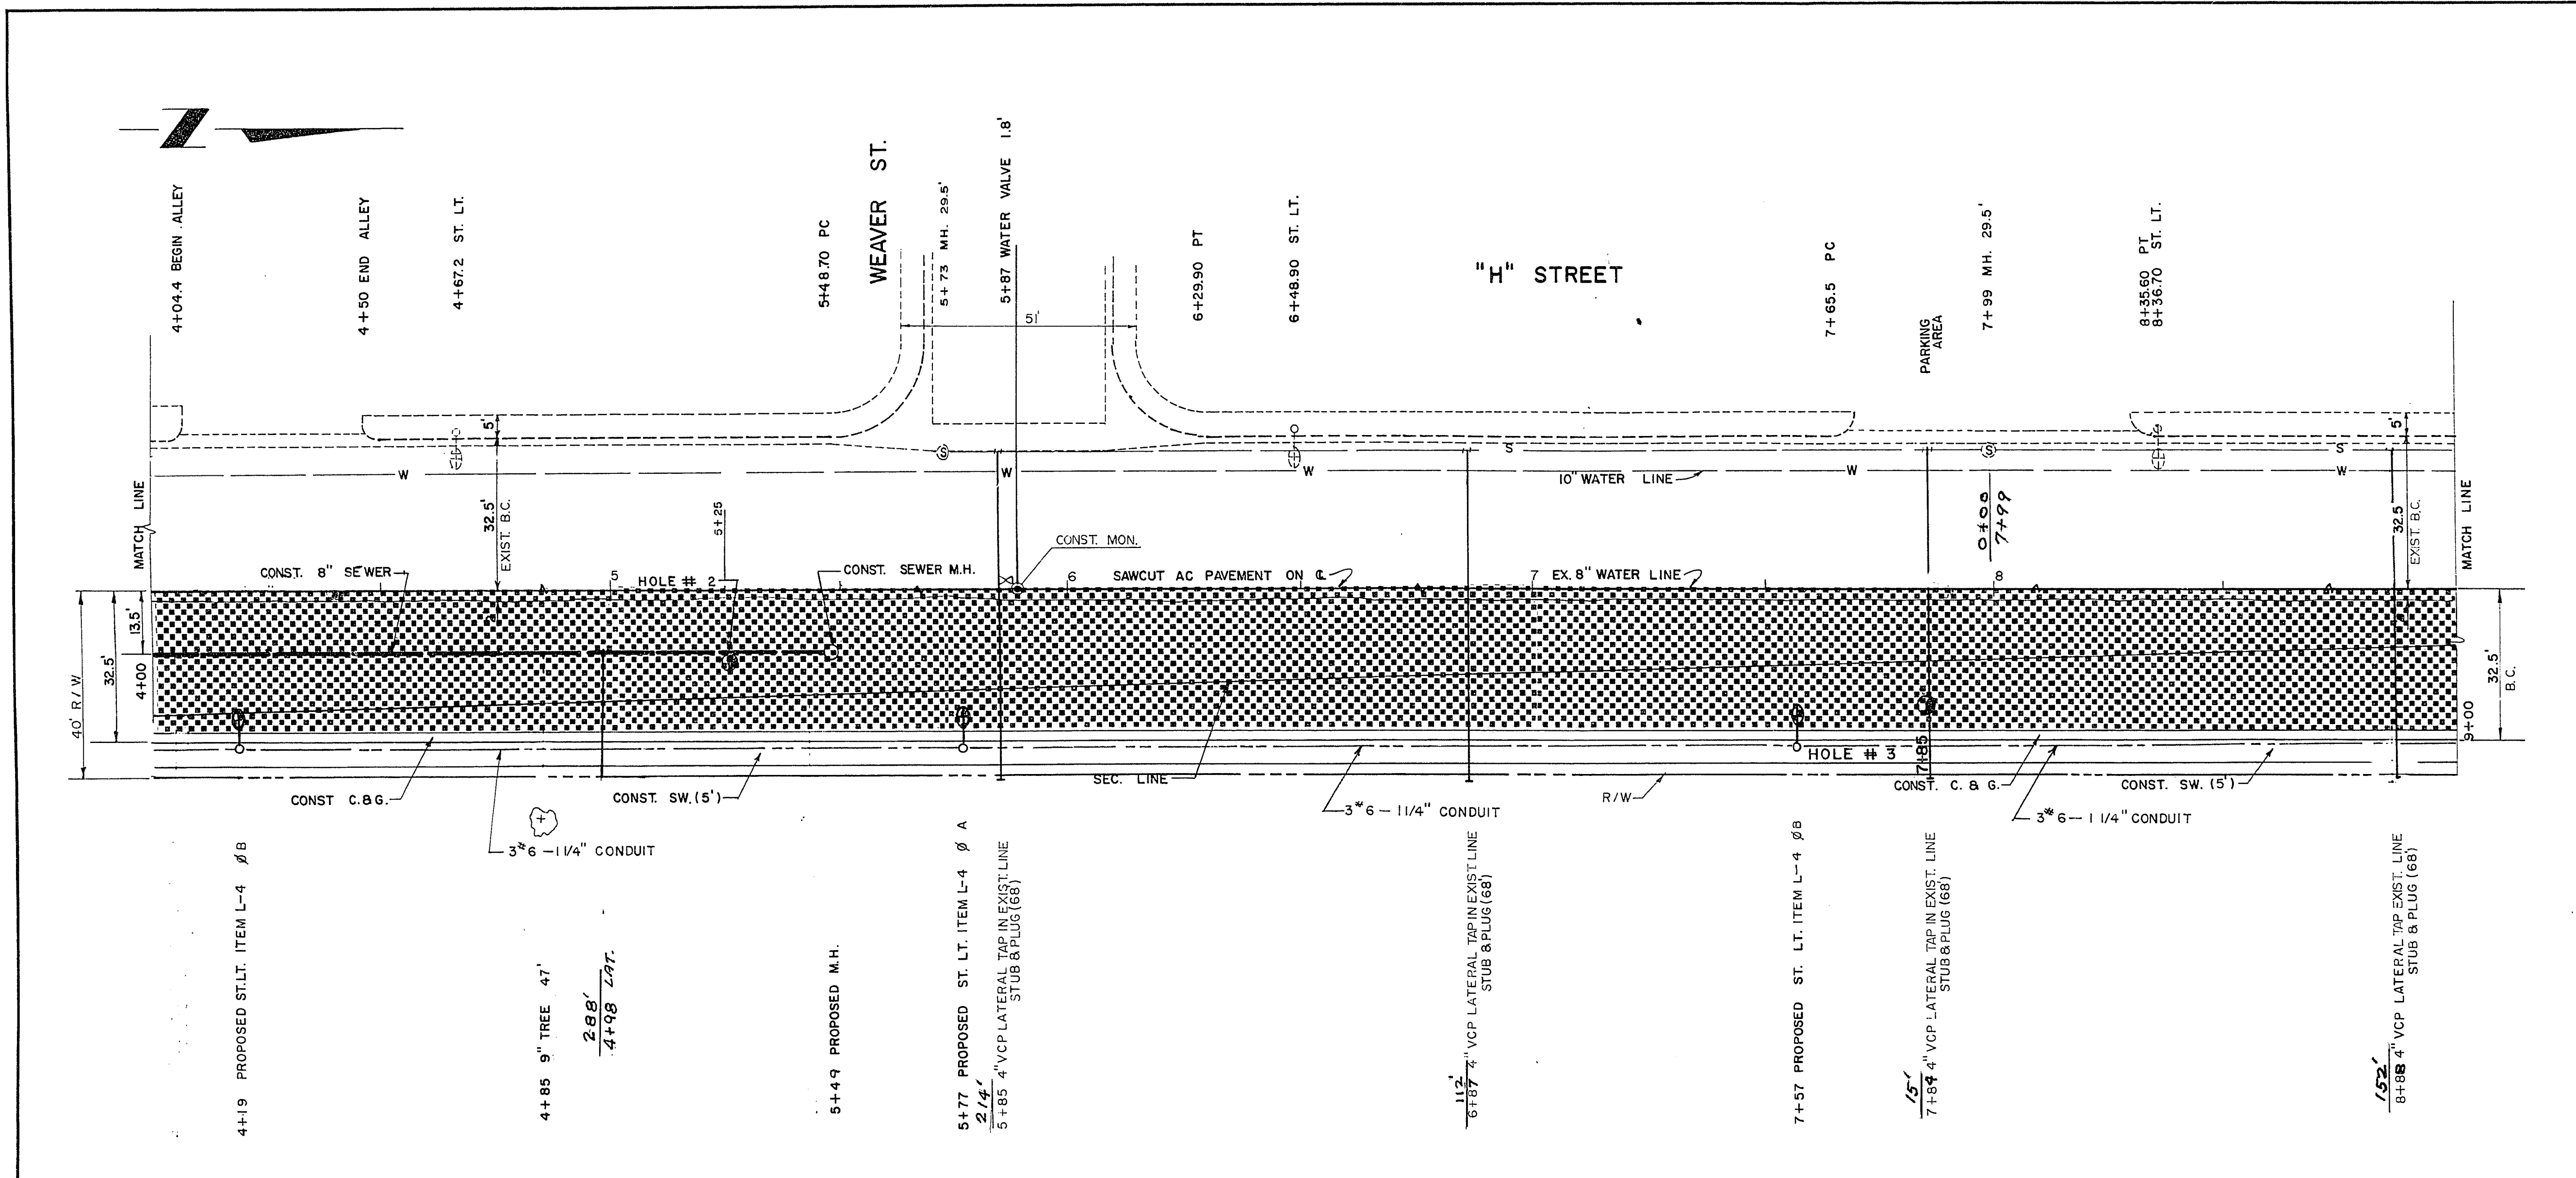

APPROXIMATE QUANTITIES - THIS SHEET		
ITEM	DESCRIPTION	QUANTITY
201.1	ROADWAY EXCAVATION	CU. YD. 570
334.6	CONSTRUCT 3" A.C. PAVEMENT	SQ. YD. 1694
302.1	CONSTRUCT TYPE I BASE	CU. YD. 463
302.2	CONSTRUCT TYPE II BASE	CU. YD. 227
340.1	CONSTRUCT L TYPE C & G 24"	LIN. FT. 500
340.3	CONSTRUCT 4" CONC. SW 5' WALK	SQ. FT. 2500
333.1	BIT. FOG SEAL	SQ. YD. 1694
123.208	8" V.C.P.	LIN. FT. 148
512.1	SAN. SEWER MANHOLE	EACH 1
123.204	4" V.C.P. (TO NEW MAIN)	LIN. FT. 25
123.204	4" V.C.P. (TO EXIST. MAIN)	LIN. FT. 272
420.0	CONST. SURVEY MONUMENT	EACH 1

STREET LIGHTS SAD 4794		
ITEM	DESCRIPTION	QUANTITY
L-1	24" TRENCHING	500'
L-2	11/4" CONDUIT - INSTALLED 24" MIN. COVER	515'
L-4	11 GA STANDARD PER STD. DWG. 400.1 WITH 400WATT LOW VOLTAGE MERCURY VAPOR LUMINARE ON 48" FOUNDATION COMPLETE INSTALLED & WIRED INCLUDING CONDUIT WIRING.	3

EXISTING UTILITIES ARE LOCATED ON THE PLANS FOR THE CONVENIENCE OF THE CONTRACTOR ONLY. THE CONTRACTOR SHALL BEAR FULL RESPONSIBILITY FOR PROTECTION OF UTILITIES AND THE CITY BEARS NO RESPONSIBILITY FOR UTILITIES NOT SHOWN ON THE PLANS OR NOT IN THE LOCATION SHOWN ON THE PLANS.

BENCH MARK BASIS: U.S.C. & G. MONUMENT "COLORED" AT THE S.E. CORNER OF "H" & OWENS. ELEVATION 2032.59.

CONTRACT NO. 4794
DATE 27 1968

CONTRACT DRAWING
FEB 3 1969

REVISION NO.	DESCRIPTION	BY	DATE	APPROVAL

REVISIONS

CITY OF LAS VEGAS NEVADA
DEPARTMENT OF PUBLIC WORKS
SERVICES DIVISION
S.D. 479 UNIT IV
H STREET
OWENS TO DOOLITTLE

W.O. NO. 4794	F.B.K. NO. 67-1X	DATE	DRAWING NO.
SC. (H) 1"=20'	SC. (V) 1"=2'	4-24-68	107V-560
DES. W.L.J.	DR. L. KOCH	4-24-68	FILE NO.
APPROVED BY DIRECTOR OF PUBLIC WORKS			

[Signature]

SHEET 38 OF 45