

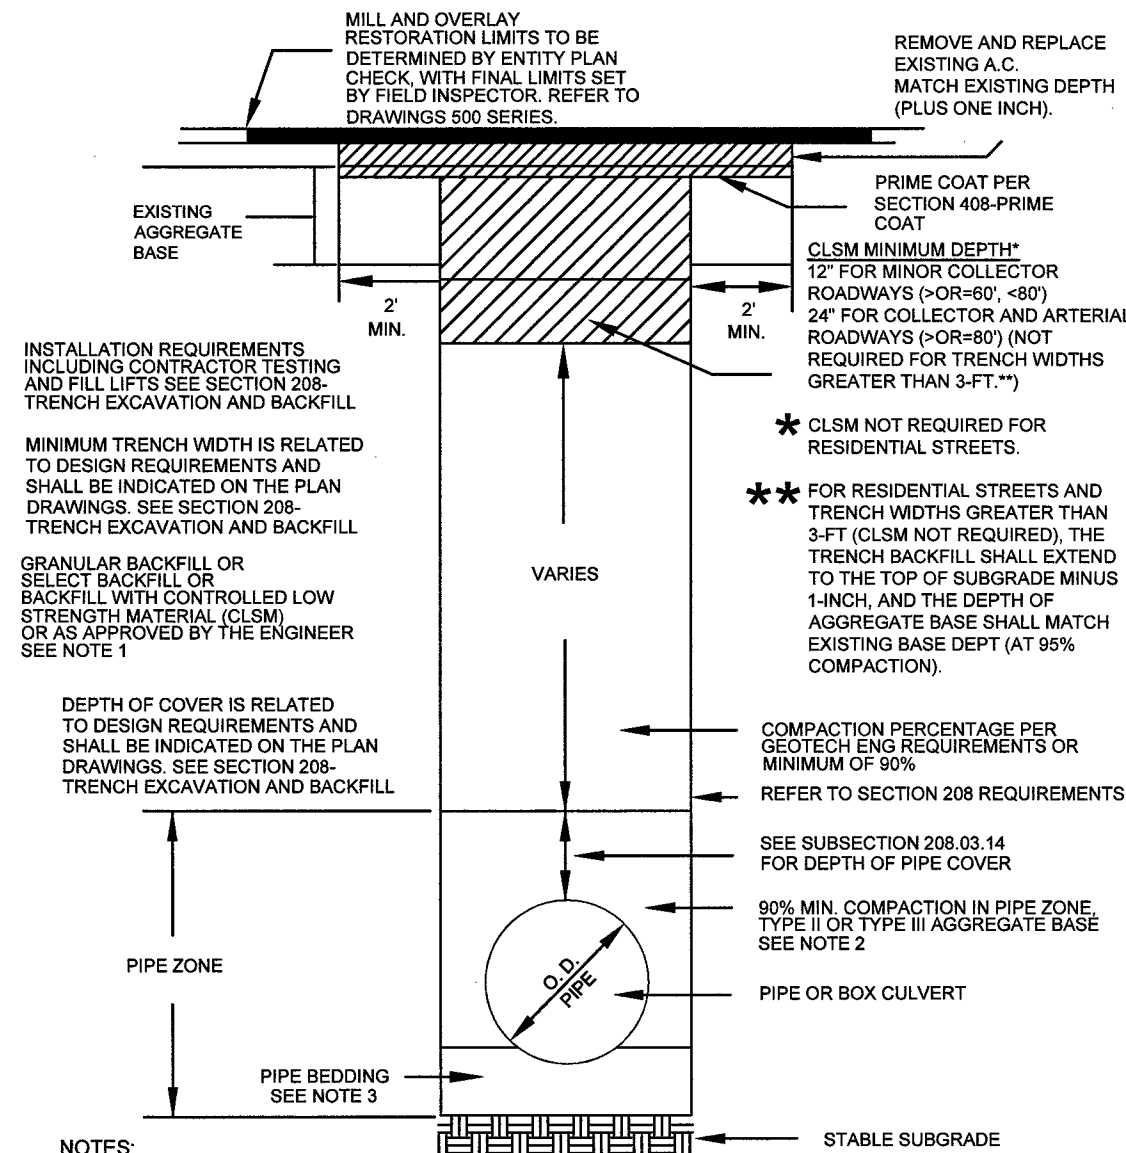


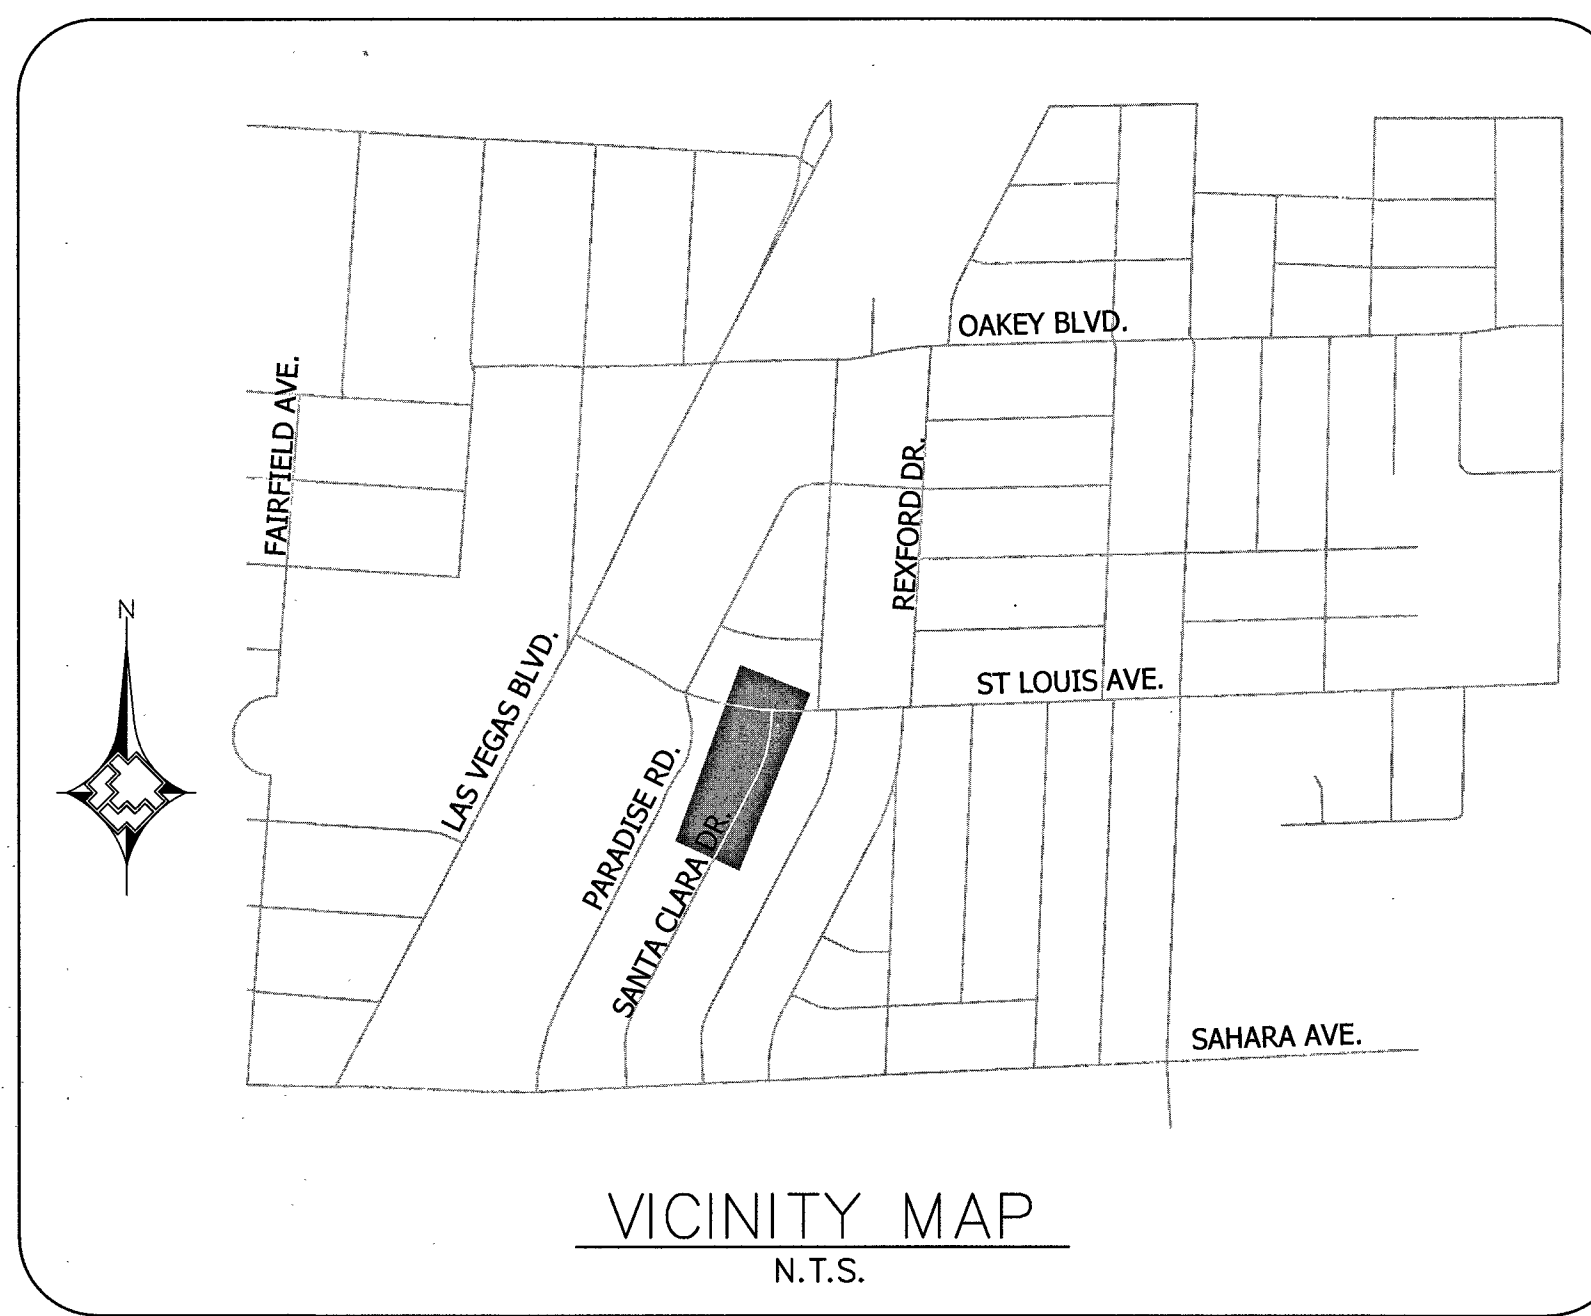

RTC STD DWG 503

MATCHLINE - SEE SHEET 4
FOR CONTINUATION

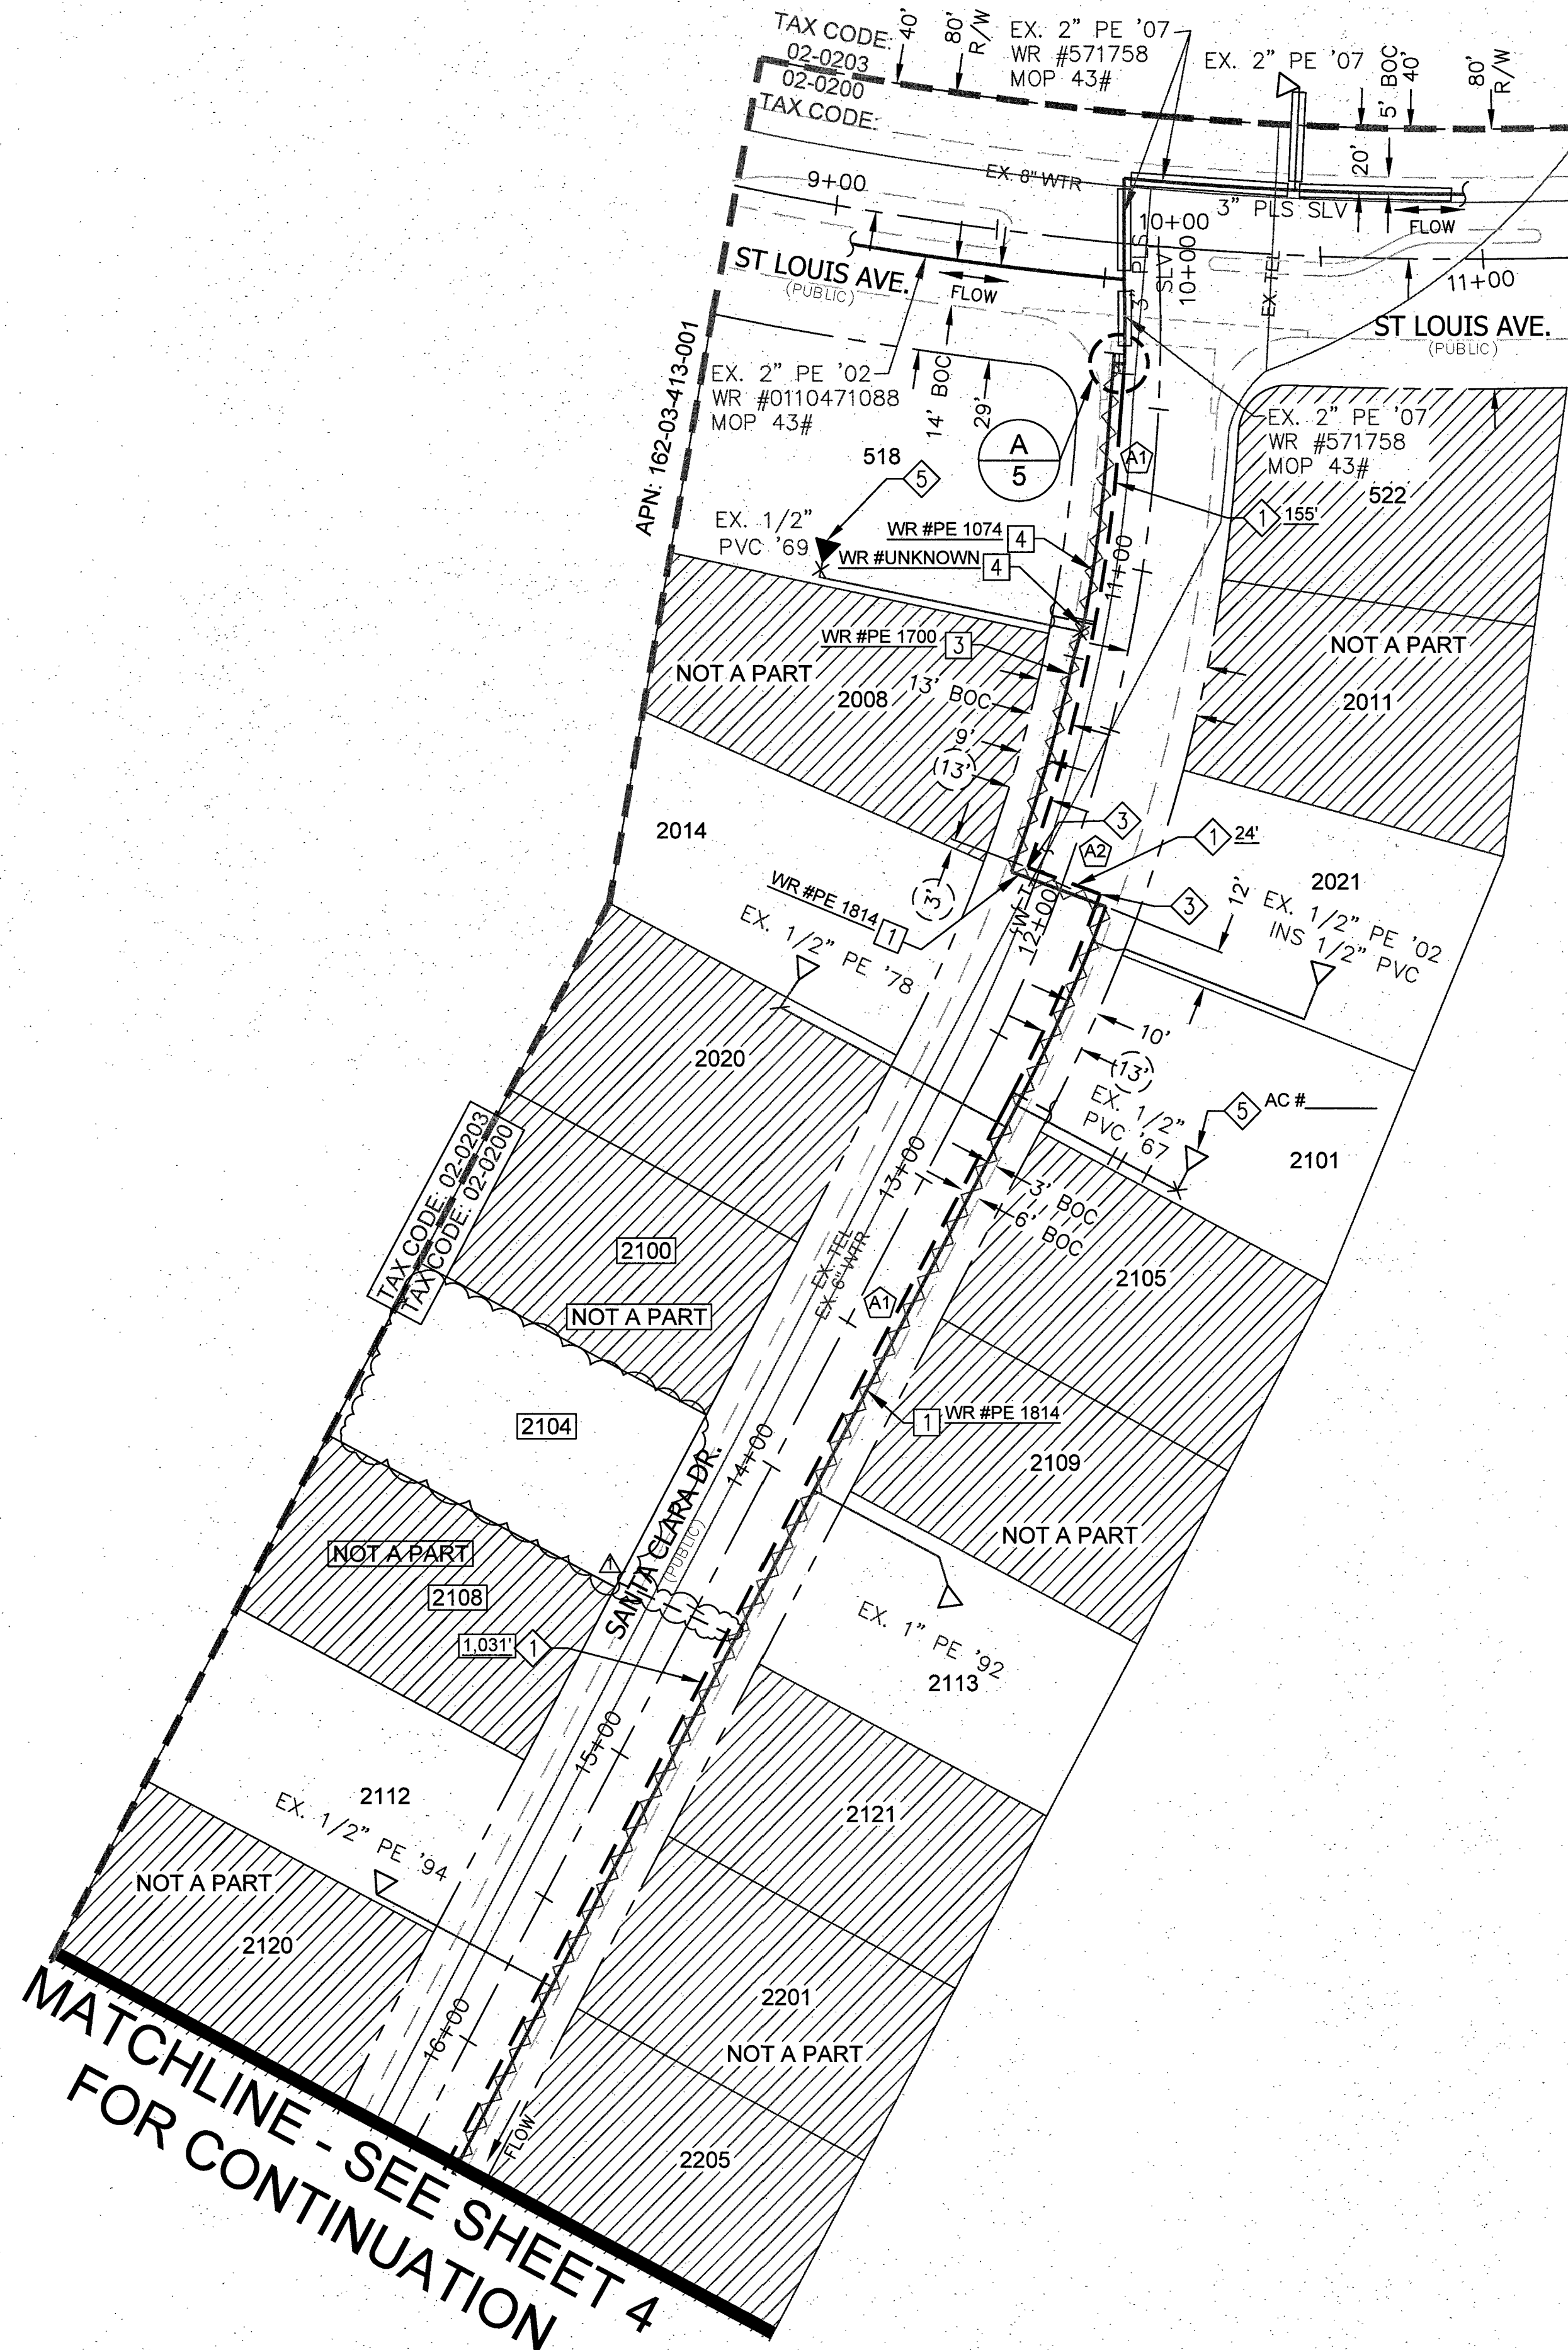

PROPOSED FACILITIES:

- 1 PROP. 2" PE MAIN (100-5101)
- 3 PROP. 2" PE 90° ELBOW (140-3067)
- 5 EXISTING RISER TO BE REPLACED. SEE INDIVIDUAL AC

ABANDONED FACILITIES:

- 1 ABANDON 2" PVC '67 MOP 43#
- 3 ABANDON 2" PVC '66 MOP 43#
- 4 ABANDON 2" PVC '64 MOP 43#

LEGEND:


	EXISTING GAS LINE
	GAS LINE TO BE ABANDONED
	EXISTING GAS SERVICE
	PROPOSED MAIN GAS LINE (NEW)
	PROPOSED SERVICE LATERAL (NEW)
	PROPOSED SERVICE LINE (NEW)
	RIGHT OF WAY LINE
	STREET CENTERLINE
	PROPERTY LINE
	BACK OF CURB
	MATCHLINE
	EASEMENT
	EXISTING ANODELESS RISER
	EXISTING ANODE RISER
	EXISTING GAS LIGHT
	EXISTING GAS VALVE

RTC NOTES:

PAVEMENT REPAIR SHALL CONFORM TO RTC STANDARD(S):
A1 500.4
A2 500.5



1.	Added Service for 2104 Santa Clara Dr		DJF	4/12/16	24
2.					
3.					
4.					
NO.	DESCRIPTION	BY	DATE	APPVD.	
REVISIONS					

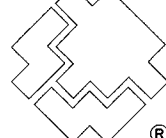SOUTHWEST GAS CORPORATION

TAX CODES	UNIT NO.	UNIT TYPE	INSTL. PROPOSED	RETIRED COMPLETED
PROPERTY UNITS				

AS-BUILT DRAWING-PRESSURE TEST DATA			
PIPE DIA.	TEST MEDIUM	TEST METHOD	
PIPE LENGTH	☐ AIR	☐ GAUGE	
PIPE TYPE	☐ NITROGEN	☐ CHART	
MIN. DURATION	☐ WATER	☐ GAUGE/ PRESS REC SN#	
TEST PRES. (PSIG)	START	END	
TIME			
DATE			
PERFORMED BY			

VISUAL INSPECTION CERTIFICATION	
I HAVE VISUALLY INSPECTED ALL HEATED FUSIONS, SOLVENT CEMENT, MECHANICAL JOINTS, AND WELDS THAT I HAVE PERFORMED	
NAME	DATE
SEE SHEET 2	
AS-BUILTS ACCEPTED BY	DATE
POSTED BY	DATE
POSTING QC'D BY	DATE

CONSTRUCTION	
INSPECTOR	DATE
FOREMAN	DATE
REVIEWED BY	DATE
SEE SHEET 2	
PERMIT INFORMATION	
CITY OF LAS VEGAS	
TAX CODE 02-0200	

ISOLATION AREA	W.R. NO.
ISO_21_DIST_096	1994608
LOCATION	ATLAS #/TILE #
T21S R61E SEC 3 M.D.M.	x627y508 x627y506 x624y506

ENGINEER/TECH: MARIA RUSHING		PHONE: 702-365-2008
ACCOUNT REP:		PHONE:
PROJECT CONTACT: MARIA RUSHING		PHONE: 702-365-2008
SHEET NO: 3 OF 5	SCALE: 1" = 40'	DATE: 4/12/16
DWN. BY: ZONE ENG	CHKD. BY:	APPVD. BY:
TITLE		
F-CLV 2015 SS-SANTA CLARA & SAHARA		