
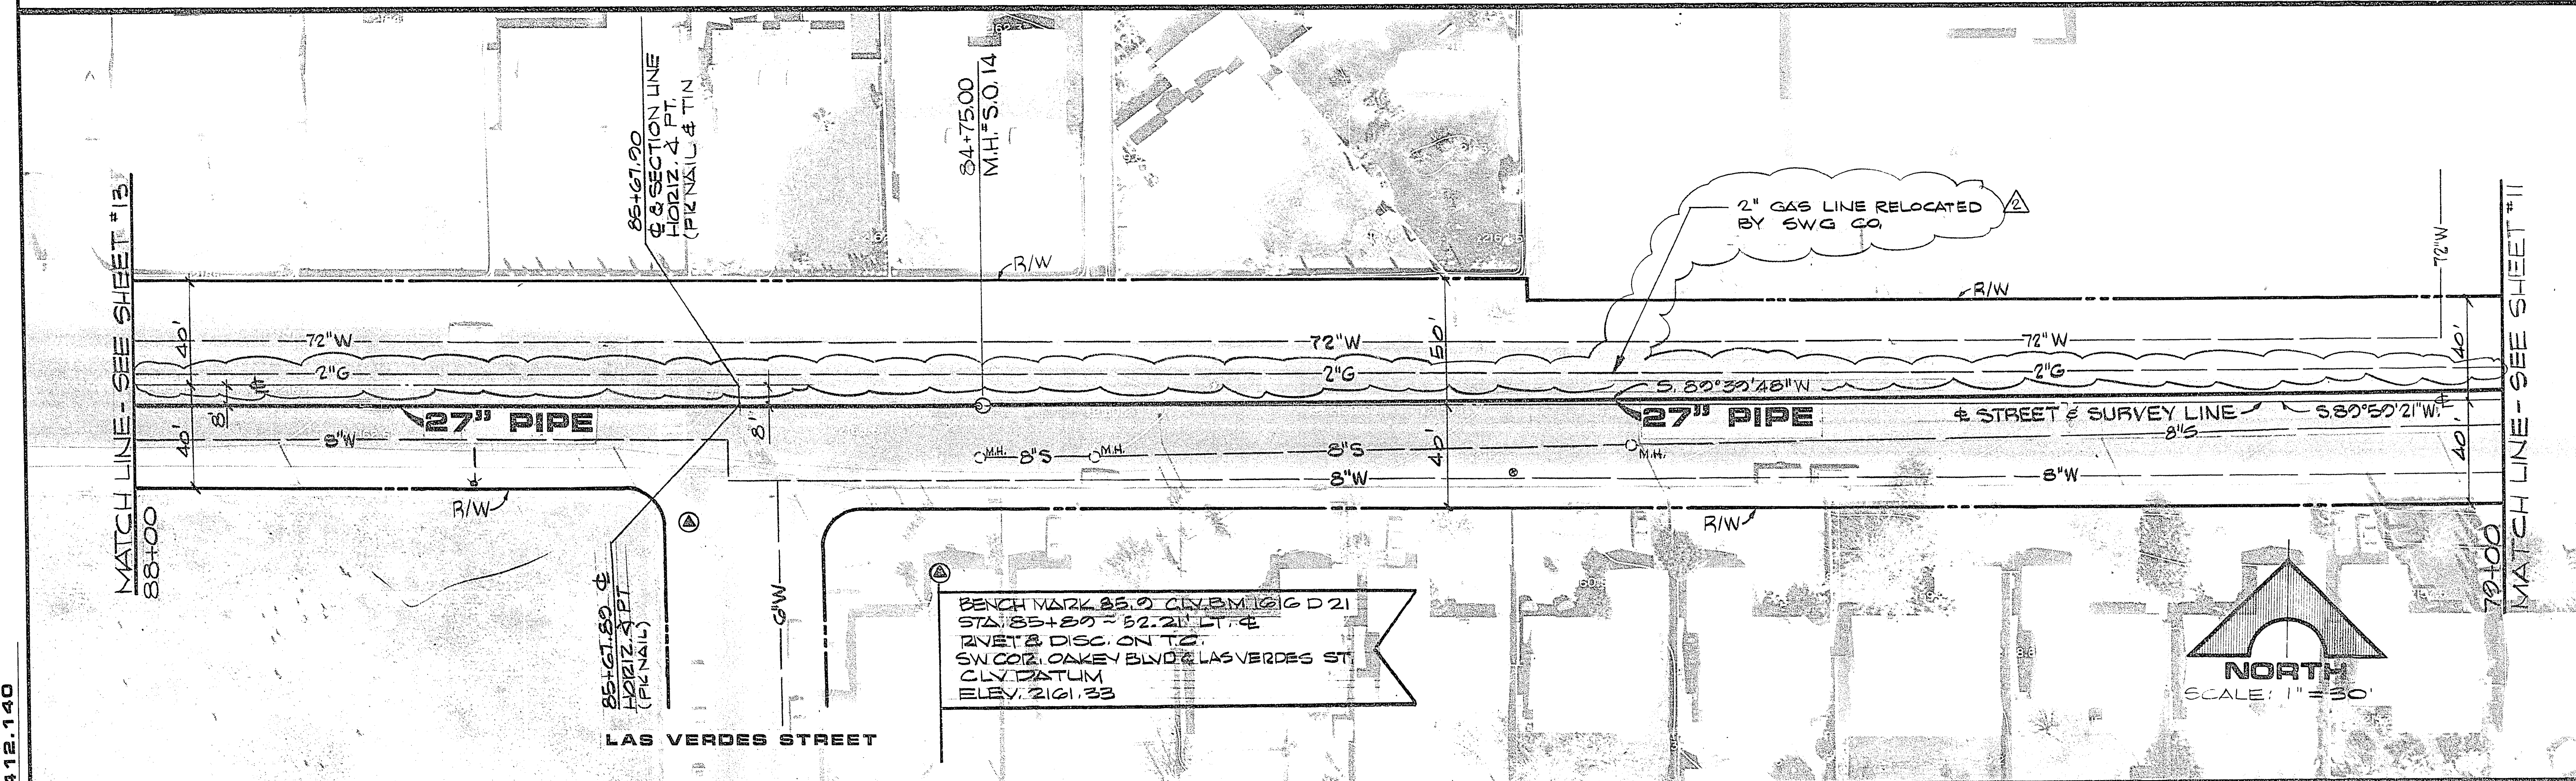


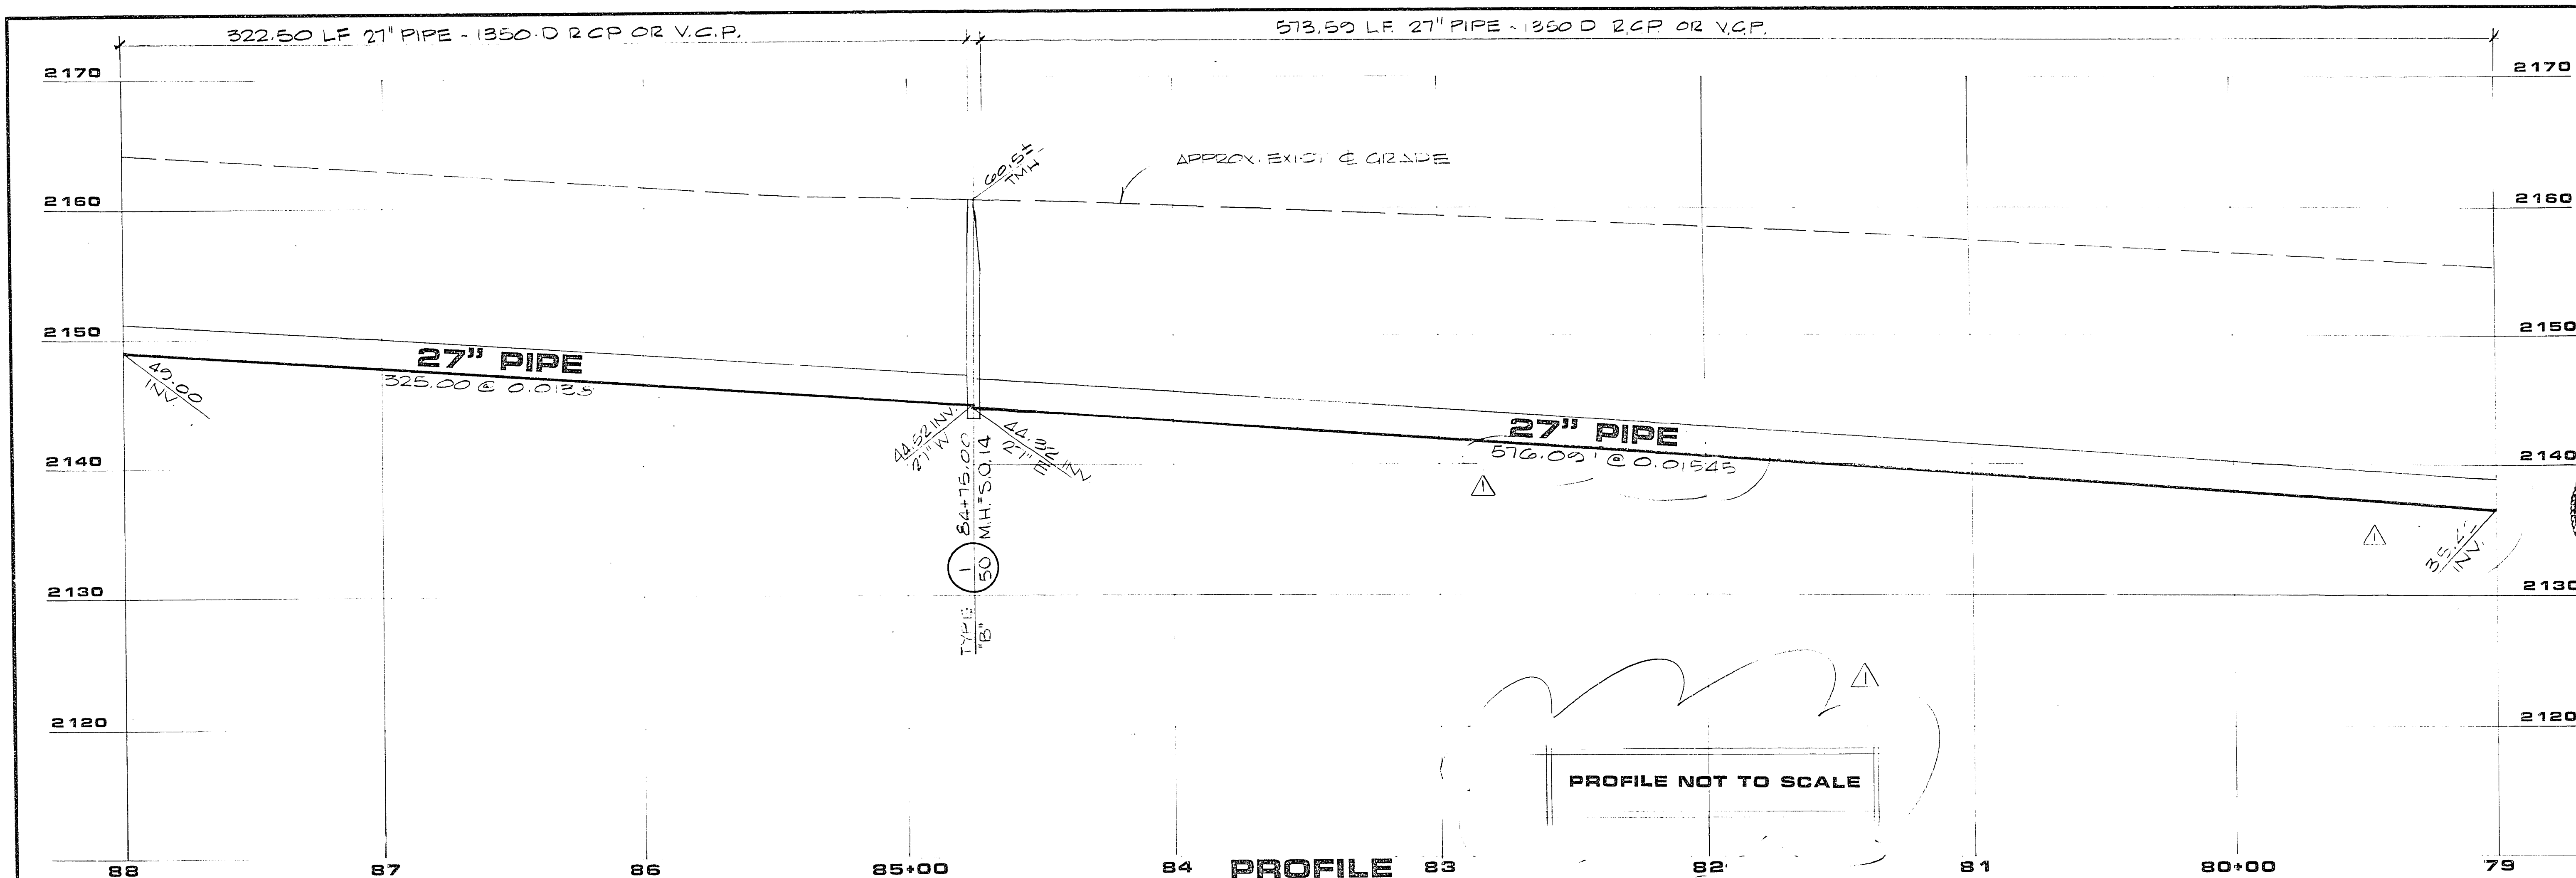

DESCRIPTION 76.54' DUE TO 22' 6" x 22' PIPELINE 1/19/88 "AS BUILT"	
DATE 7/2/83	REV. 1
RE. NO. DATE	
G. C. WALLACE Consulting Engineers, Inc. 1100 East Sahara Ave. • Las Vegas, Nevada 89104 • 732-3330	
Department of Public Services SAHARA - OAKY SEWER INTERCEPTOR	
PLAN & PROFILE 79+00 TO 88+00	
SHEET 12 OF 65 SHEETS	