



JOB NO. 412.140

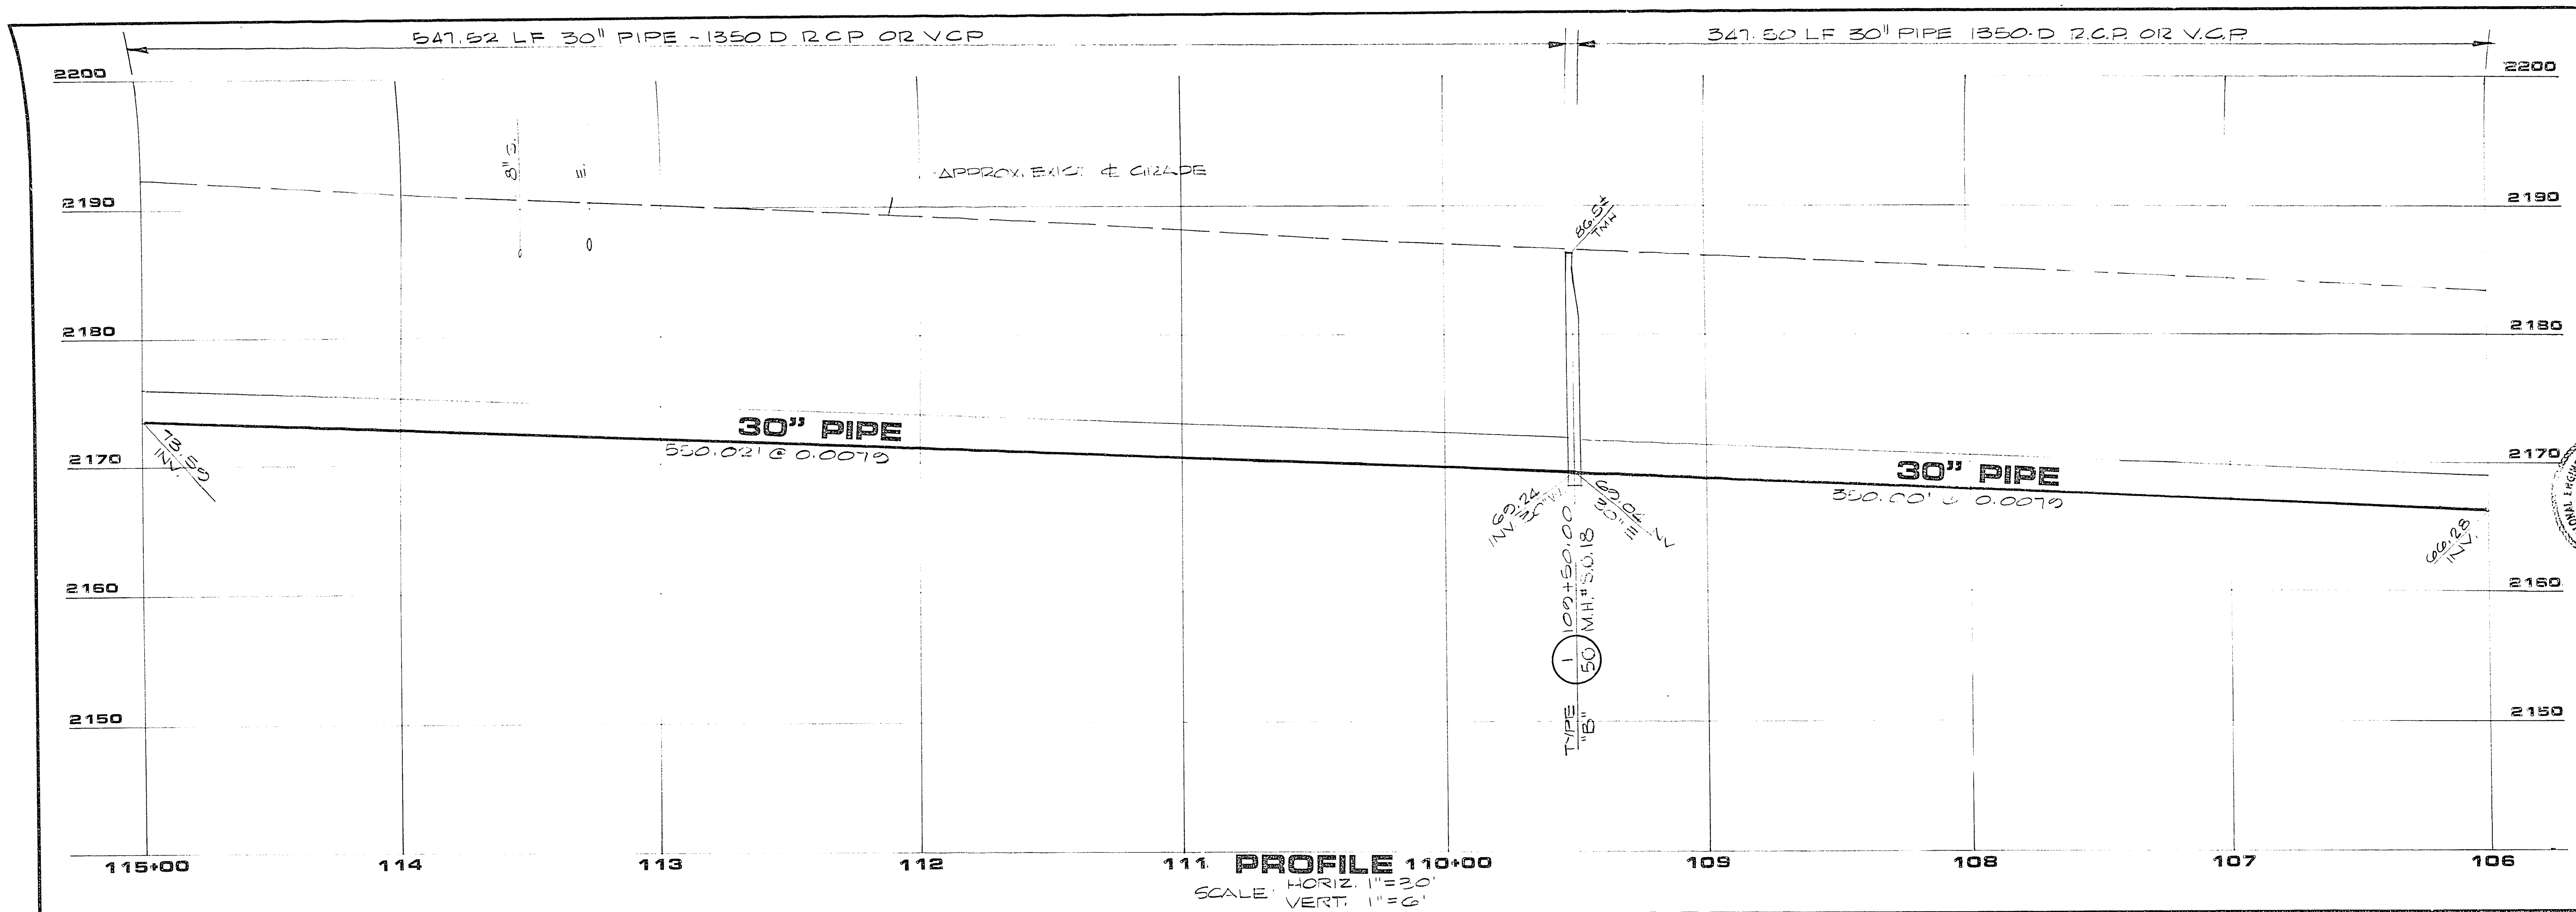

BENCH MARK 112.5
STA 112+45 ~ 34' B.T. &
BRASS DISC. ON T.C.
NE OF OAKLEY BLD. & CAMERON ST.
CLY DATUM
ELEV. 2189.62

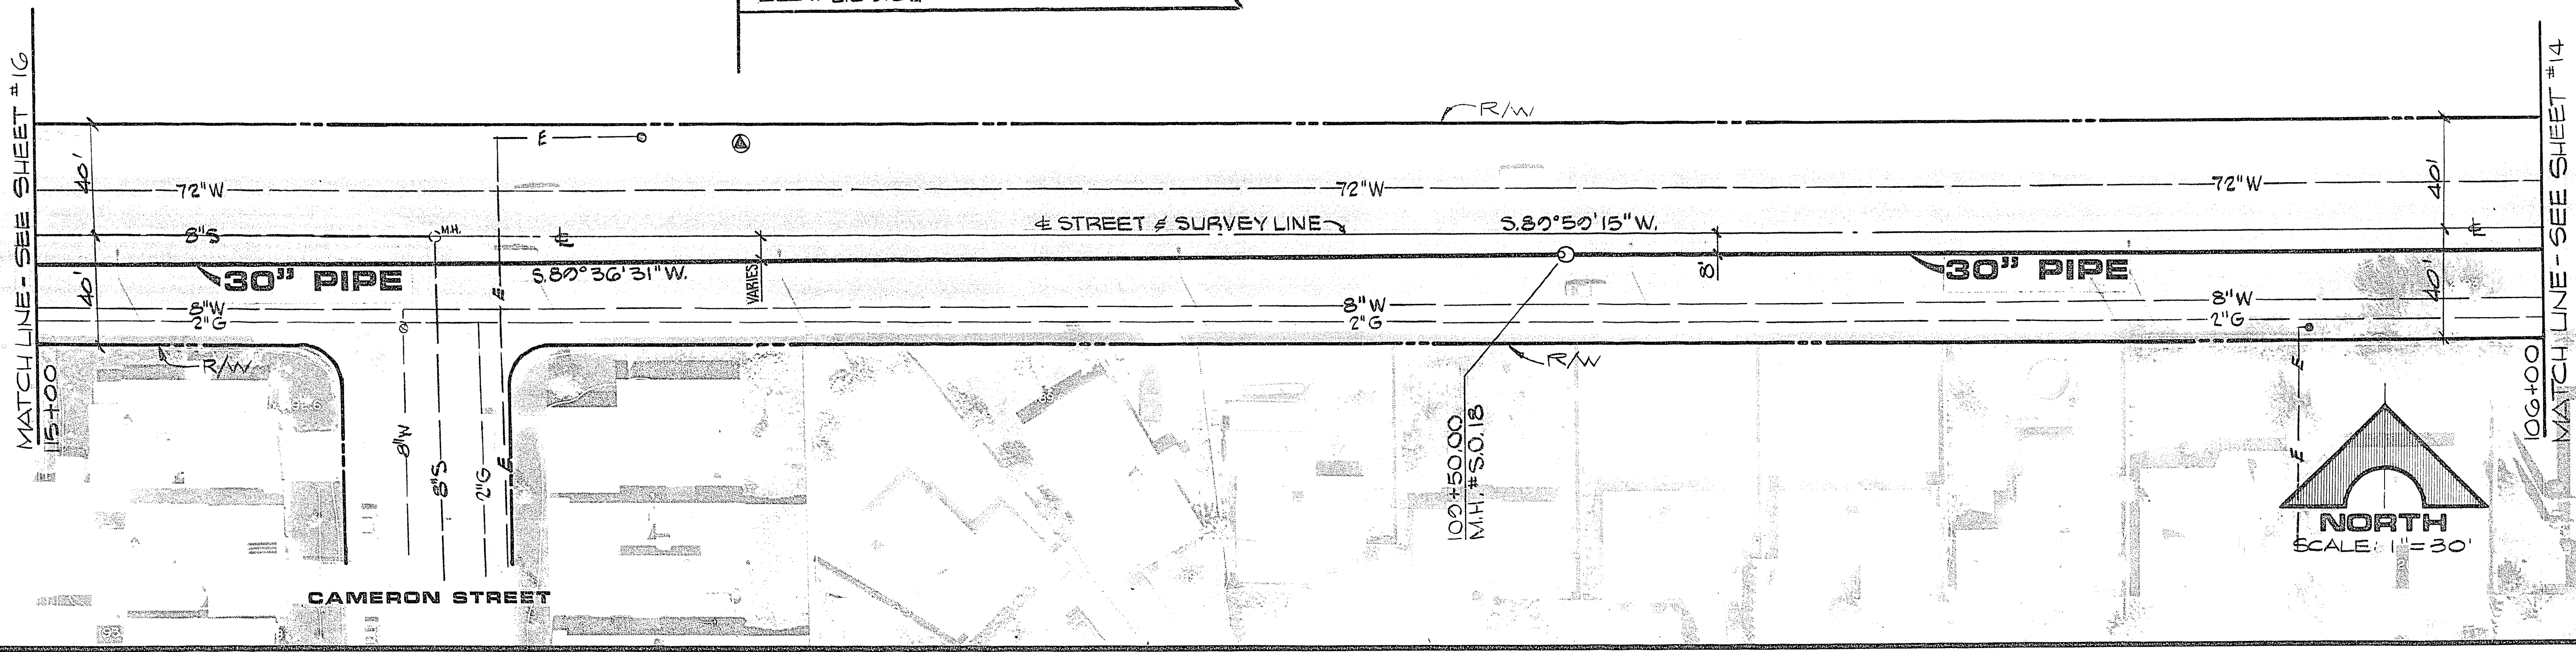

OAKLEY

BOULEVARD

AS BUILT DRAWING

307-V 563

DESCRIPTION	
DATE	11/10/88
REV	1/20/93
R.E. NO.	DATE
G.C. WALLACE Consulting Engineers, Inc. 1100 East Sahara Ave. • Las Vegas, Nevada 89104 • 732-3330	
Department of Public Services SAHARA - OAKLEY SEWER INTERCEPTOR	
PLAN & PROFILE 106+00 TO 115+00	
SHEET 15 OF 65 SHEETS	